

PERMIT NUMBER: B 20000865

DATE ACCEPTED:



RESIDENTIAL BUILDING PERMIT APPLICATION

HOWARD COUNTY DEPARTMENT OF INSPECTIONS, LICENSES, AND PERMITS

3430 COURT HOUSE DRIVE, ELLICOTT CITY, MD. 21043 - PHONE: (410) 313-2455 OPTION #4

www.howardcountymd.gov

BUILDING SITE ADDRESS REQUIRED

Street Address: 3534 Foxgaw Tol Unit:
City: Woodbine State: MD Zip Code: 21797
Subdivision/Village/Complex Name: Foxgaw Plantation SDP/WP/BA #:
Lot: 14 Tax Map: 14 Parcel: 233 Grading Permit #:

DESCRIPTION OF WORK REQUIRED

Existing Use: SF Dwelling Proposed Use: SF Dwelling Estimated Cost: \$ 40,000.00
Trade Work to Be Completed (Separate Permits Required): [X] Mechanical (HVACR) [] Electrical [X] Plumbing [] None
*Remodel kitchen with all bathroom... change master bath layout... add 4 new light... remove HVAC... close off down from laundry room... change window size by 1/2"

PROPERTY OWNER INFORMATION REQUIRED

Owner(s) Name(s) (As it appears on tax records): Katie Kim (purchased 3/14/2020) Primary Residence: [] Yes [X] No
Owner's Street Address: 320 Reservation Ct
City: Fithen State: MD Zip Code: 20754
Phone: 443-207-3438 Email: katie.veally1@gmail.com

APPLICANT NAME REQUIRED - INDIVIDUAL WHO SIGNS THIS APPLICATION

Business Name: Katie Kim Luxe Homes MD Contact Name: Katie Kim
Street Address: 320 Reservation Ct
City: Fithen State: MD Zip Code: 20754
Phone: 443-207-3438 Email: katie.veally1@gmail.com

CONTRACTOR INFORMATION REQUIRED

Business Name: LuxehomeMD
Licensee's Name: Katie Kim License #: 114483
Street Address: 320 Reservation Ct
City: Fithen State: MD Zip Code: 20754
Phone: 443-207-3438 Email: katie.veally1@gmail.com

ARCHITECT/ENGINEER INFORMATION INDIVIDUAL WHO SIGNED PLANS, IF APPLICABLE

Business Name: Name:
Street Address: APX: 235 SF
City: State: Zip Code:
Phone: Email:

BUILDING CHARACTERISTICS REQUIRED

Primary Structure: [X] SF Dwelling [] SF Townhouse [] SF Duplex [] Mobile Home [] Multi-Family Dwelling (MF*) Condo: [] Yes [X] No
Utilities: [X] Electric [] Gas Water Supply: [] Public [X] Private (Well) Sewage Disposal: [] Public [X] Private (Septic)
Heating System: [X] Electric [] Natural Gas [] Propane [] Other: Roadside Tree Project: [] No [X] Yes: #
Sprinkler System: [] NFPA 13 [] NFPA 13R [] NFPA 13D [X] None Fire Alarm System: [] Yes [X] No [] Voice Evac

ADDITIONAL RESIDENTIAL INFORMATION (PLEASE SELECT/COMPLETE ALL THAT APPLY)

Model Name & Options:
of Bedrooms (SF): 5 # of efficiency units (MF*): # of 1 BR (MF*): # of 2 BR (MF*): # of 3 BR (MF*):
Rooms: # Full Baths: 3 # Half Baths: 1 # Fireplaces: 2
Garage/Carport Info: [X] Attached Garage [] Detached Garage [] Integral Garage [] Carport [] None
Basement/Foundation Info: [] Slab on Grade [] Post & Pier [] Unfinished Basement [X] Finished Basement: [] Full or [] Partial
1st Fl Width: 1st Fl Depth: 2nd Fl Width: 2nd Fl Depth: Bsmt Width: Bsmt Depth:
Energy Method: [] Prescriptive [] Performance [] UA Alternative [] ERI Gross Area: 658 sq ft Occupiable Area: 8023 sq

AGREEMENT/ DISCALIMER REQUIRED

THE UNDERSIGNED HEREBY CERTIFIES AND AGREES AS FOLLOWS: (1) THAT HE/SHE IS AUTHORIZED TO MAKE THIS APPLICATION; (2) THAT THE INFORMATION IS CORRECT; (3) THAT HE/SHE WILL COM WITH ALL REGULATIONS OF HOWARD COUNTY WHICH ARE APPLICABLE THERETO; (4) THAT HE/SHE WILL PERFORM NO WORK ON THE ABOVE REFERENCED PROPERTY NOT SPECIFICALLY DESCRIBED THIS APPLICATION; (5) THAT HE/SHE GRANTS COUNTY OFFICIALS THE RIGHT TO ENTER ONTO THIS PROPERTY FOR THE PURPOSE OF INSPECTING THE WORK PERMITTED AND POSTING NOTICES.

APPLICANT'S ORIGINAL SIGNATURE: [Signature] DATE SIGNED: 3/12/2020

FOR OFFICE USE ONLY


CHECKS PAYABLE TO: DIRECTOR OF FINANCE OF HOWARD COUNTY

AGENCIES REQUIRED/APPROVALS:

[] PR [] DPZ [] DED [] Health [Signature] [] SHA [] CID
SUBMITTAL FEES: \$135.00 PAYMENT: [Signature] ACCEPTED BY: [Signature]

B20000865

currently, windows go all the way to the floor. Replacement windows will be 30" from floor

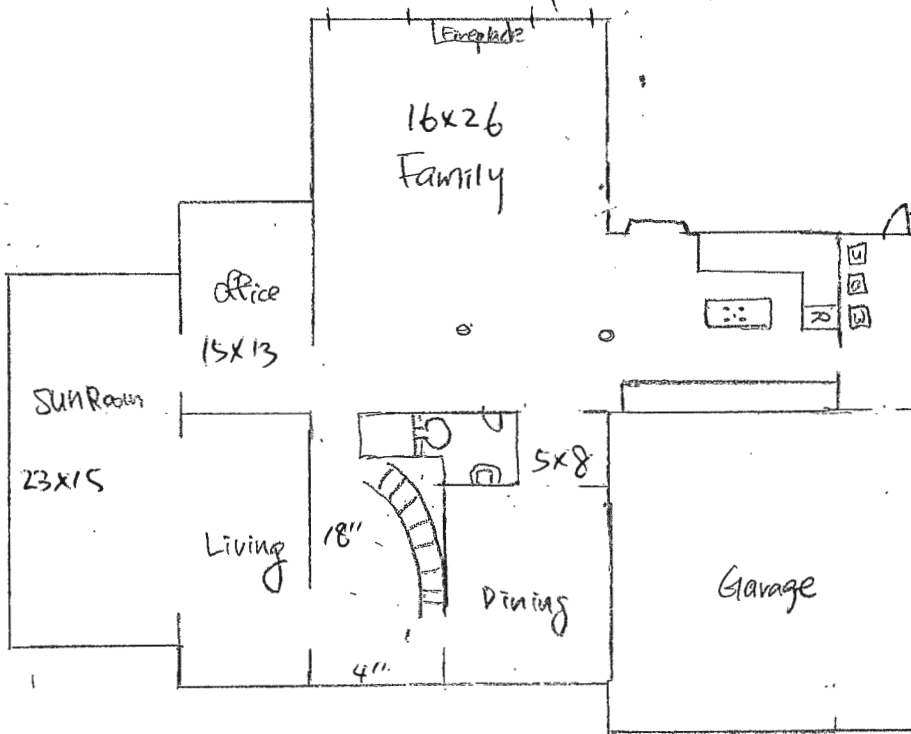


New siding
Door to be closed off

- Relocate electric cooktop from kitchen island to wall.
- Relocate refrigerator to wall against garage.

Master Bathroom

Before

After

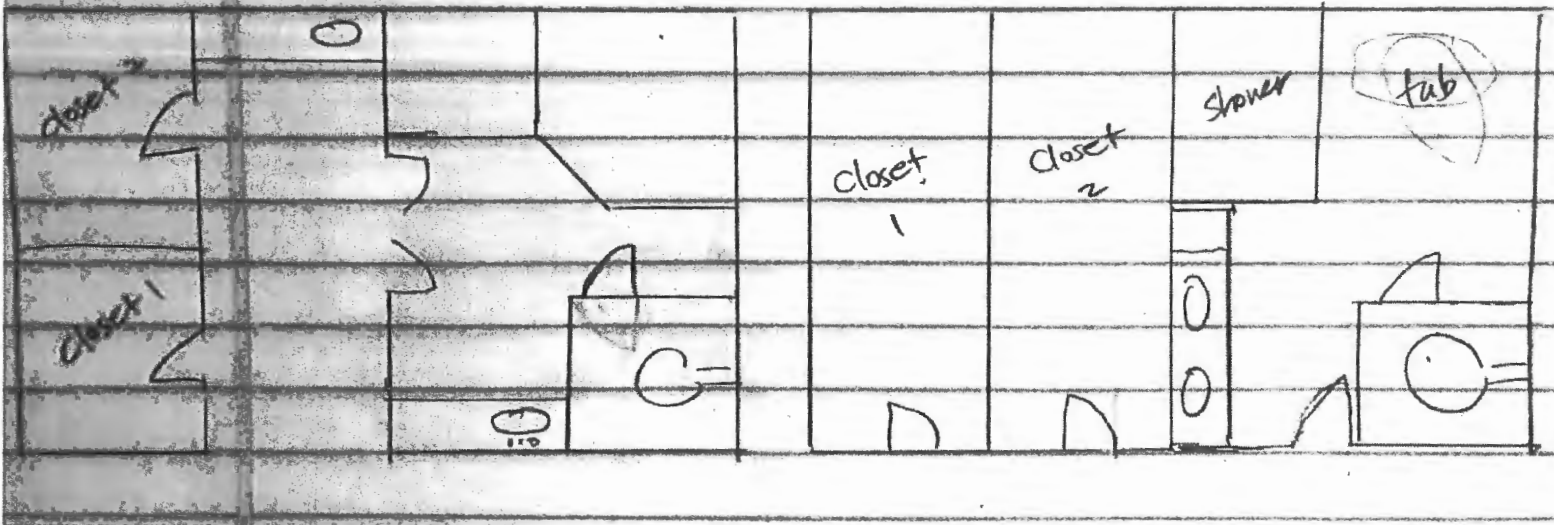

- Master Bathroom → change layout
- powder room → change fixtures
- Hallway Bathroom → change fixtures
- Basement Bathroom → change fixtures

- Kitchen → - change fixtures
 - relocate electric cooktop
 - relocate refrigerator
- Replace lighting fixtures, receptacles, switches
- Replace HVAC