

Approved 10/6/20
-H.O.

Menu Save Reset Cancel Help

Record Detail * (This section is required.)

Permit Type	Permit Number	Opened Date
Building/Residential/Misc/Pool Spa	B20003260	09/25/2020
Description of Work		
SFD/ CONSTRUCT 16' X 36' INGROUND SWIMMING POOL, 3' 6" - 6' DEEP, WITH FENCE TO CODE		

[check spelling](#)

Address * (This section is required.)

Search Reset Clear Get Parcel & Owner

Street #	Street Name	Street Type	
14534	OLD FREDERICK	RD	
Unit Type	Unit #	X Coordinate	Y Coordinate
--Select--		-77.01651	39.33774
City	State	Zip Code	Primary
COOKSVILLE	MD	21723	Yes

Parcel * (This section is required.)

Search Reset Clear Get Address & Owner

GIS ID *	Parcel	Parcel Area	Land Value	Improved Value	Exemption Value	Plan Area
1102529	401	1.15	186400	1025600	839200	RURAL
Legal Description						
IMPVLOT 4 1.1478 A.[]14534 OLD FREDERICK RD[]QUARTZ HILL III						

[check spelling](#)

Block	Lot	Census Tract	Council Dist	Inspection Dist	Supervisor Dist	Map #	DAP Zone
	4	604001	5				
Plan Area	State Tax Id		Subdivision Name				
	1404596403		Quartz Hill III				
Section	Area		Tax Map				
			8				
Grid	Zoning District		ADC Map				
8-11	RC-DEO		4692-H6				
SDP No.	Final Plan No.		WP File No.		Primary		
	ECP-12-066				Yes		
Record Plat No.	WS Contract No.		FDP No.				
22813-2281							
Owner Occupied	Year Built		Historic District				
<input type="radio"/> Yes <input type="radio"/> No	2018		<input type="radio"/> Yes <input checked="" type="radio"/> No				
Historic District Registry No.	Stat Area		Flood Plain				
	4-02		<input type="radio"/> Yes <input checked="" type="radio"/> No				

Building No

Owner * (This section is required.)

Search Reset Clear

Name *

Address Line 1

Address Line 2

Address Line 3

Mail City	Mail State	Mail Zip Code
COOKESVILLE	MD <input type="checkbox"/>	21723

Phone	Primary
412-953-2452	Yes <input type="checkbox"/>

E-mail

Cell Number	Fax Number
<input type="text"/>	<input type="text"/>

Professionals (This section is not required.)

Search Reset Clear

License # *	Business Name		
08010025223	GALLOWAY POOL SERVICES INC		
License Type *	First Name	Middle Name	Last Name
MHIC Ind <input type="checkbox"/>	STEVEN	T	GALLOWAY
Primary	Address Line 1		
Yes <input type="checkbox"/>	11710 OLD FREDERICK ROAD		
Address Line 2			
<input type="text"/>			
City	State	ZIP Code	
MARRIOTSVILLE	MD	21104-0000	
Phone 1	Phone 2	Fax	
4104425005		4104425005	
E-mail			
INFO@GALLOWAYPOOLSERVICE.COM			

Applicant (This section is not required.)

Search As Owner As Lic. Prof As Contact

Type *	First Name	MI	Last Name
Applicant <input type="checkbox"/>	STEVEN	T	GALLOWAY
Relationship	Full Name		
Applicant <input type="checkbox"/>	STEVEN T GALLOWAY		
Primary	Organization Name		
Yes <input type="checkbox"/>	GALLOWAY POOL SERVICES INC		
Street Address			
11710 OLD FREDERICK ROAD			
Address Line 2			
<input type="text"/>			

City	State	Zip Code
MARRIOTSVILLE	MD	21104-0000
Phone	Cell	Fax
4104425005		4104425005
E-mail *		
INFO@GALLOWAYPOOLSERVICE.COM		

Addtl Info

Est Construction Cost *	Housing Units *	Number of Buildings *	Public Owned
71000	0	0	No
Construction Type			
329 - Structures Other Than Buildings (Retaining Walls/Tents)			

POOL INFORMATION

MISCELLANEOUS POOL INFORMATION

Capital Project-No Fee *	Capital Project Number	Fee Exempt *	Water Supply *	Sewage Disposal *
<input type="radio"/> Yes <input checked="" type="radio"/> No		<input type="radio"/> Yes <input checked="" type="radio"/> No	Private	Private
Existing Use	Type of Pool or Spa *	Electrical Permit Number	Expiration Date	
SFD	In Ground Pool	E20004349	4/3/2021	

PAYMENT INFORMATION

Check 1	Payee 1	SAP Doc No	SAP Entered

Related Records

« 1 »

<u>Permit Number</u>	<u>Record Type Alias</u>	<u>Status</u>	<u>Number</u>	<u>Street Name</u>	<u>Opened Date</u>	<u>Des</u>
B20003260	Residential Pool or Spa Permit	Review In Process	14534	OLD FREDERICK	09/25/2020	SFI
E20004349	Residential Electrical Miscellaneous Permit	Issued	14534	OLD FREDERICK	09/30/2020	Bor

« 1 »

< _____ >

Submit **Cancel**

Oswald, Hank

From: Oswald, Hank
Sent: Monday, September 28, 2020 1:44 PM
To: Galloway Pool Service, Inc.
Subject: Re: B20003260_14534 Old Frederick Road
Attachments: WS_OldFrederickRoad_14534_SepticPermit-2017.pdf

Thank you. Please add in the septic tank location to the site plan per the As-built drawing (see page 2 of the attachment). You could also add in the location of the pool equipment and excavated dirt pile to be removed from site. You will need to submit the revision to the permits office. Let me know when you do, so I can look for it in the system.

Thanks,

Hank

From: Galloway Pool Service, Inc. <beth@gallowaypoolservice.com>
Sent: Monday, September 28, 2020 1:13 PM
To: Oswald, Hank <hoswald@howardcountymd.gov>
Subject: Re: B20003260_14534 Old Frederick Road

[Note: This email originated from outside of the organization. Please only click on links or attachments if you know the sender.]

Hello Mr. Oswald.
Here you go.
Thanks
Beth Galloway

On Mon, Sep 28, 2020 at 12:41 PM Oswald, Hank <hoswald@howardcountymd.gov> wrote:
Hello Mr. Galloway:

Please forward an e-copy of the building permit site plan for BP# B20003260 (14534 Old Frederick Road).


Thanks,

Hank


Hank Oswald
Howard County Health Department
Well and Septic Program

NOTES:

- 1) THIS DRAWING IS OF BENEFIT TO A CONSUMER ONLY INsofar AS IT IS REQUIRED BY A LENDER OR A TITLE INSURANCE COMPANY OR ITS AGENT IN CONNECTION WITH CONTEMPLATED TRANSFER, FINANCING OR REFINANCING.
- 2) THIS DRAWING IS NOT TO BE RELIED UPON FOR THE ESTABLISHMENT OR LOCATION OF FENCES, GARAGES, BUILDINGS OR OTHER EXISTING OR FUTURE IMPROVEMENTS.
- 3) THIS DRAWING DOES NOT PROVIDE FOR ACCURATE IDENTIFICATION OF PROPERTY BOUNDARY LINES, BUT SUCH IDENTIFICATION MAY NOT BE REQUIRED FOR THE TRANSFER OF TITLE OR SECURING FINANCING OR REFINANCING.
- 4) THIS PROPERTY IS NOT LOCATED WITHIN A SPECIAL FLOOD HAZARD AREA AS PLOTTED BY SCALE ON NATIONAL FLOOD INSURANCE PROGRAM, FLOOD INSURANCE RATE MAP, COMMUNITY PANEL NUMBER 24027CO035D, DATED NOVEMBER 6, 2013.
- 5) BUILDING TIES ARE ±0.5' UNLESS OTHERWISE NOTED.

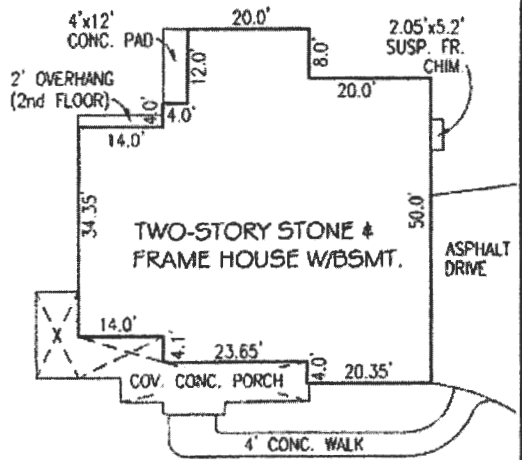

HOUSE DETAIL
SCALE: 1" = 30'

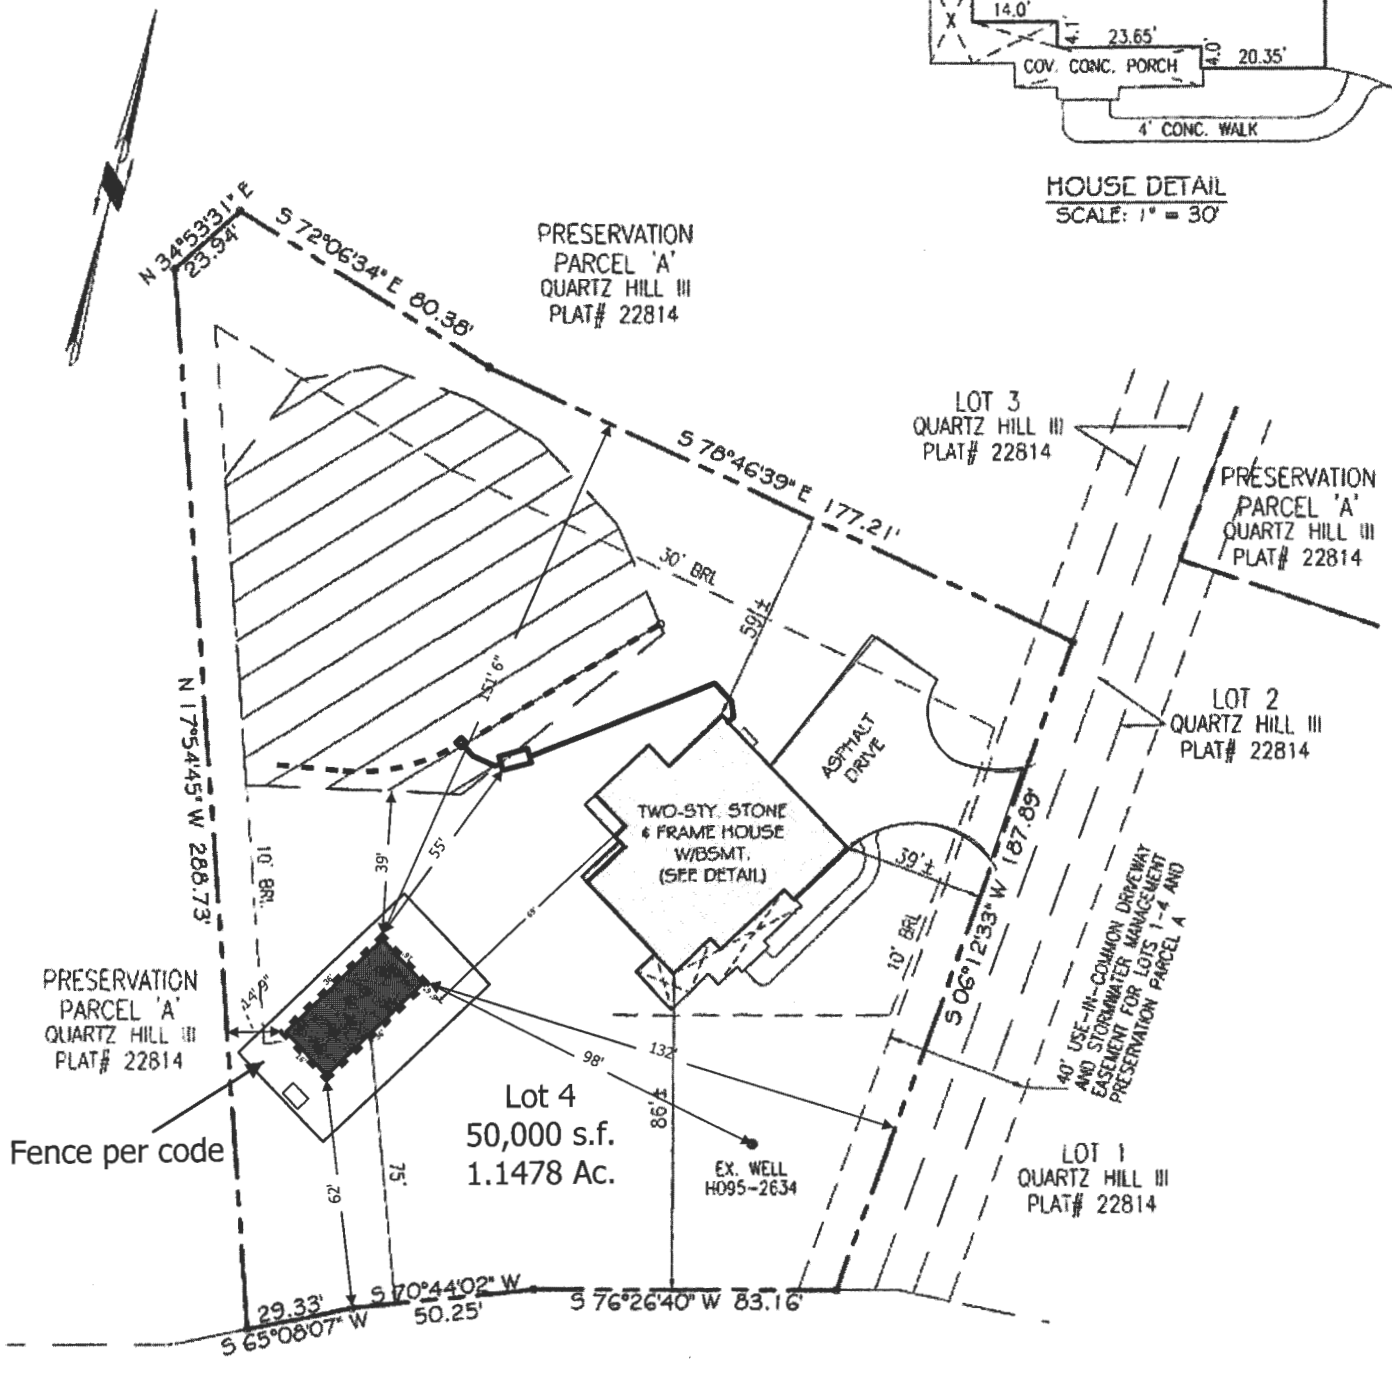

OLD FREDERICK ROAD
MD SHA PLAT 56161

PROFESSIONAL CERTIFICATION:

I HEREBY CERTIFY THAT THESE DOCUMENTS WERE PREPARED BY ME OR UNDER MY RESPONSIBLE CHARGE, AND THAT I AM A DULY LICENSED PROFESSIONAL LAND SURVEYOR UNDER THE LAWS OF THE STATE OF MARYLAND, LICENSE NO. 21512, EXPIRATION DATE AUGUST 4, 2019 IN ACCORDANCE WITH COMAR 09.13.06.12

Jeffery W. Elkins July 3, 2018
Date
For VanMar Associates, Inc.
Jeffery W. Elkins, Prof. Land Surveyor



HOUSE LOCATION DRAWING
LOT 4
QUARTZ HILL
PLAT No. 22814
14534 OLD FREDERICK ROAD
FOURTH ELECTION DISTRICT
HOWARD COUNTY, MARYLAND
SCALE: 1" = 50' JULY, 2018

I CERTIFY THIS PLAT TO BE CORRECT; IT IS THE RESULT OF AN ACTUAL FIELD SURVEY, BASED ON DATA FOUND AMONG THE LAND RECORDS OF HOWARD COUNTY, MARYLAND, AS REFERENCED HEREON.

REFERENCE	JOB NO.
PLAT NO. 22814	56-5595



VANMAR ASSOCIATES, INC.
Engineers Surveyors Planners
310 South Main Street Mount Airy, Maryland 21771
(301) 829-2890 (301) 831-5015 (410) 549-2751
©Copyright, Latest Date Shown