


Showing 1 of 1

<input type="checkbox"/> Permit #	Status	Record Type Alias	Street #	Street Name	Type	Unit Type	Unit #	City	Description	Opened
<input type="checkbox"/> B21003067	Review In Process	Residential Open or Screened Porch Permit	1009	HIGH STEPPER	TRL			SYKESVILLE	SFD/ CONSTRUCT 19' x 14' screened ...	08/17/2021

N/F JEFFREY S. QUILLEN &
LINDA M. WILLIS
8115/266

24' PRIVATE
USE-IN-COM
EASEMENT F

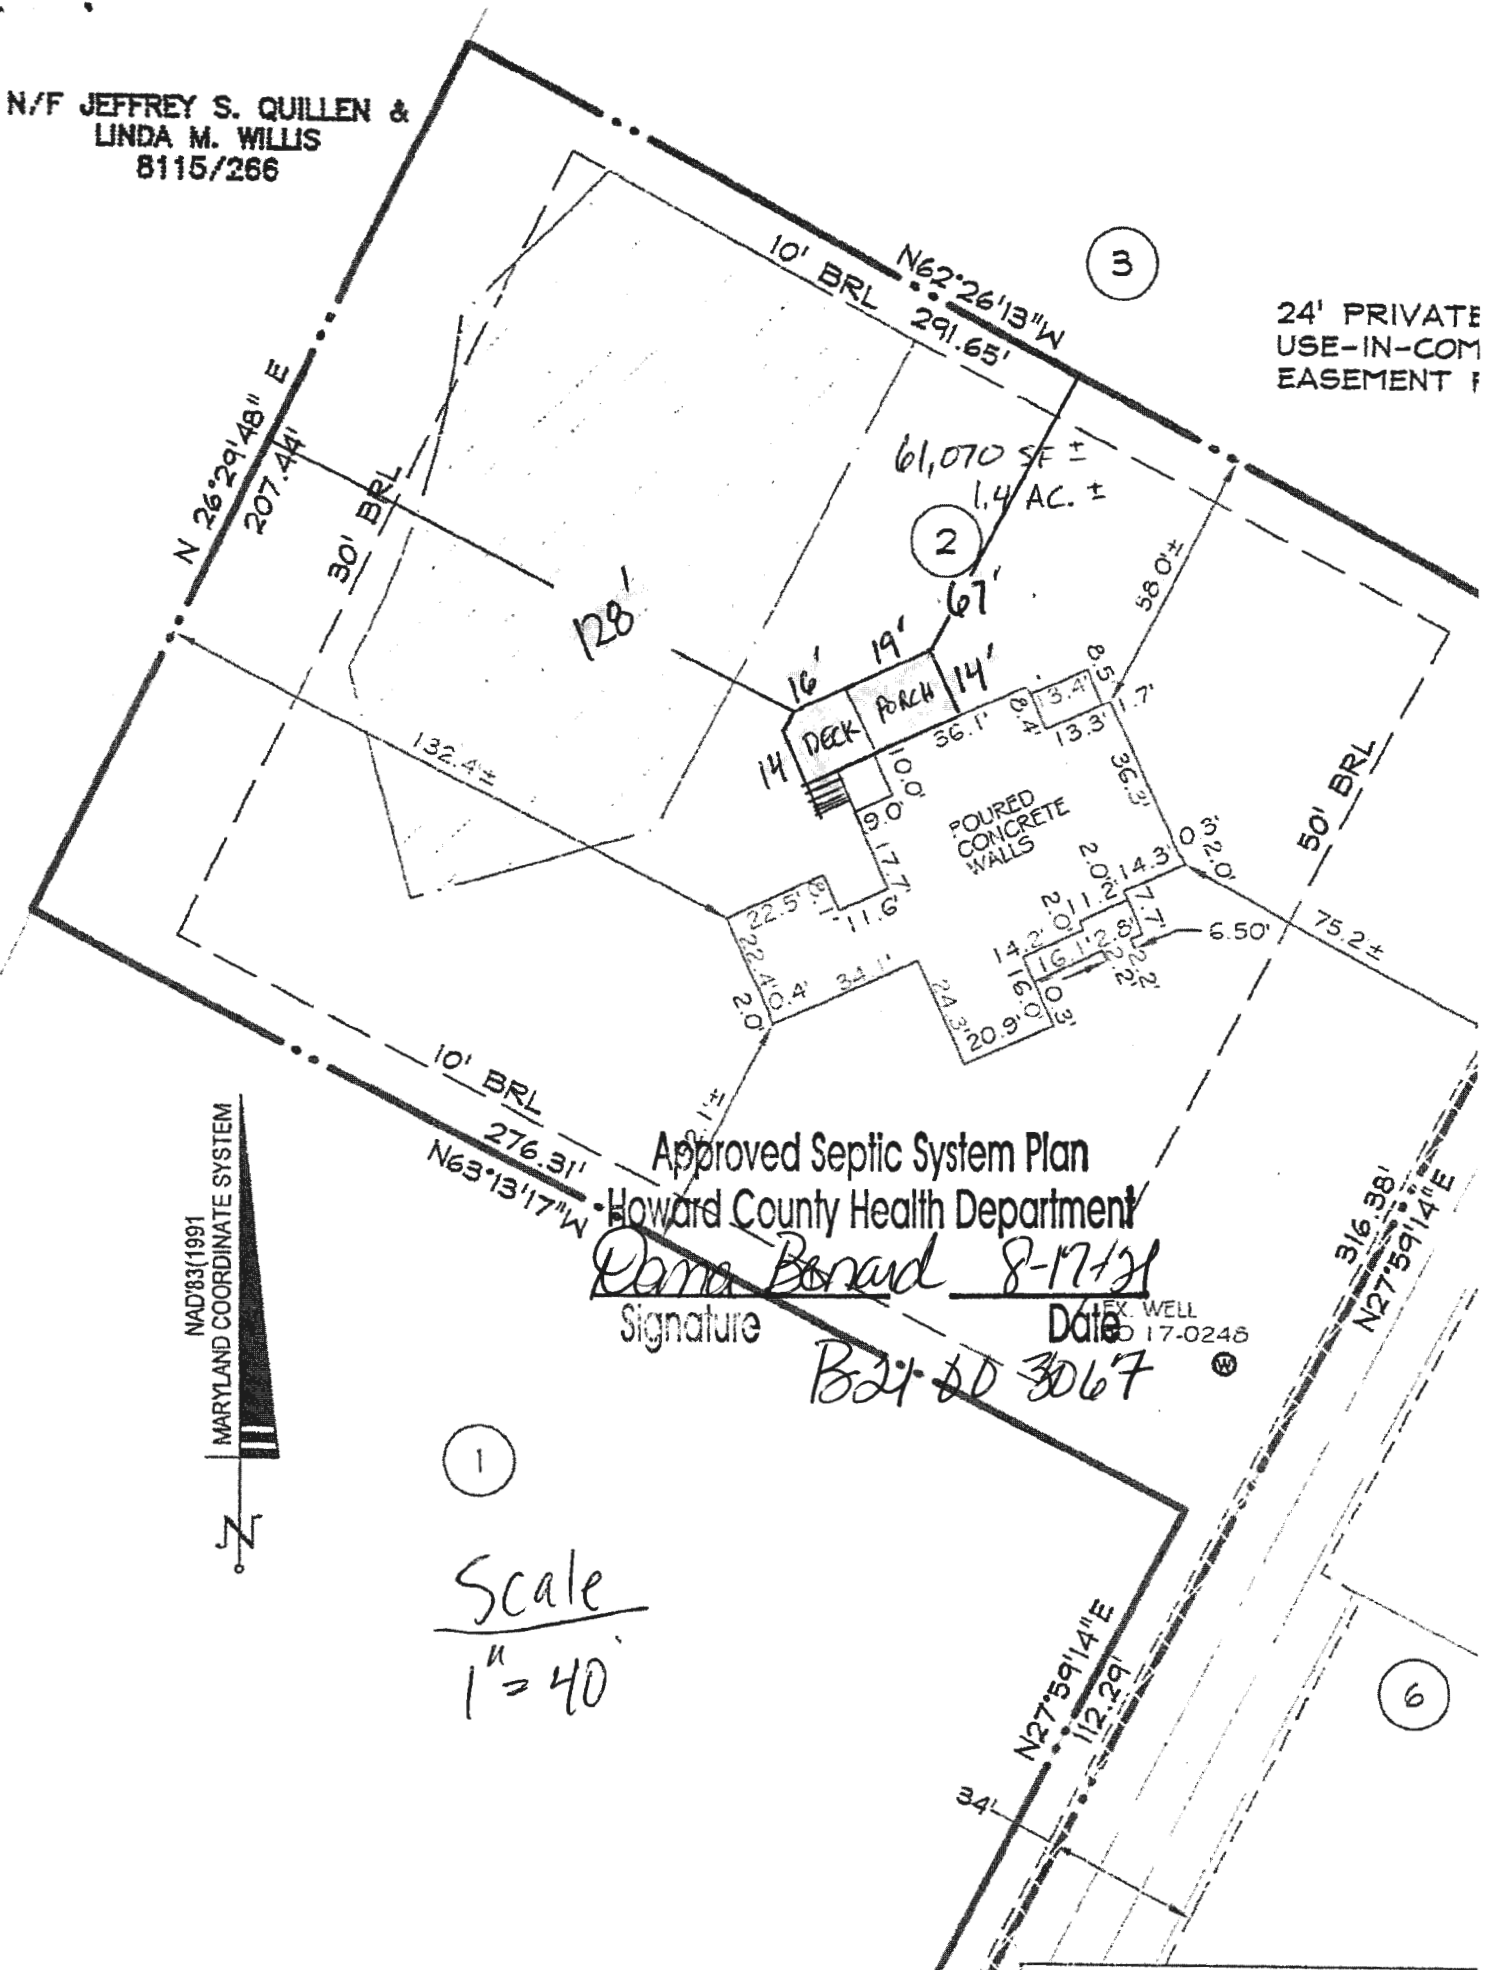

Approved Septic System Plan
Howard County Health Department

Dana Bernard 8-17-21
Signature Date

B24-20 3067



①
Scale
1" = 40'

⑥