

A/P


#25  
 Red Brown  
 SCL  
 5-10% R4  
 Red Brown  
 yellow  
 Sh magnesian  
 4 deposits  
 Red Brown  
 yellow  
 many  
 mica  
 Sh  
 5-10% silt  
 14.5

#24  
 Red Brown  
 SCL  
 5-10%  
 R4 5.5

Red Brown  
 yellow  
 shale  
 30-40%  
 Refused  
 @ 10'  
 10'

#26  
 Red Brown  
 yellow  
 SCL  
 6.5

Red yellow  
 Brown  
 many  
 mica  
 Sh  
 silt @ 11'  
 14'

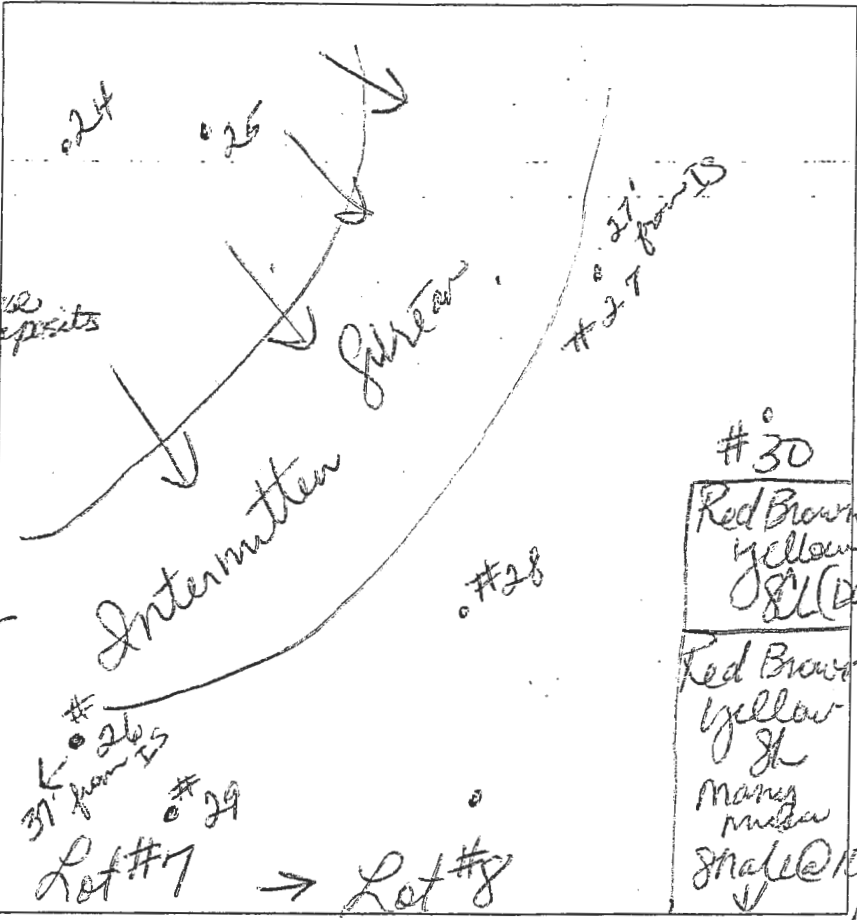

#30  
 Red Brown  
 yellow  
 SCL (dense)  
 3'  
 Red Brown  
 yellow  
 Sh  
 many  
 mica  
 shale @ 10'  
 14'

Red Brown  
 SCL (dense)  
 5'

Red Brown  
 Sh yellow  
 5-10%  
 R4  
 H2O in  
 the bottom  
 @ 13' 14'

#28  
 Red Brown  
 SCL  
 5-10%  
 R4 5.5

Red Brown  
 yellow  
 Sh

Red Brown  
 yellow  
 SCL 15'

(Revisit) #27

37'  
 Red Brown  
 from  
 yellow  
 Intermittent  
 stream  
 SCL  
 5-10%  
 R4

27'  
 Red Brown  
 yellow  
 SCL  
 ↓  
 14'

DATE	TEST #	DEPTH	START	BREAK 1" DROP	STOP 2" DROP	TIME OF 2ND INCH	P/F/H
6-25-14	25	5.5/14.5	10:20	10:23	10:26	3 min	P
6-25-14	24	6/10	3:31	3:33	3:35	2 min	P
6-25-14	26	7/4	10:35	10:41	10:53	9 min	P
6-25-14	29	5.5/14	10:37	10:41	10:45	4 min	P
6-25-14	28	6/15	10:49	10:53	11:01	6 min	P
6-25-14	27	5.5/14	10:58	11:10	11:32	22 min	P
6-25-14	30	5.5/14	11:21	11:23	11:24	1 min	P
	Pair		11:24	11:24	11:28	2 min	P

REMARKS \_\_\_\_\_

SANITARIAN Bernard BACKHOE \_\_\_\_\_ OTHERS \_\_\_\_\_

TEST HOLES USED IN SDA \_\_\_\_\_ AVG. PERC TIME \_\_\_\_\_ SQ. FT/BR \_\_\_\_\_

TRENCH WIDTH \_\_\_\_\_ INLET DEPTH \_\_\_\_\_ MAX. BOT DEPTH \_\_\_\_\_ EFFECTIVE SW \_\_\_\_\_


#25  
 Red Brown  
 SCL  
 5-10% R4  
 Red Brown  
 yellow  
 Sh magenta  
 4 deposits  
 Red Brown  
 yellow  
 many  
 mica  
 Sh  
 5-10%  
 14.5

#24  
 Red Brown  
 SCL  
 5-10%  
 R4 5.5

Red Brown  
 yellow  
 shale  
 30-40%  
 ↓  
 Refused  
 @ 10'  
 10'

#26  
 Red Brown  
 yellow  
 SCL  
 6.5

Red yellow  
 Brown  
 many  
 mica  
 Sh  
 Shist @ 11'  
 14'

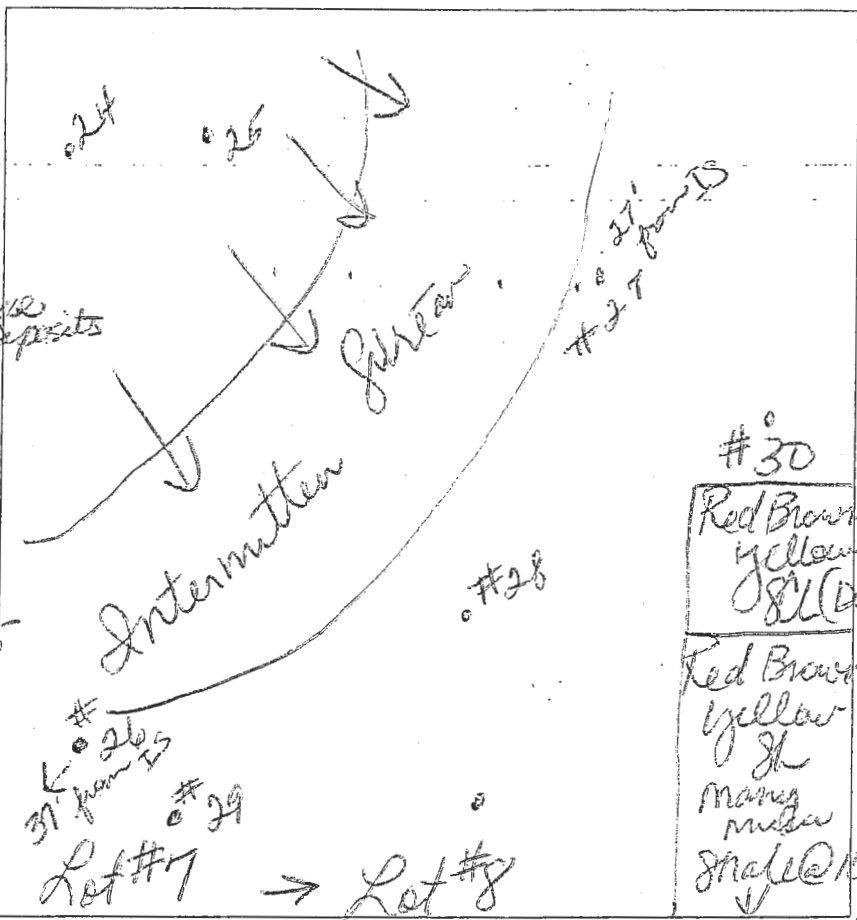

#30  
 Red Brown  
 yellow  
 SCL (dense)  
 3'  
 Red Brown  
 yellow  
 Sh  
 many  
 mica  
 shale @ 10'  
 ↓  
 14'

Red Brown  
 SCL (dense)  
 5'

Red Brown  
 Sh yellow  
 5-10%  
 R4  
 ↓  
 H2O in  
 the Bottom  
 @ 13. 14'

#28  
 Red Brown  
 SCL  
 5-10%  
 R4 5.5

Red Brown  
 yellow  
 Sh  
 10'  
 Red Brown  
 yellow  
 SCL  
 15'

DATE	TEST #	DEPTH	START	BREAK 1" DROP	STOP 2" DROP	TIME OF 2ND INCH	P/F/H
6-25-14	25	5.5/14.5	10:20	10:23	10:26	3 min	P
6-25-14	24	6/10	3:31	3:33	3:35	2 min	P
6-25-14	26	7/4	10:35	10:41	10:53	9 min	P
6-25-14	29	5.5/14	10:37	10:41	10:45	4 min	P
6-25-14	28	6/15	10:49	10:53	11:01	6 min	P
6-25-14	27	5.5/14	10:58	11:10	11:32	22 min	P
6-25-14	30	5.5/14	11:21	11:23	11:24	1 min	P
		Pair	11:24	11:34	11:28	2 min	P

(Revisit) #27  
 37' Red Brown  
 brown yellow  
 intermittent  
 stream  
 SCL  
 5-10%  
 R4 5.5  
 27'  
 Red Brown  
 yellow  
 Sh  
 ↓  
 14'

REMARKS \_\_\_\_\_  
 SANITARIAN Bevard BACKHOE \_\_\_\_\_ OTHERS \_\_\_\_\_  
 TEST HOLES USED IN SDA \_\_\_\_\_ AVG. PERC TIME \_\_\_\_\_ SQ. FT/BR \_\_\_\_\_  
 TRENCH WIDTH \_\_\_\_\_ INLET DEPTH \_\_\_\_\_ MAX. BOT DEPTH \_\_\_\_\_ EFFECTIVE SW \_\_\_\_\_