

RECEIVED

12/4/2020

PL/ N REV/ 01/ 11/ 15

To whom it may concern,

Revision to Add Deck


While applying for a deck permit (B20004082), I was ~~NOT~~ informed through the online portal that I would need to do a permit revision instead of applying for a brand new permit.

Assigned to **IBV**
 Marked as **Application Cancelled on 11/25/2020 by Lisa Logan-Roussel!**
Comment: This needs to be submitted as a revision to the existing building permit. Please submit in hard copy a letter explaining the changes, plot plan showing the proposed structure, dimensions and distances to property lines shown, and 25.00 amend ment fee. contact Canest@howardcountymd.gov (Cathy) regarding refund requests.

This letter is to certify that I want a revision done to the existing building permit (B20001853) that I have for the following address:

14085 Clarksville Pike, Highland MD 20777


Thanks,

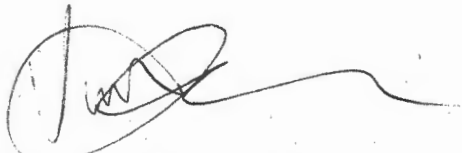


Victor Cabido

cc: P+Z
Heath

APPROVED
 WALKTHRU BUILDING PERMIT
 BP# 2000 B33 Revision
 APP. SAN Bldg. DATE: 12/22/2020
 DESC. OF WORK: New decks
 as illustrated

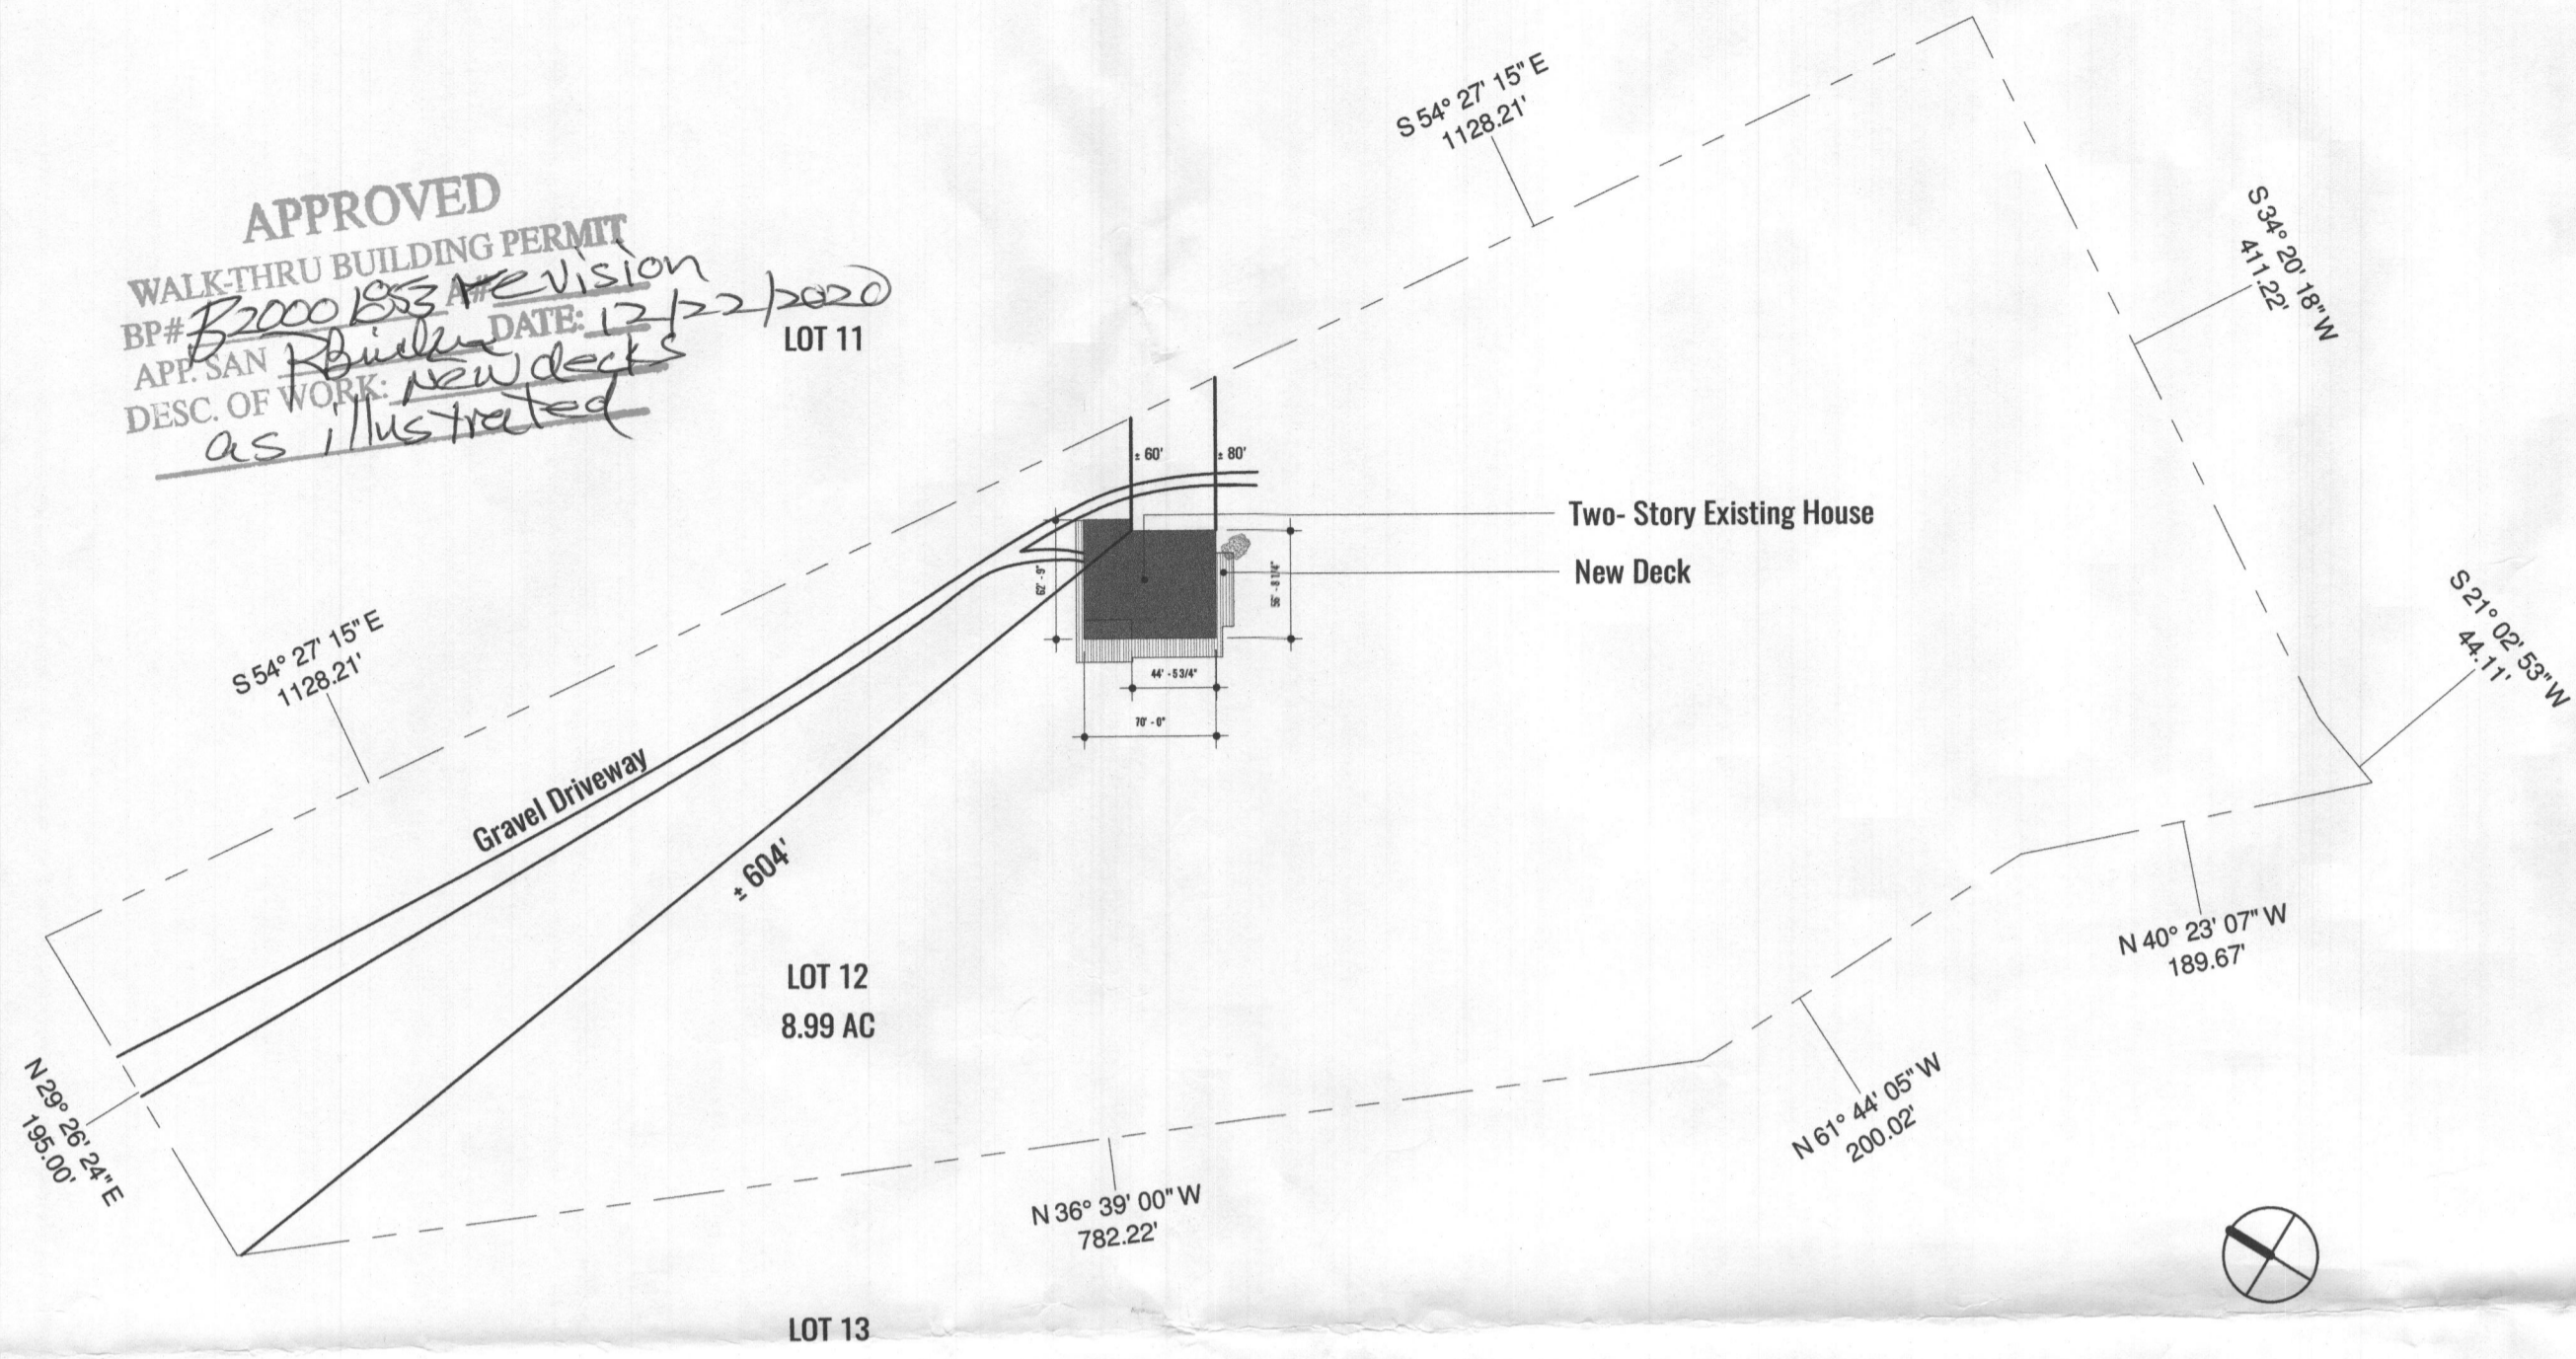

01 Site Plan - Existing
 1" = 100'-0"

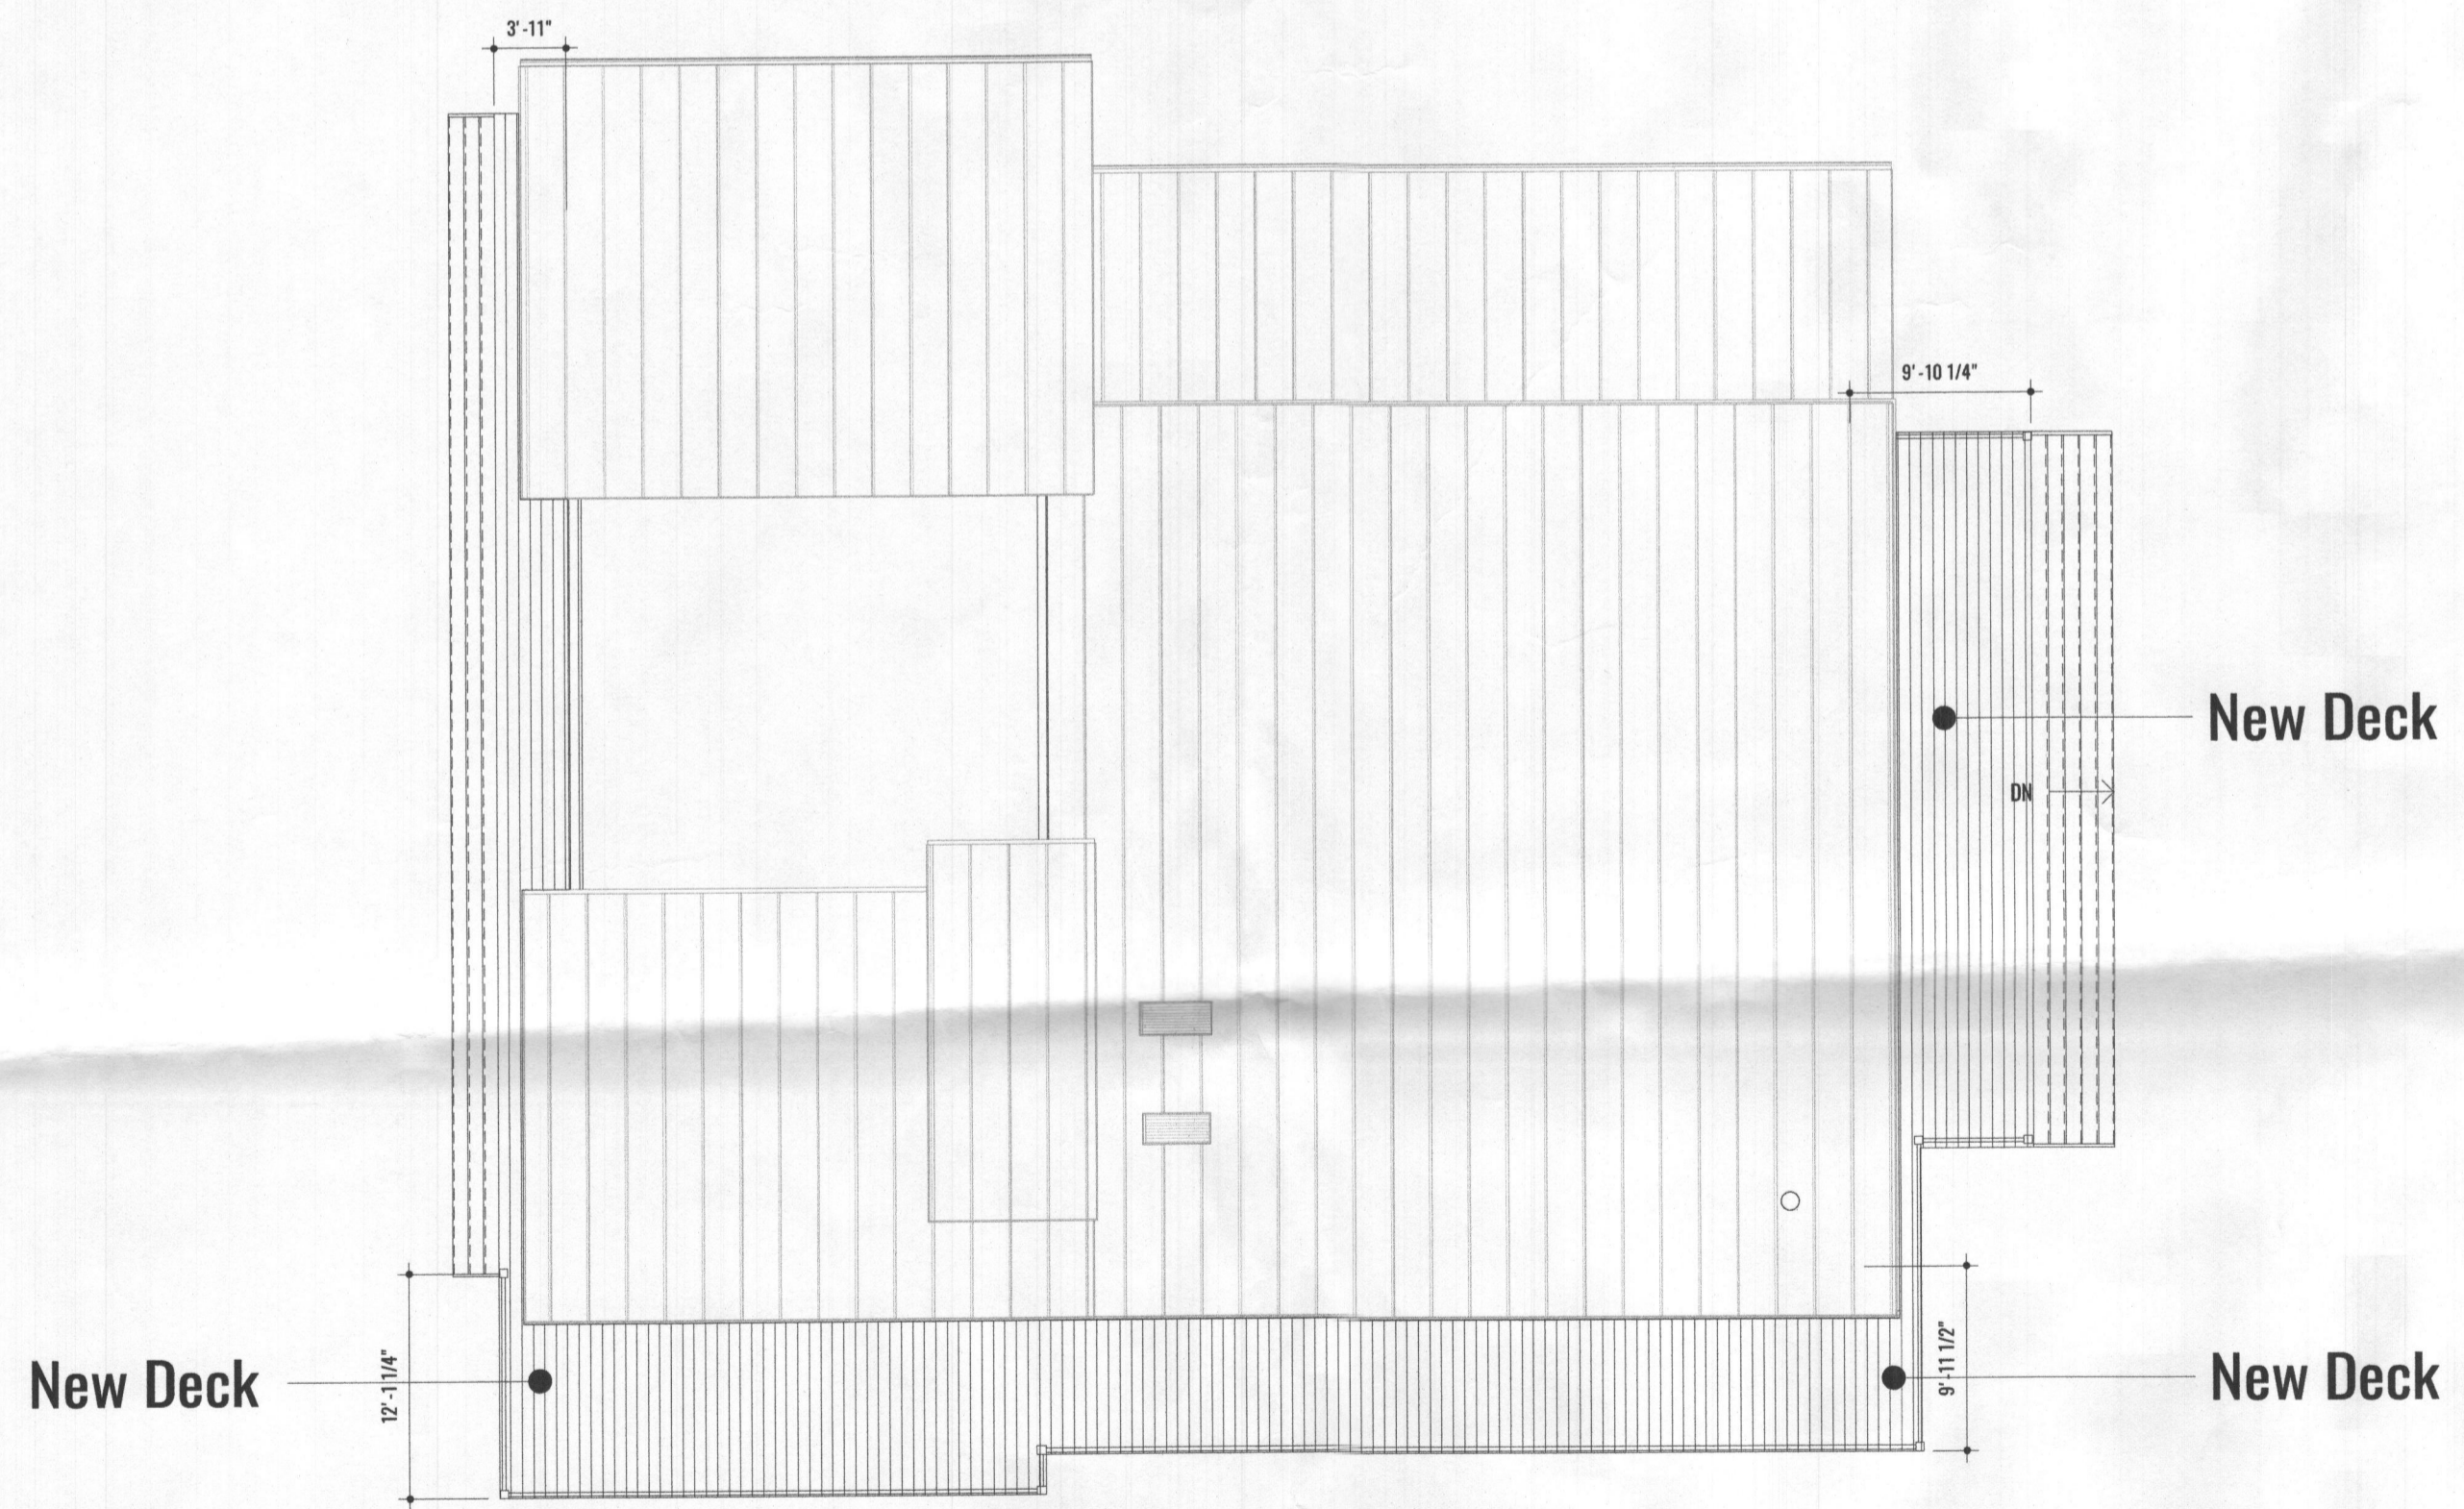

02 Site Plan - Detail
 1" = 10'-0"

I CERTIFY THAT THESE DOCUMENTS WERE PREPARED OR APPROVED BY ME AND THAT I AM A DULY LICENSED ARCHITECT UNDER THE LAWS OF STATE OF MARYLAND. LICENCE N° 6152 - EXP. DATE 09-02-20

BUILDER:
 Bernard Cabido
 3801 CEDAR CROFT PLACE
 BRENTWOOD, MD 20722
 CONTACT: BERNARD CABIDO
 PH: 240-421-5023

Highland

Mr. Jakson Cabido

14085 Clarksville Pike Highland MD, 20777

REV #	DATE	DESCRIPTION

STATUS: Permit

PROJECT NUMBER:

DRAWN BY: Wallisson Az

SHEET NAME: Site Plan

SHEET NO.: A100

Scale: As inc