

*Approved RAK  
6/25/2020*

Menu Save Reset Cancel Help

Record Detail \* (This section is required.)

Permit Type	Permit Number	Opened Date
Building/Residential/Misc/Pool Spa	B20001820	06/16/2020
Description of Work		
SDF / INSTALL 16' X 36' INGROUND FIBERGLASS SWIMMING POOL, DEPTH 3'9"-6' 1.75", WITH FENCE TO CODE		

[check spelling](#)

Address \* (This section is required.)

Search Reset Clear Get Parcel & Owner

Street #	Street Name	Street Type	
13880	OLD FREDERICK	RD	
Unit Type	Unit #	X Coordinate	Y Coordinate
--Select--		-76.99431	39.33221
City	State	Zip Code	Primary
SYKESVILLE	MD	21784	Yes

Parcel \* (This section is required.)

Search Reset Clear Get Address & Owner

GIS ID *	Parcel	Parcel Area	Land Value	Improved Value	Exemption Value	Plan Area
11057553	117	17.15	388000	531300	143300	RURAL

Legal Description

IMPS17.159 A[ ]13880 OLD FREDERICK RD[ ]SYKESVILLE

[check spelling](#)

Block	Lot	Census Tract	Council Dist	Inspection Dist	Supervisor Dist	Map #	DAP Zone
	1	605601	5				
Plan Area	State Tax Id	Subdivision Name					
	1404321448	Five Hills Farm					
Section	Area	Tax Map					
		9					
Grid	Zoning District	ADC Map					
9-13	RC-DEO	4693-A7					
SDP No.	Final Plan No.	WP File No.	Primary				
	ECP-16-023		Yes				
Record Plat No.	WS Contract No.	FDP No.					
24111-2411							
Owner Occupied	Year Built	Historic District					
<input type="radio"/> Yes <input checked="" type="radio"/> No	1963	<input type="radio"/> Yes <input checked="" type="radio"/> No					
Historic District Registry No.	Stat Area	Flood Plain					
	4-03	<input type="radio"/> Yes <input checked="" type="radio"/> No					

Building No

Owner \* (This section is required.)

Search      Reset      Clear

Name \*

Address Line 1

Address Line 2

Address Line 3

Mail City      Mail State      Mail Zip Code

Phone      Primary

E-mail

Cell Number

Fax Number

Professionals (This section is not required.)

Search      Reset      Clear

License # \*

Business Name

License Type \*

First Name

Middle Name

Last Name

Primary

Address Line 1

Address Line 2

City

State

ZIP Code

Phone 1

Phone 2

Fax

E-mail

Applicant (This section is not required.)

Search      As Owner      As Lic. Prof      As Contact

Type \*

First Name

MI

Last Name

Relationship

Full Name

Primary

Organization Name

Street Address

Address Line 2

<b>City</b>	<b>State</b>	<b>Zip Code</b>
GERMANTOWN	MD	20876
<b>Phone</b>	<b>Cell</b>	<b>Fax</b>
240-644-4704	240-644-4704	
<b>E-mail *</b>		
LETICIAR@BROWNINGPOOLS.COM		

**Addtl Info**

<b>Est Construction Cost *</b>	<b>Housing Units *</b>	<b>Number of Buildings *</b>	<b>Public Owned</b>
95000	0	0	No
<b>Construction Type</b>			
--Select--			

**POOL INFORMATION**

**MISCELLANEOUS POOL INFORMATION**

<b>Capital Project-No Fee *</b>	<b>Capital Project Number</b>	<b>Fee Exempt *</b>	<b>Water Supply *</b>	<b>Sewage Disposal *</b>
<input type="radio"/> Yes <input checked="" type="radio"/> No		<input type="radio"/> Yes <input checked="" type="radio"/> No	Private	Private
<b>Existing Use</b>	<b>Type of Pool or Spa *</b>	<b>Electrical Permit Number</b>	<b>Expiration Date</b>	
SFD	In Ground Pool		12/15/2020	

**PAYMENT INFORMATION**

<b>Check 1</b>	<b>Payee 1</b>	<b>SAP Doc No</b>	<b>SAP Entered</b>

**Related Records**

« 1 »

<u>Permit Number</u>	<u>Record Type Alias</u>	<u>Status</u>	<u>Number</u>	<u>Street Name</u>	<u>Opened Date</u>	<u>Des</u>
B20001820	Residential Pool or Spa Permit	Review In Process	13880	OLD FREDERICK	06/16/2020	SDI
E20002524	Residential Electrical Miscellaneous Permit	Issued	13880	OLD FREDERICK	06/16/2020	Sfd
E20002706	Residential Electrical Miscellaneous Permit	Application Acceptance Pending	13880	OLD FREDERICK	06/25/2020	WIF

« 1 »


< \_\_\_\_\_ >

Submit Cancel

Approved R14  
 6/25/2020  
 B20001820

**GENERAL NOTES:**

1. THE LOTS OF THIS SUBDIVISION ARE SEPARATE AND NOT TO BE CONSIDERED AS ONE UNIT UNLESS OTHERWISE SHOWN ON THIS PLAN.
2. THE LOTS OF THIS SUBDIVISION ARE SEPARATE AND NOT TO BE CONSIDERED AS ONE UNIT UNLESS OTHERWISE SHOWN ON THIS PLAN.
3. THE LOTS OF THIS SUBDIVISION ARE SEPARATE AND NOT TO BE CONSIDERED AS ONE UNIT UNLESS OTHERWISE SHOWN ON THIS PLAN.
4. THE LOTS OF THIS SUBDIVISION ARE SEPARATE AND NOT TO BE CONSIDERED AS ONE UNIT UNLESS OTHERWISE SHOWN ON THIS PLAN.
5. THE LOTS OF THIS SUBDIVISION ARE SEPARATE AND NOT TO BE CONSIDERED AS ONE UNIT UNLESS OTHERWISE SHOWN ON THIS PLAN.
6. THE LOTS OF THIS SUBDIVISION ARE SEPARATE AND NOT TO BE CONSIDERED AS ONE UNIT UNLESS OTHERWISE SHOWN ON THIS PLAN.
7. THE LOTS OF THIS SUBDIVISION ARE SEPARATE AND NOT TO BE CONSIDERED AS ONE UNIT UNLESS OTHERWISE SHOWN ON THIS PLAN.
8. THE LOTS OF THIS SUBDIVISION ARE SEPARATE AND NOT TO BE CONSIDERED AS ONE UNIT UNLESS OTHERWISE SHOWN ON THIS PLAN.
9. THE LOTS OF THIS SUBDIVISION ARE SEPARATE AND NOT TO BE CONSIDERED AS ONE UNIT UNLESS OTHERWISE SHOWN ON THIS PLAN.
10. THE LOTS OF THIS SUBDIVISION ARE SEPARATE AND NOT TO BE CONSIDERED AS ONE UNIT UNLESS OTHERWISE SHOWN ON THIS PLAN.

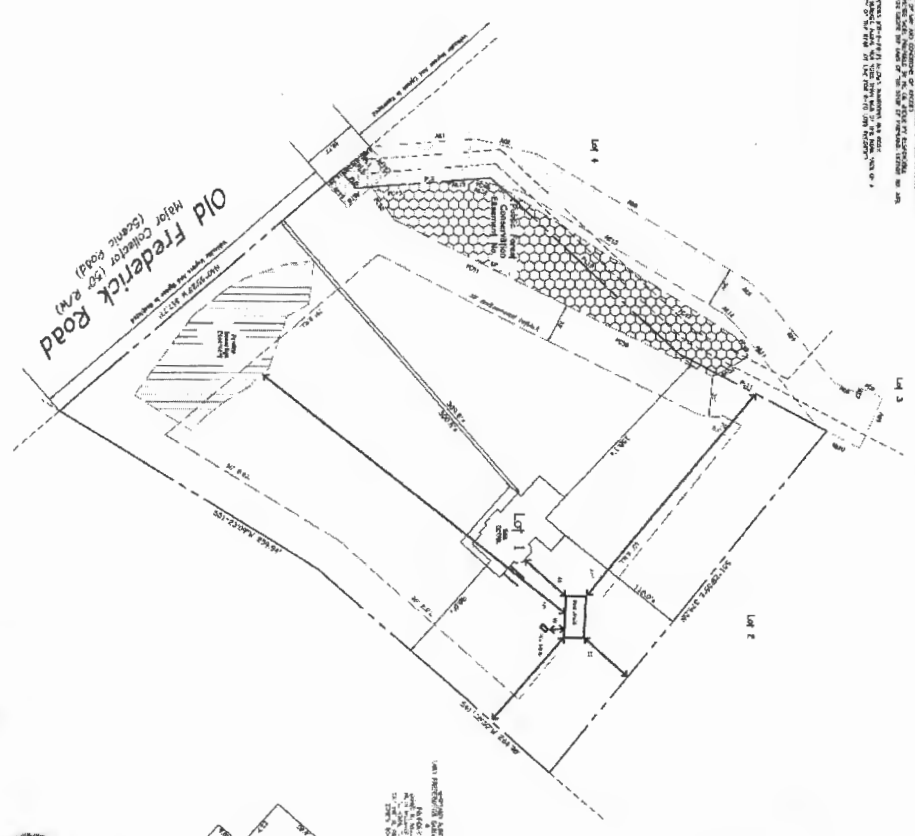

Lot No.	Area (Acres)	Area (Sq. Ft.)	Dimensions (Feet)
Lot 1	1.23	53,000	150' x 350'
Lot 2	0.45	19,500	100' x 200'
Lot 3	2.15	93,000	200' x 450'
Lot 4	3.80	165,000	300' x 550'

Property Line	Line Value	Area (Acres)	Area (Sq. Ft.)
North	150'	0.15	6,500
South	150'	0.15	6,500
East	150'	0.15	6,500
West	150'	0.15	6,500

**PREPARED BY:**  
 [Signature]  
 [Firm Name]

**DATE:**  
 6/25/2020



**PROJECT LOCATION:**  
 [Address]  
 [City, State]

**SCALE:**  
 1" = 100'