




Att'n: Annette Merson-Sacks

Approved  
B20001668  
RAC 6/11/2020

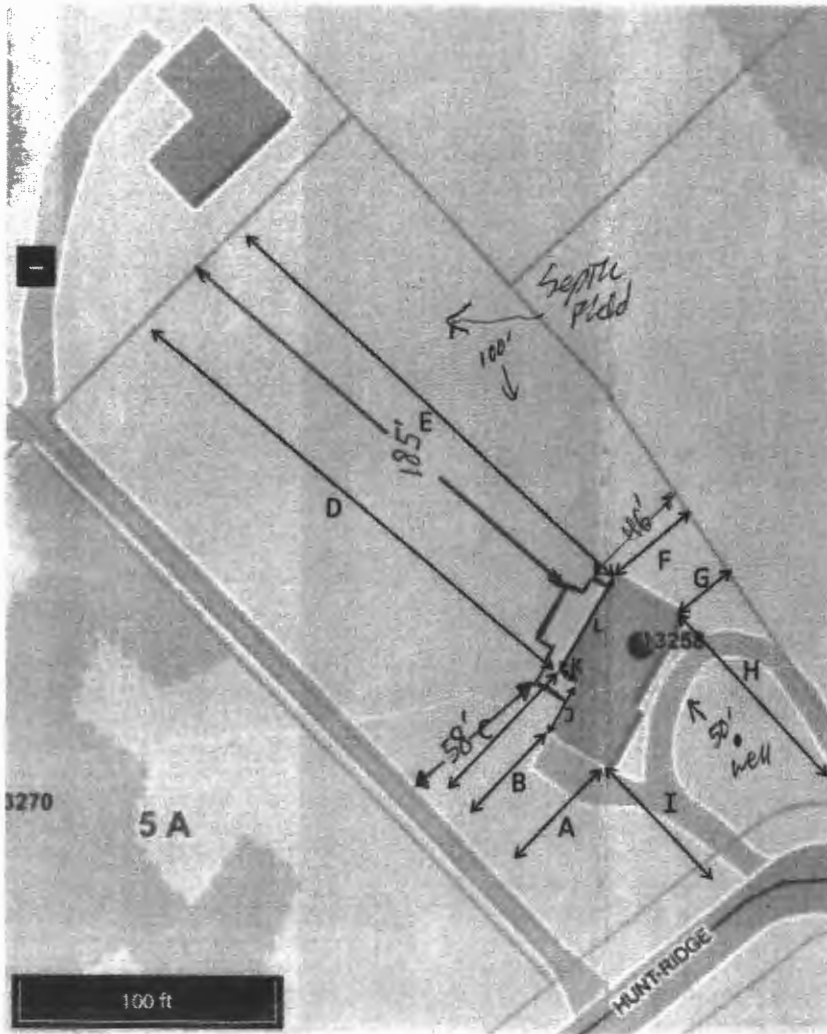

3 Jan 2020 Willey Deek

13258 Hunt Ridge, Ellicott City, MD 21042

Source:

1. <https://data.howardcountymd.gov/InteractiveMap.html>
2. Measurements on 3 Jan 2020

A = 52', Shortest distance from garage S corner to side fence  
B = 46' 6", Shortest distance to garage W corner to side fence  
C = 66', Shortest distance from house W corner to side fence  
D = 209' 5", Shortest distance from house W corner to back fence  
E = 197' 6", Shortest distance from house N corner to back fence  
F = 40' 6", Shortest distance from house N corner to side fence  
G = 29', Shortest distance from house E corner to side fence  
H = 88', Shortest distance from house E corner to front fence  
I = 63', Shortest distance from garage S corner to front fence

J = 22' 1", Outside wall along Garage

K = 8' 0.5", Outside Wall along Kitchen

L = 40' 4", Outside Wall along back of house not including garage

Side and Back Fences are inside shown property boundaries.