

Online Permit

Menu

Refine Search

GIS

Help

Data Filter: Filter TMP's My Filters


Showing 1 of 1

<input type="checkbox"/> <u>Permit #</u>	<u>Status</u>	<u>Record Type Alias</u>	<u>Street #</u>	<u>Street Name</u>	<u>Type</u>	<u>Unit Type</u>	<u>Unit #</u>	<u>City</u>
<input type="checkbox"/> <u>B21001030</u>	Review In Process	Residential Pool or Spa Permit	3215	HUNTERSWORTH				GLENW

Page of 1

Approved Septic System Plan
Howard County Health Department

Dana Beard
Signature Date 08/21

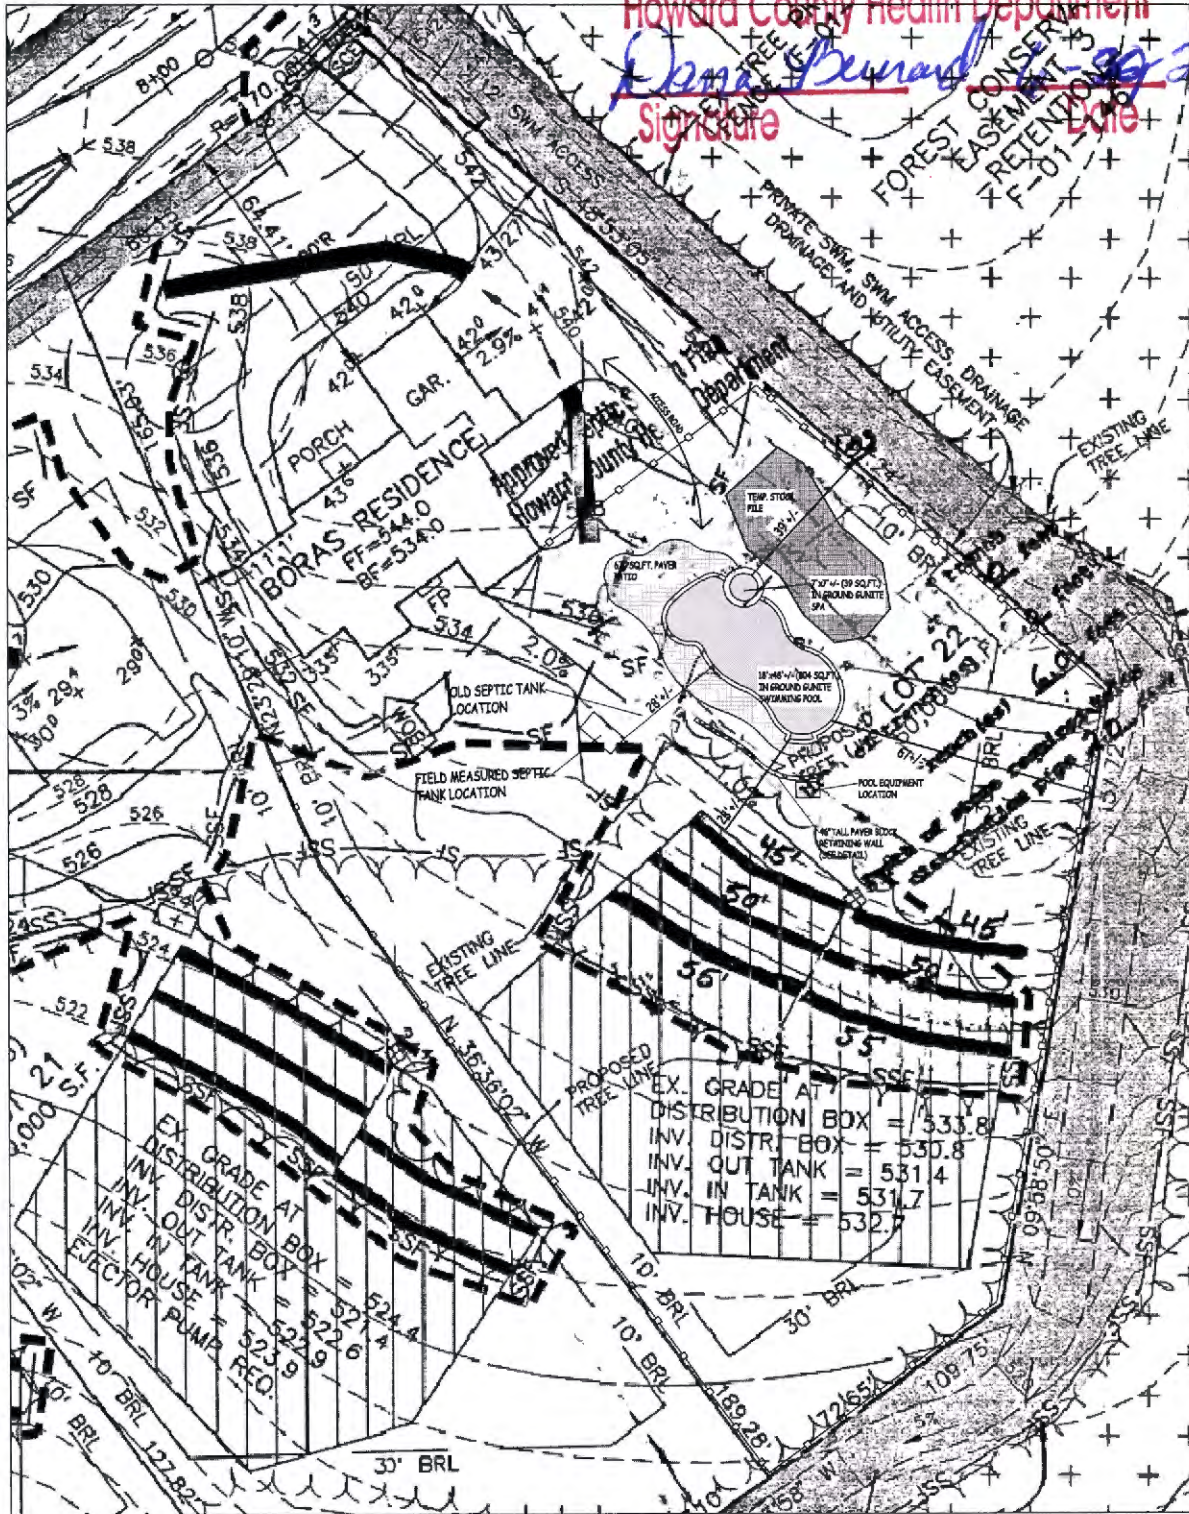

<p>Johnson Pools</p> <p><small>Company Information:</small> 1424 Odenton Road, Ste 28 Odenton, MD 21113 © 410.507.3832 www.johnsonpools.com MHC # 133210</p>	<p>Castaldo Residence</p> <p><small>PROJECT ADDRESS:</small> 3215 Huntersworth Way Greenwood, MD 21738</p>	<p><small>DISCLAIMER:</small> This design and site plan are prepared and submitted by the designer and are the sole responsibility of the designer. The designer and submitter warrant that the design and site plan are prepared and submitted in accordance with the applicable laws and regulations. The designer and submitter warrant that the design and site plan are prepared and submitted in accordance with the applicable laws and regulations. The designer and submitter warrant that the design and site plan are prepared and submitted in accordance with the applicable laws and regulations.</p>	<p><small>FILE:</small> Swimming Pool Site Plan</p> <p><small>DATE:</small> 08/22/2021</p> <p><small>DESIGNER:</small> Zachary S. Casto 0964 443 4333 ZCasto@johnsonpools.com</p>
---	---	---	---

