

110

2120 DUVALL RD

Health

AMENDMENT

RECEIVED

JUN 23 2021

Howard County Department of Inspections, Licenses, & Permits

LICENSES & PERMITS DIVISION

I am writing this letter on behalf of Jill & Alex Godzilevsky the home owners of 2120 Duvall Road in Woodbine MD 21797. My name is Greg Sinon and I am the contractor (Rhine Landscaping MHIC#121739) that is building their swimming pool. We pulled a building permit (B21001097) and I am requesting to amend and change the location of the pool. Upon having Miss Utility out to the house we found that the power lines run directly through where our original pool location was going to be and therefor we would like to propose moving the location of the pool. I have attached (4) copies of the revised pool location plan for this address.

Thank you,

Greg Sinon
Rhine Landscaping
410-442-2445 ex. 127
MHIC# 121739

INV #
CK# 10269
\$50.00

Approved 6/30/21
-H.O.

Proposed In Ground
20'x50' Swimming Pool
w/ AUTO COVER

P.O.B.
1297/390

€ 30

N 56°40'31" E 865.41'

Depth 3'6" Shallow
8' Deep End

48'-4"

20'x11' SHED
202'-5"

WELL
196'-2"

40'-6" Equipment Pad
Location

#2720
SEE
HOUSE DETAIL

624'±

18691/156
5.191 Ac.±

MAC
DRIVE

78'±

S 55°17'45" W 871.20'

GODZILEVSKY RESIDENCE

19425/339

PIPE
FOUND


SCALE : 1' = 100'



- NOTES:
- 1) AUTO COVER to Serve as Safety Device (See Signed Letter)
 - 2) Dirt to be Hauled off Site
 - 3) Driveway to be used for access road

PIPE
FOUND

MAC
ROA.

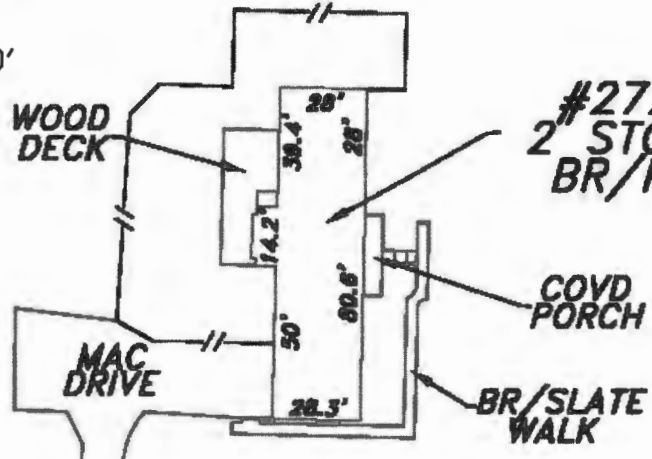

NOTE: THE FENCE
LIE AT, NE
THE SUBJE
LINE.

REVISED
Date: 6/23/2021
Comments: B21-1097
POOL LOCATION CHANGE