

Mail City	Mail State	Mail Zip Code
CLARKSVILLE	MD	21029
Phone	Primary	
443-299-6500	Yes	
E-mail		
Cell Number	Fax Number	

Professionals * (This section is required.)

Search Reset Clear

License # *	Business Name		
20020020113	FRIEDEL CONTRACTING		
License Type *	First Name	Middle Name	Last Name
Plumb/Gas	STEPHEN	L	FRIEDEL
Primary	Address Line 1		
No	4001 MCMULLEN RD.		
	Address Line 2		
	4001 MCMULLEN ROAD		
	City	State	ZIP Code
	TANEYTOWN	MD	21787-0000
	Phone 1	Phone 2	Fax
	4107562221		4107562221
	E-mail		
	STFRIEDEL@HOTMAIL.COM		

B20003486

Applicant (This section is not required.)

Search As Owner As Lic. Prof As Contact

Type *	First Name	MI	Last Name
Applicant	STEPHEN	L	FRIEDEL
Relationship	Full Name		
--Select--			
Primary	Organization Name		
Yes	FRIEDEL CONTRACTING		
	Street Address		
	4001 MCMULLEN RD.		
	Address Line 2		
	4001 MCMULLEN ROAD		
	City	State	Zip Code
	TANEYTOWN	MD	21787-0000
	Phone	Cell	Fax
	4107562221		4107562221
	E-mail *		
	STFRIEDEL@HOTMAIL.COM		

RESIDENTIAL PLUMBING INFO

PLUMBING INFORMATION

Capital Project-No Fee *	Capital Project Number	Fee Exempt *	Replacement	Home Owner Permit	Building Permit No *	
<input type="radio"/> Yes <input checked="" type="radio"/> No		<input type="radio"/> Yes <input checked="" type="radio"/> No	<input type="radio"/> Yes <input checked="" type="radio"/> No	<input type="radio"/> Yes <input type="radio"/> No	B02388469/ B200024	
Existing Use	Total Fixtures	Water and Sewer Type	Water Contract No.	Sewer Contract No.		
--Select--	5	--Select--				
Sewer Pipe Diameter	Sewer Pipe Materials	Sewer Pipe Length	Water Pipe Diameter	Water Pipe Materials	Water Pipe Length	
3	pvc	60 FT	34	poly	80 FT	
Storm Sewer Pipe Diameter	Storm Sewer Pipe Materials	Storm Sewer Pipe Length	Gas Pipe Diameter	Gas System Type		
		FT	112	Natural		
Gas Pipe Materials	Gas Pipe Length	Total Gas Fixtures	Total BTUs	Gas Meter *	BGE Work Order No	Expiration Date
poly	150 FT	2	500000 BTU	Meter Upgrade		4/17/2021

SERVICE INFORMATION

In Service *	In Service Inspection Date	Plumbing Permit Release Date
<input type="radio"/> Yes <input type="radio"/> No		

PAYMENT INFORMATION

Check 1 Payee 1 Check 2 Payee 2 SAP Doc No SAP Entered



Related Records

« 1 »

<u>Permit Number</u>	<u>Record Type Alias</u>	<u>Status</u>	<u>Number</u>	<u>Street Name</u>	<u>Opened Date</u>	<u>Description</u>
B20003486	Residential Addition Single Family Dwelling Permit	Review In Process	13005	RED MAPLE	10/13/2020	SFD/ CONSTRUCT 10 X10 BATH HOU
E20004628	Residential Electrical Addition Alteration Permit	Application Acceptance Pending	13005	RED MAPLE	10/16/2020	Pavilion near the pool. Ceiling fan, light,
P20003955	Residential New Plumbing Permit	Incomplete	13005	RED MAPLE	10/19/2020	Install new pool heater. Install new grill c


« 1 »




Submit Cancel

GENERAL NOTES:

- 1) THIS PLAT IS PREPARED FOR THE BENEFIT OF THE CLIENT SIGNING THE HOUSE LOCATION SURVEY APPROVAL FORM INsofar AS IT IS REQUIRED BY A LENDER OR TITLE INSURANCE COMPANY OR ITS AGENTS IN CONNECTION WITH THE CONTEMPLATED TRANSFER, FINANCING OR RE-FINANCING. UNLESS INDICATED AS BEING A BOUNDARY SURVEY, THIS PLAT IS NOT INTENDED FOR USE IN THE ESTABLISHMENT OF PROPERTY LINES AND IS NOT TO BE RELIED UPON FOR THE ESTABLISHMENT OR LOCATIONS OF FENCES, GARAGES, BUILDINGS OR OTHER EXISTING OR FUTURE IMPROVEMENTS. AS A RESULT, THIS PLAT DOES NOT PROVIDE FOR ACCURATE IDENTIFICATION OF PROPERTY LINE, BUT SUCH IDENTIFICATION MAY NOT BE REQUIRED FOR THE TRANSFER OF TITLE OR SECURING FINANCING OR RE-FINANCING.
- 2) SUBJECT PROPERTY IS SHOWN IN ZONE C ON THE NATIONAL FLOOD INSURANCE PROGRAM FLOOD INSURANCE RATE MAP OF HOWARD COUNTY, MARYLAND, COMMUNITY PANEL No. 240044 0021 B, EFFECTIVE DATE: DEC. 4, 1986
- 3) THE OFFSETS FROM BUILDING LINE TO PROPERTY LINE AS SHOWN ON THE PLAT HEREON ARE TO AN ACCURACY OF 1' PLUS OR MINUS (±).
- 4) NO TITLE REPORT FURNISHED, SUBJECT TO ALL EASEMENTS AND CONDITIONS OF RECORD.

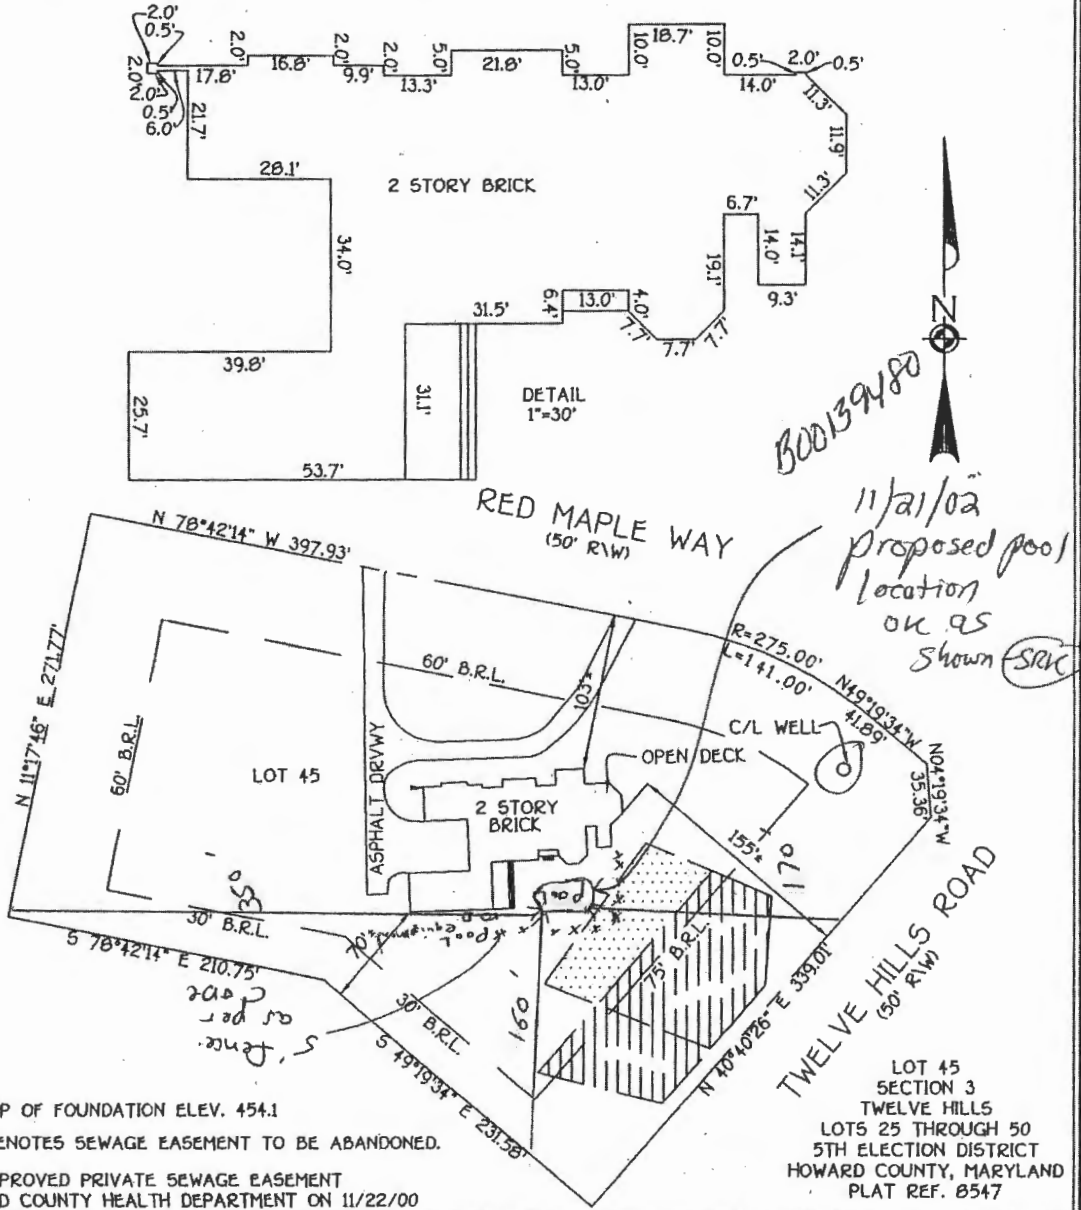

FISHER, COLLINS & CARTER, INC.
CIVIL ENGINEERING CONSULTANTS & LAND SURVEYORS
CENTENAL SQUARE OFFICE PARK - 10272 BALTHORE NATIONAL PIKE
ELLICOTT CITY, MARYLAND 21042
(410) 461 - 2255

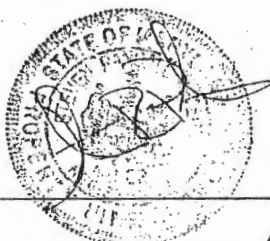

PROFESSIONAL LAND SURVEYOR
REG. 502
DATE 11/02/01

HOUSE LOCATION DRAWING

FOUNDATION LOCATION: 3/22/01
FINAL LOCATION: 10/30/01
BOUNDARY SURVEY: _____

SCALE: 1"=100'
DATE: 11/02/01
DRAWN BY: D.B.
CHECKED BY: G.C.
PROJECT No.: 61601

LOT 45

ASPHALT DRVWY

103

C/L W

OPEN DECK

20 ft set back on SRA




PAVILION 800 SQ FT

Rumford style
800 sq.ft. Pavilion

100 sq.ft. Bathroom

40 sq.ft. stone countertop

70 sq.ft. cantilevered stone countertop

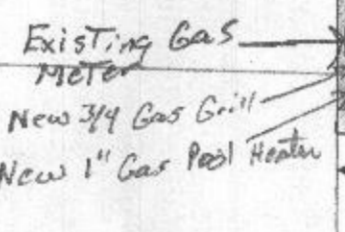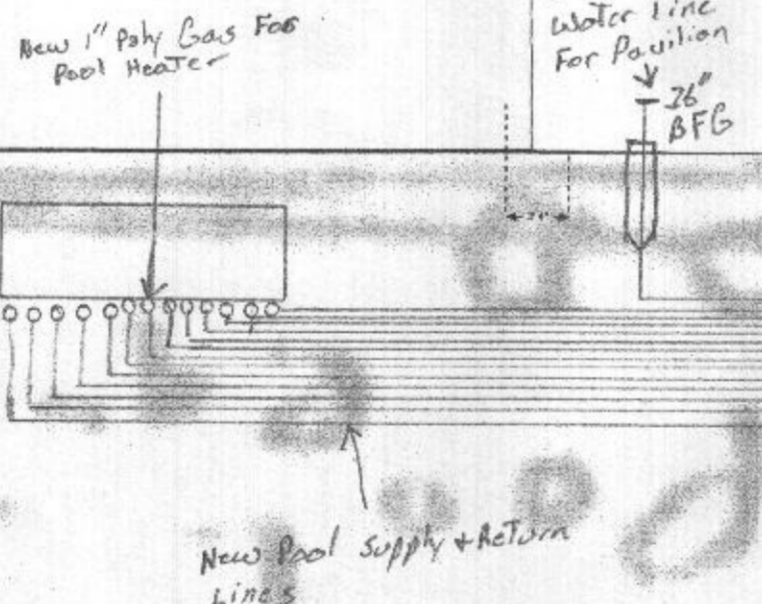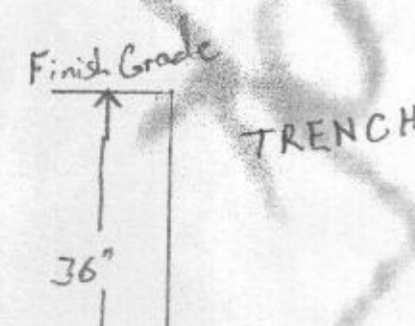

Existing Gas Main

Existing 4" Sewer House Main 40" BFG.
Can. New 5" Sewer To Existing 4" Sewer + 40" BFG

Existing Septic Tank

Existing Pump Tank

New 3" San Sewer + 30" BFG AT Foundation

1" Gas

3/4" WATER

14"10"

800 sq.ft. Pavilion

3/4" WATER

2" VTR

3/4" Gas Grill

20'

155'