

WATER WELL ABANDONMENT-SEALING REPORT FORM

SUBMIT COPIES OF COMPLETED FORM TO:

- * COUNTY ENVIRONMENTAL AGENCY (contact MDE, WMA if address needed)
- * WELL OWNER
- * MDE, WATER MANAGEMENT ADMINISTRATION, WELL PROGRAM

DATE WELL ABANDONED: 01-20-2020 (month/day/year)

* PERMIT NUMBER OF ABANDONED WELL (if any) N/A


* PERMIT NUMBER OF REPLACEMENT WELL:

* PERSON ABANDONING WELL: Jorge A. Montes WELL DRILLER'S LICENSE NUMBER JWD 402

CIRCLE: MWD / MSD / MGD

* OWNER'S NAME: Larry Gaetano

SITE LOCATION MAP

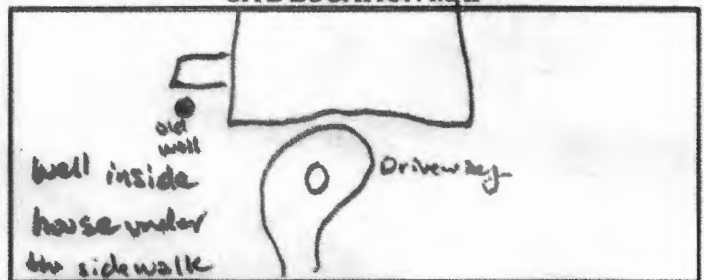

* WELL LOCATION:
 COUNTY: Howard
 NEAREST TOWN: Beltsville City
 TAX MAP 0025 BLOCK PARCEL 0161
 SUBDIVISION: Katypson Hts
 SECTION: LOT
 STREET ADDRESS: 3534 Church Road

LATITUDE 39.163380

LONGITUDE 76.439391

*well is hose in pit 4' below grade
 well seal/pump removed*

* TYPE OF WELL BEING ABANDONED:

- DRILLED JETTED
- BORED HAND DUG
- OTHER (specify)

* USE CODE:

- DOMESTIC MUNICIPAL/PUBLIC
- IRRIGATION INDUSTRIAL
- TEST/OBSERVATION GEOTHERMAL

* TYPE OF CASING:

- STEEL PLASTIC
- CONCRETE OTHER (specify)

LOG OF SEALING MATERIAL

MATERIAL	FEET	
	FROM	TO
<i>Bentonite clay</i>	<i>80</i>	<i>0</i>
VOLUME OF MATERIAL USED		
<i>3 bags holeplug</i>		

SIZE OF CASING: 6" INCHES IN DIAMETER

DEPTH OF WELL: 80' FEET DEEP

WAS ANY CASING REMOVED? YES NO

If yes, length removed, in feet:

WAS CASING RIPPED OR PERFORATED? YES NO

SIGNATURE: William [Signature] WELL DRILLER OR SUPERVISING SANITARIAN LICENSE# 233

MWD MSD MGS 01/20/20 DATE
 CIRCLE ONE

Pursuant to § 10-624 of the State Govt. Article of the Maryland Code, personal info requested on this form is used in processing this form pursuant to COMAR 26.04.04. Failure to provide the info may result in this form not being processed. You have the right to inspect, amend, or correct this form. The Maryland Department of the Environment is subject to the Maryland Public Information Act. This form may be made available on the Internet via MDE's website and is subject to inspection or copying, in whole or in part, by the public and other governmental agencies, if not protected by federal or State Law.



Well Pump 1/21/2020 RAE

Pit + Well

K

Well 50W5

1/5/5050

1/5/5050

Fit Well

40-50

40'

