

# PERMIT

SEWAGE DISPOSAL SYSTEM

MARYLAND STATE DEPARTMENT OF HEALTH

HOWARD COUNTY

P 01139

A 00684

ELLCOTT CITY

DISTRICT 4

DATE 6-15-59

INDEXED

David Brown

IS PERMITTED TO INSTALL  ALTER

ADDRESS Mt. Airy

PHONE

A SEWAGE DISPOSAL SYSTEM LOCATED AT Daisy Rd., Rt. 96 off 144 - 1/2 mi.

SUBDIVISION

ROAD

LOT

PROPERTY OWNER Massey, William Edwin

ADDRESS RFD 2, Woodbine - Sykesville 239 J 1.

## SPECIFICATIONS

DRAIN FIELD  DEPTH 3 FEET, BOTTOM AREA 360 SQ. FT.

SEEPAGE PITS ABSORBENT SIDE-WALL AREA SQ. FT.

SEPTIC TANK CAPACITY 750 GALLONS

FOR GARBAGE GRINDER, INCREASE DISPOSAL AREA 22% & TANK CAPACITY 50%.

OTHER Locate lines about 115 - 95' from the back line.

System must be installed in area that passed perc. test.


PLANS APPROVED BY Raymond Hodges

DATE 4-8-59

FILL SEPTIC TANK AND DISTRIBUTION BOX WITH WATER BEFORE CALLING FOR AN INSPECTION. COVER NO WORK UNTIL INSPECTED AND APPROVED.

NEITHER THE HOWARD COUNTY COMMISSIONERS NOR THE HEALTH DEPARTMENT IS RESPONSIBLE FOR THE SUCCESSFUL OPERATION OF ANY SYSTEM.

00684

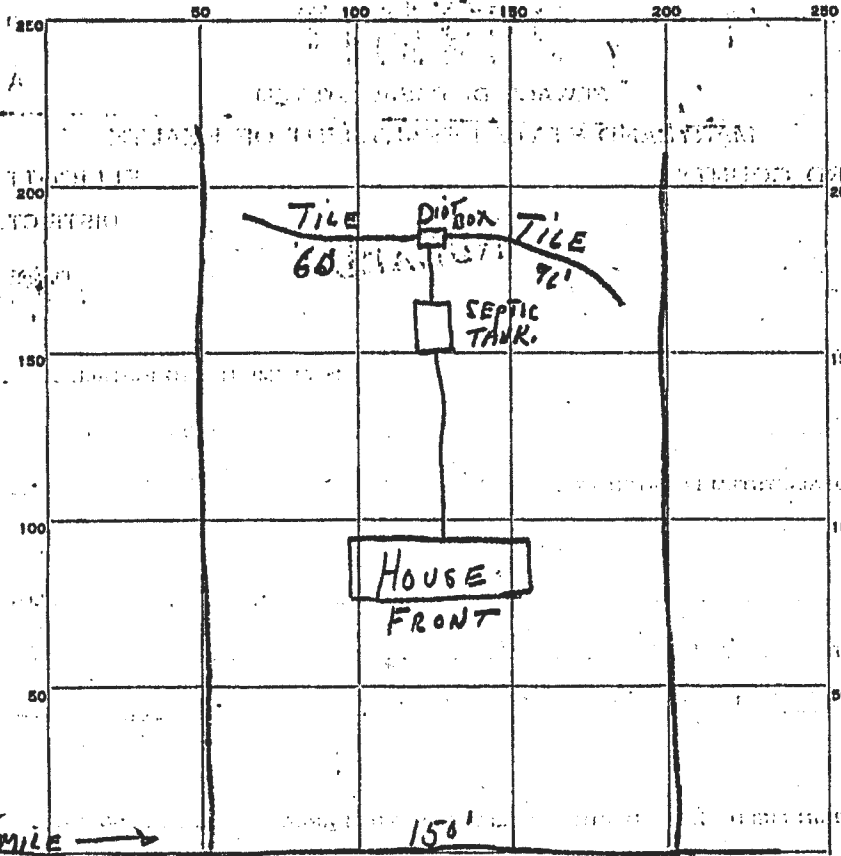

33  
96  
63  
157  
780

INDICATE NORTH - NAME ADJOINING ROADWAY AS BASE LINE.  
DAISY ROAD

PERMIT CARD ajca

SEPTIC TANK, LEVEL OK CLEANOUTS 2

DISTRIBUTION BOX, LEVEL OK

TILE FIELD, DEPTH 2-3 FT. TRENCH WIDTH 2 1/2 changed to 3 ft

GRAVEL DEPTH 1/2 IN. TOTAL LENGTH 147 changed to 156

NUMBER OF TRENCHES 2 TOTAL BOTTOM AREA 367.5 FT. = 458

SEEPAGE PITS, INSIDE DIAMETER \_\_\_\_\_ FT. DEPTH BELOW INLET \_\_\_\_\_ FT.

ABSORBENT AREA \_\_\_\_\_ SQ. FT.

REMARKS 2"-3" over pipe cement added to pipes in distribution box

DATE SYSTEM APPROVED 7/16/59 by Raymond Hodges INSPECTOR J. Hennigan