


June 14, 2010

Bureau of Environmental Health
Attn: Brian Baker or Sarah or Kevin
7178 Columbia Gateway Dr.
Columbia, MD 21046
Re: 9206 Old Frederick Rd. Ellicott City, MD 21042


To Whom It May Concern:

On Thursday June 10, 2010 Zepp Plumbing & Heating, Inc. physically disconnected the existing 500 gallon concrete septic tank. Jenkins Brothers pumped the septic tank out. Zepp removed the top half of the concrete septic tank, filled the bottom half w/ fill dirt, crushed the top half & side walls & overfilled w/ 3-4 ft of fill dirt to grade in place. Enclosed is a copy of the receipt from Jenkins Brothers for the pump out. Also included is a copy of the original layout that existed but is no longer in service. Please update your records. You can reach me @ 410-531-6712 if you need any more info.

Thank you,

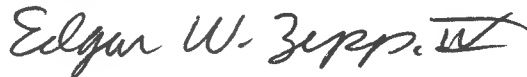

Edgar W. Zepp IV

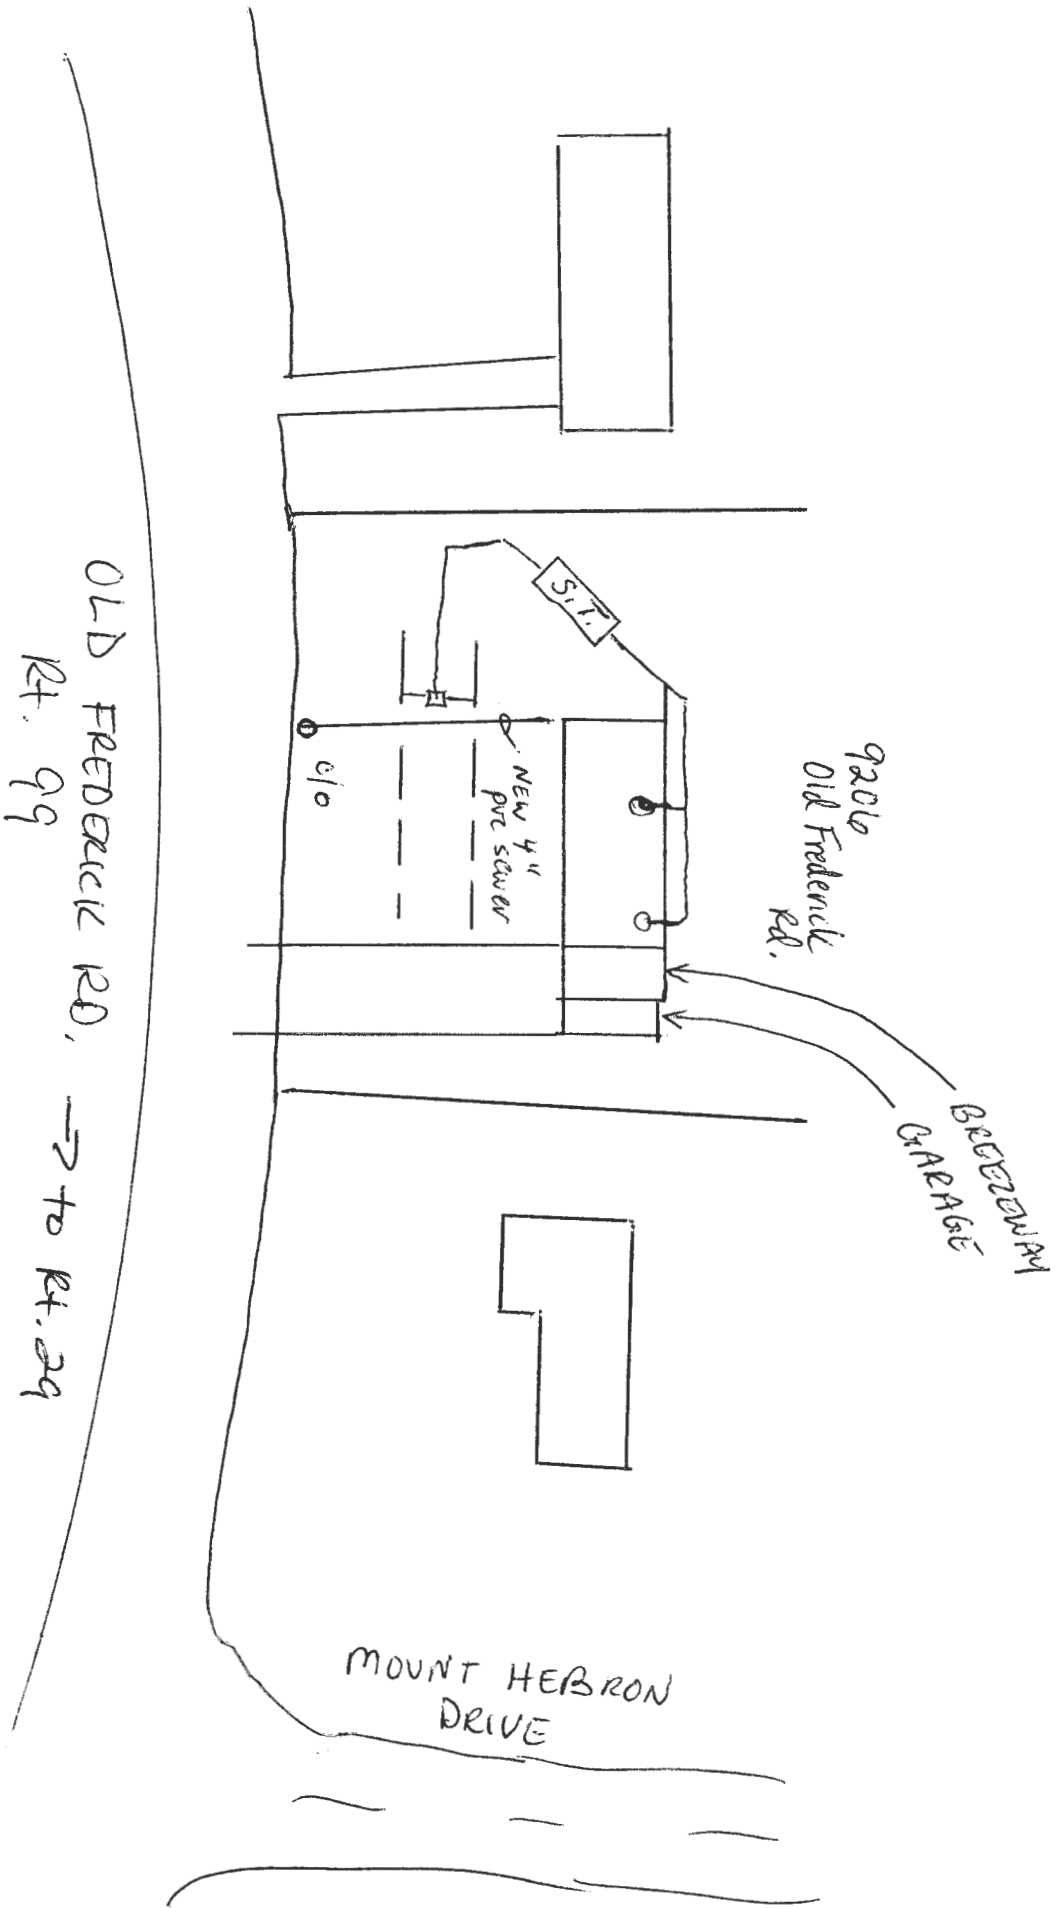

OLD FREDERICK RD,
Rt. 99 → to Rt. 29

9206
Old Frederick
Rd.

BREZZENMAN
GARAGE

NEW 4"
PVC SAWHUB

S.I.T.

c/o

MOUNT HERBON
DRIVE

Stamervo
9206 Old Fred. Rd.
6/10/10