
WATER WELL ABANDONMENT-SEALING REPORT FORM

SUBMIT COPIES OF COMPLETED FORM TO:

- * COUNTY ENVIRONMENTAL AGENCY (contact MDE, WMA if address needed)
- * WELL OWNER
- * MDE, WATER MANAGEMENT ADMINISTRATION, WELL PROGRAM

APPROVED
03/21/2021 P

DATE WELL ABANDONED: APRIL 30, 2019 (month/day/year)

* PERMIT NUMBER OF ABANDONED WELL (if any) _____


* PERMIT NUMBER OF REPLACEMENT WELL: _____

* PERSON ABANDONING WELL: Bruce Thompson WELL DRILLER'S LICENSE NUMBER: ISD 038
CIRCLE: MSD / MGD

* OWNER'S NAME: KMA ASSOCIATES

SITE LOCATION MAP

* WELL LOCATION:
COUNTY: HOWARD
NEAREST TOWN: LAUREL
TAX MAP _____ BLOCK _____ PARCEL _____
SUBDIVISION: _____
SECTION: _____ LOT: _____
STREET ADDRESS: 9910 HARMONY LANE

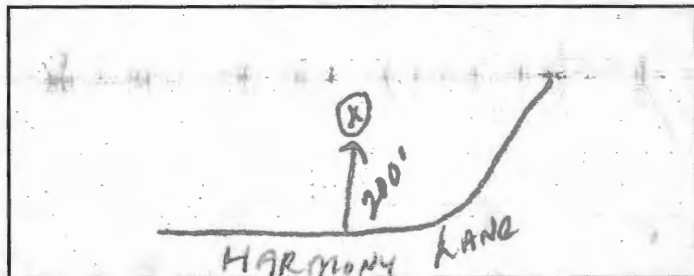

LATITUDE 39.124173

LONGITUDE 76.838355

LOG OF SEALING MATERIAL

* TYPE OF WELL BEING ABANDONED:
 DRILLED _____ JETTED _____
_____ BORED _____ HAND DUG _____
_____ OTHER (specify) _____

MATERIAL	FEET	
	FROM	TO
Bentonite	82	2
Backfill	2	0

* USE CODE:
 DOMESTIC _____ MUNICIPAL/PUBLIC _____
_____ IRRIGATION _____ INDUSTRIAL _____
_____ TEST/OBSERVATION _____ GEOTHERMAL _____

VOLUME OF MATERIAL USED

* TYPE OF CASING:
 STEEL _____ PLASTIC _____
_____ CONCRETE _____ OTHER (specify) _____

350 # Bentonite or slurry

SIZE OF CASING: 6 INCHES IN DIAMETER

DEPTH OF WELL: 82 FEET DEEP


WAS ANY CASING REMOVED? YES _____ NO _____
If yes, length removed, in feet: 2

WAS CASING RIPPED OR PERFORATED? _____ YES NO

SIGNATURE-MASTER WELL DRILLER OR SUPERVISING SANITARIAN LICENSE#
George F. Eastenbury

MWD MSD / MGS May 1 2019
CIRCLE ONE DATE

Pursuant to § 10-624 of the State Govt. Article of the Maryland Code, personal info requested on this form is used in processing this form pursuant to COMAR 26.04.04. Failure to provide the info may result in this form not being processed. You have the right to inspect, amend, or correct this form. The Maryland Department of the Environment is subject to the Maryland Public Information Act. This form may be made available on the Internet via MDE's website and is subject to inspection or copying, in whole or in part, by the public and other governmental agencies, if not protected by federal or State Law.

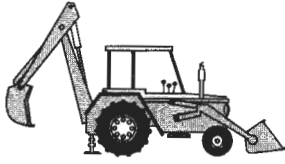

Sam's Excavating, Inc.

P.O. Box 0157
Fulton, MD 20759-0157
Cell Phone: (443) 277-7915

SDP 19-053

April 29, 2019

Howard County Health Dept
Kevin Wolf
8930 Stafford Blvd
Columbia, MD 21045
kwolf@howardcountymd.gov

RE: 9910Harmony Lane Abandonment of septic tank

Look for septic tank, believed already had been abandoned.

Picture to follow to your phone 410 313 2645.

Would you sign off please, so building permit can be issued.

If you have any questions please call me at 443-277-7915.

Sincerely,

Sam Wilkerson, President
Sam's Excavating, Inc.

Signature	Date
-----------	------