

WATER WELL ABANDONMENT-SEALING REPORT FORM

SUBMIT COPIES OF COMPLETED FORM TO:

- * COUNTY ENVIRONMENTAL AGENCY (contact MDE, WMA if address needed)
- * WELL OWNER
- * MDE, WATER MANAGEMENT ADMINISTRATION, WELL PROGRAM

APPROVED
 12/04/2008

DATE WELL ABANDONED: 10-6-20 (month/day/year)

* PERMIT NUMBER OF ABANDONED WELL (if any) _____

- N/A
 - City water

* PERMIT NUMBER OF REPLACEMENT WELL: _____


* PERSON ABANDONING WELL: Andrew Houseman WELL DRILLER'S LICENSE NUMBER: 224

CIRCLE: MWD / MSD / MGD

* OWNER'S NAME: Duane Gilbert

SITE LOCATION MAP

* WELL LOCATION:
 COUNTY: Howard
 NEAREST TOWN: Elliott City
 TAX MAP 0017 BLOCK 0008 PARCEL 0233
 SUBDIVISION: _____
 SECTION: _____ LOT: _____
 STREET ADDRESS: 9955 Old Mill Rd

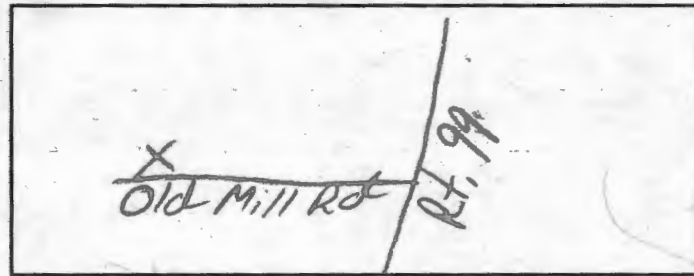

LATITUDE 3 9.301637

LONGITUDE 7 6.854173

LOG OF SEALING MATERIAL

MATERIAL	FEET	
	FROM	TO
Bentonite	30	0

* TYPE OF WELL BEING ABANDONED:
 DRILLED JETTED
 BORED HAND DUG
 OTHER (specify) _____

* USE CODE:
 DOMESTIC MUNICIPAL/PUBLIC
 IRRIGATION INDUSTRIAL
 TEST/OBSERVATION GEOTHERMAL

* TYPE OF CASING:
 STEEL PLASTIC
 CONCRETE OTHER (specify) _____

SIZE OF CASING: 6 INCHES IN DIAMETER

DEPTH OF WELL: 35 FEET DEEP

WAS ANY CASING REMOVED? YES NO
 If yes, length removed, in feet: 5

WAS CASING RIPPED OR PERFORATED? YES NO

8 BAGS
 Pursuant to § 10-624 of the State Govt. Article of the Maryland Code, personal info requested on this form is used in processing this form pursuant to COMAR 26.04.04. Failure to provide the info may result in this form not being processed. You have the right to inspect, amend, or correct this form. The Maryland Department of the Environment is subject to the Maryland Public Information Act. This form may be made available on the Internet via MDE's website and is subject to inspection or copying, in whole or in part, by the public and other governmental agencies, if not protected by federal or State Law.

SIGNATURE-MASTER WELL DRILLER OR SUPERVISING SANITARIAN LICENSE# 224 MWD / MSD / MGS 10-6-20
 CIRCLE ONE DATE

COUNTY