
WATER WELL ABANDONMENT-SEALING REPORT FORM

SUBMIT COPIES OF COMPLETED FORM TO:

- * COUNTY ENVIRONMENTAL AGENCY (contact MDE, WMA if address needed)
- * WELL OWNER
- * MDE, WATER MANAGEMENT ADMINISTRATION, WELL PROGRAM

Approved
3/16/21 SD

DATE WELL ABANDONED: 10-12-20 (month/day/year)

* PERMIT NUMBER OF ABANDONED WELL (if any) _____

* PERMIT NUMBER OF REPLACEMENT WELL: _____


* PERSON ABANDONING WELL: Andrew Hausman

WELL DRILLER'S LICENSE NUMBER:
CIRCLE: MWD / MSD / MGD

* OWNER'S NAME: Mark Carroll

SITE LOCATION MAP

* WELL LOCATION:
COUNTY: Howard
NEAREST TOWN: Ellicott City
TAX MAP 0016 BLOCK 0015 PARCEL 0244
SUBDIVISION: _____
SECTION: _____ LOT: _____
STREET ADDRESS: 11486 Frederick Rd

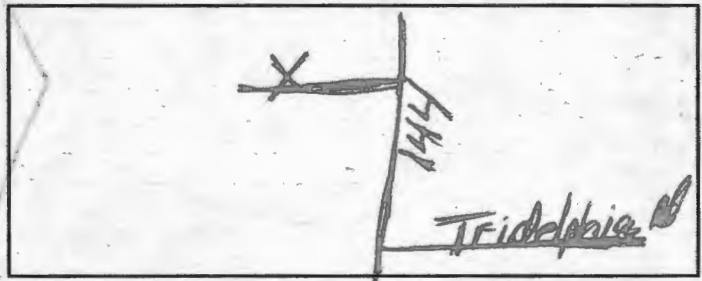

LATITUDE 39.293585

LONGITUDE 76.909965

LOG OF SEALING MATERIAL

* TYPE OF WELL BEING ABANDONED:
 DRILLED JETTED
 BORED HAND DUG
 OTHER (specify) _____

| MATERIAL | FEET | |
|------------------|-----------|----------|
| | FROM | TO |
| <u>Bentonite</u> | <u>24</u> | <u>0</u> |

* USE CODE:
 DOMESTIC MUNICIPAL/PUBLIC
 IRRIGATION INDUSTRIAL
 TEST/OBSERVATION GEOTHERMAL

VOLUME OF MATERIAL USED

* TYPE OF CASING:
 STEEL PLASTIC
 CONCRETE OTHER (specify) _____

Bentonite 450 lbs

SIZE OF CASING: 6 INCHES IN DIAMETER

DEPTH OF WELL: 24 FEET DEEP

WAS ANY CASING REMOVED? YES NO
If yes, length removed, in feet: _____

WAS CASING RIPPED OR PERFORATED? YES NO

Pursuant to § 10-624 of the State Govt. Article of the Maryland Code, personal info requested on this form is used in processing this form pursuant to COMAR 26.04.04. Failure to provide the info may result in this form not being processed. You have the right to inspect, amend, or correct this form. The Maryland Department of the Environment is subject to the Maryland Public Information Act. This form may be made available on the Internet via MDE's website and is subject to inspection or copying, in whole or in part, by the public and other governmental agencies, if not protected by federal or State Law.

SIGNATURE-MASTER WELL DRILLER OR SUPERVISING SANITARIAN LICENSE# _____

224 MWD MSD MGS
CIRCLE ONE

10-12-20 DATE

COUNTY