
 WATER WELL ABANDONMENT-SEALING REPORT FORM

SUBMIT COPIES OF COMPLETED FORM TO:

- * COUNTY ENVIRONMENTAL AGENCY (contact MDE, WMA if address needed)
- * WELL OWNER
- * MDE, WATER MANAGEMENT ADMINISTRATION, WELL PROGRAM

APPROVED
 07/21/21

DATE WELL ABANDONED: 5-07-21 (month/day/year)

* PERMIT NUMBER OF ABANDONED WELL (if any) _____


* PERMIT NUMBER OF REPLACEMENT WELL: _____

* PERSON ABANDONING WELL: Robert Copsey WELL DRILLER'S LICENSE NUMBER: 161

CIRCLE: MWD ~~MSD~~ ~~MGD~~

* OWNER'S NAME: Ronald Etue

SITE LOCATION MAP

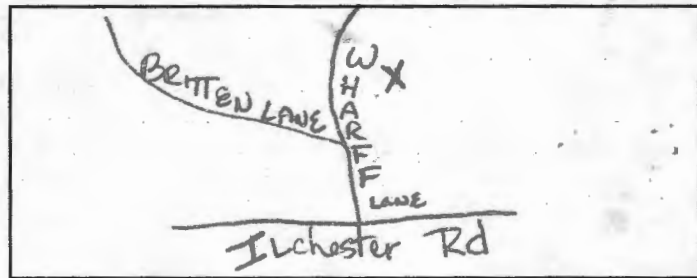

* WELL LOCATION:
 COUNTY: HOWARD County
 NEAREST TOWN: ELICOTT CITY
 TAX MAP 0031 BLOCK _____ PARCEL 0473
 SUBDIVISION: 1001
 SECTION: _____ LOT: _____
 STREET ADDRESS: 4921 NEW WINDY LANE

LATITUDE 3 9.141386

LONGITUDE 7 6.462464

LOG OF SEALING MATERIAL

MATERIAL	FEET	
	FROM	TO
<u>Bentonite clay</u>	<u>128</u>	<u>5</u>
<u>clean fill</u>	<u>5</u>	<u>0</u>
VOLUME OF MATERIAL USED		
<u>1685 #16 bentonite 3/8 pellets</u>		

* TYPE OF WELL BEING ABANDONED:
 DRILLED _____ JETTED _____
 BORED _____ HAND DUG _____
 _____ OTHER (specify) _____

* USE CODE:
 DOMESTIC _____ MUNICIPAL/PUBLIC _____
 IRRIGATION _____ INDUSTRIAL _____
 TEST/OBSERVATION _____ GEOTHERMAL _____

* TYPE OF CASING:
 STEEL _____ PLASTIC _____
 CONCRETE _____ OTHER (specify) _____

SIZE OF CASING: 6 INCHES IN DIAMETER

DEPTH OF WELL: _____ FEET DEEP

WAS ANY CASING REMOVED? YES _____ NO
 If yes, length removed, in feet: 2

WAS CASING RIPPED OR PERFORATED? _____ YES NO

SIGNATURE-MASTER WELL DRILLER OR SUPERVISING SANITARIAN LICENSE#

Robert Copsey

161

MWD / MSD / MGS
 CIRCLE ONE

5/7/21
 DATE

COUNTY

Pursuant to § 10-624 of the State Govt. Article of the Maryland Code, personal info requested on this form is used in processing this form pursuant to COMAR 26.04.04. Failure to provide the info may result in this form not being processed. You have the right to inspect, amend, or correct this form. The Maryland Department of the Environment is subject to the Maryland Public Information Act. This form may be made available on the Internet via MDE's website and is subject to inspection or copying, in whole or in part, by the public and other governmental agencies, if not protected by federal or State Law.

Ronald Etue
4921 Wharff Lane
Ellicott City

Hatfield's Equipment Inc
P O Box 519

Annapolis Junction MD 20701
Khatfield @ hatfields equipment.com
Ken Hatfield 301-490-4289

We install county water to this
house. The well was taken out of
service by Robert Copsey 5/07/21