

ASSOCIATED EXCAVATORS CONTRACTORS, LLC
16657 FREDERICK ROAD
MT. AIRY, MD 21771
(410) 442-1886 FAX (410) 442-0100

November 2, 2011


Howard County Health Department
7178 Columbia Gateway Drive
Columbia, MD 21045


To whom it may concern:

This letter is to inform you that my company pumped out and abandoned the Septic (Cesspool) located at 6460 Elibank Ellicott City, Md.

If you have any questions please call me at (410) 977.2216.

Thank you,

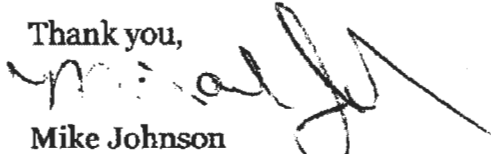
Mike Johnson

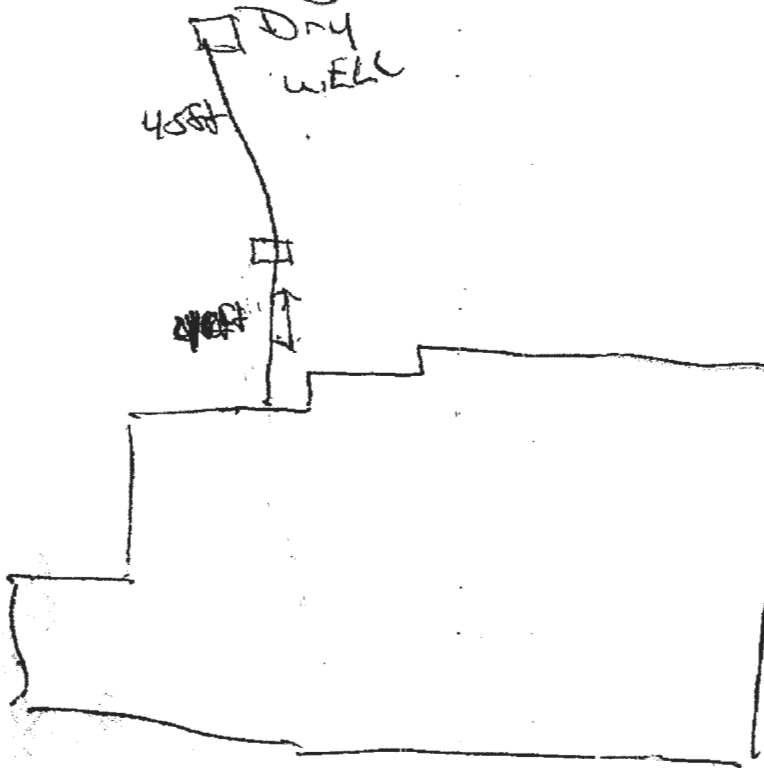

6460
Elibank

0522