

COMPLETE THIS FORM WHEN DROPPING OFF ANY CORRESPONDENCE AND/OR PLANS TO THE HOWARD COUNTY DEPARTMENT OF INSPECTIONS, LICENSES AND PERMITS COUNTER:

Date: 18 June 2020
To: ~~DILP~~ Health
From: Cindy Rosales-Cooper (301) 529 8270
Subject: Project name Above Ground Pool
Project site address 7201 Pindell School Rd, Fulton, MD 20759
Permit # B20001443 SDP #
Other information pertinent to this project

✓ Please check the attachments below that you are submitting with this transmittal:

- Letter of response to address plan review comment letter
Revised plans and/or revised details: When submitting for a complete re-review, duplicate sets shall be submitted.
Letter Summarizing Changes
Energy conservation calculations
Copies of PLOT PLAN (be specific).
Health Department Request DPZ/DED Request Applicant's Request
Two sets of single family dwelling model plans to be placed on permanent file: Model name and/or #
Other

Contact Person Information: (Required)

Cindy Rosales-Cooper
Please Print Name Telephone No: 301 529 8270
E-Mail Address: CRCcooper77@yahoo.com

*Note: J. Williams asked me to submit the survey w/ pool location showing the septic drywell.

PLEASE ASSURE ALL DOCUMENTS AND/OR REVISIONS ARE APPROPRIATELY SIGNED AND SEALED, IF NECESSARY, BY A LICENSED ARCHITECT OR ENGINEER. PLEASE BE ADVISED THAT INSUFFICIENT INFORMATION MAY RESULT IN THE DELAY OF REVIEW BY THE PLANS EXAMINER. THE DEPARTMENT OF INSPECTIONS, LICENSES AND PERMITS WILL CONTACT YOU IF THERE IS A PROBLEM. IN ADDITION, ONCE THE BUILDING PERMIT IS APPROVED BY THE PLAN REVIEW DIVISION AND ALL OTHER REQUIRED SIGNATORY AGENCIES, AND THE BUILDING PERMIT IS READY FOR ISSUANCE, THE PERMIT DIVISION WILL NOTIFY THE APPROPRIATE CONTACT PERSON FOR PERMIT PICK UP. ALL PERMIT STATUS INQUIRIES SHALL BE DIRECTED TO THE PERMIT DIVISION AT 410-313-2455. CODE RELATED QUESTIONS AND PLAN REVIEW INQUIRIES SHALL BE DIRECTED TO THE PLAN REVIEW DIVISION AT 410-313-2436. PLEASE ALLOW A MINIMUM OF FIVE (5) WORKING DAYS FOR ANY PLAN SUBMITTALS TO BE REVIEWED. THANK YOU.


RECEIVED

JUN 19 2020

LICENSES & PERMITS DIVISION

Received by DROPBOX


too big to scan

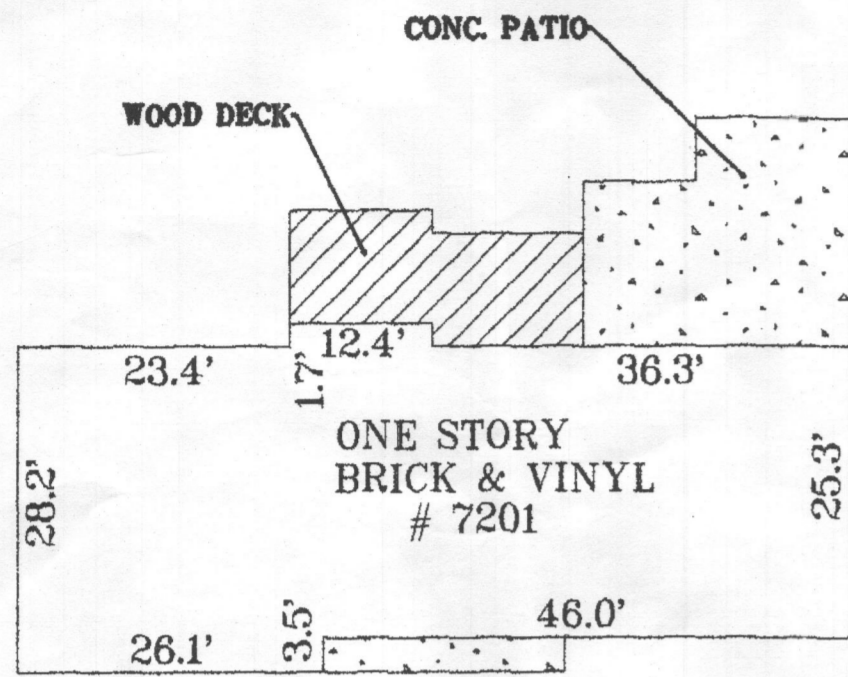

HOUSE DETAILS
NO SCALE

GENERAL NOTES

1. I.P.F DENOTES IRON PIPE FOUND.
2. I.P.S. DENOTES IRON PIPE SET.
3. THE MAIN PURPOSE OF THIS SURVEY IS TO LOCATE THE THREE TREES THAT WERE CUT DOWN BY BG&E, AN EXELON COMPANY.
4. PLEASE SEE DETAIL OF EXISTING TREE STUMPS AS TO THEIR LOCATIONS.
5. THIS SYMBOL INDICATES EXISTING TELEPHONE AND POWER POLES.

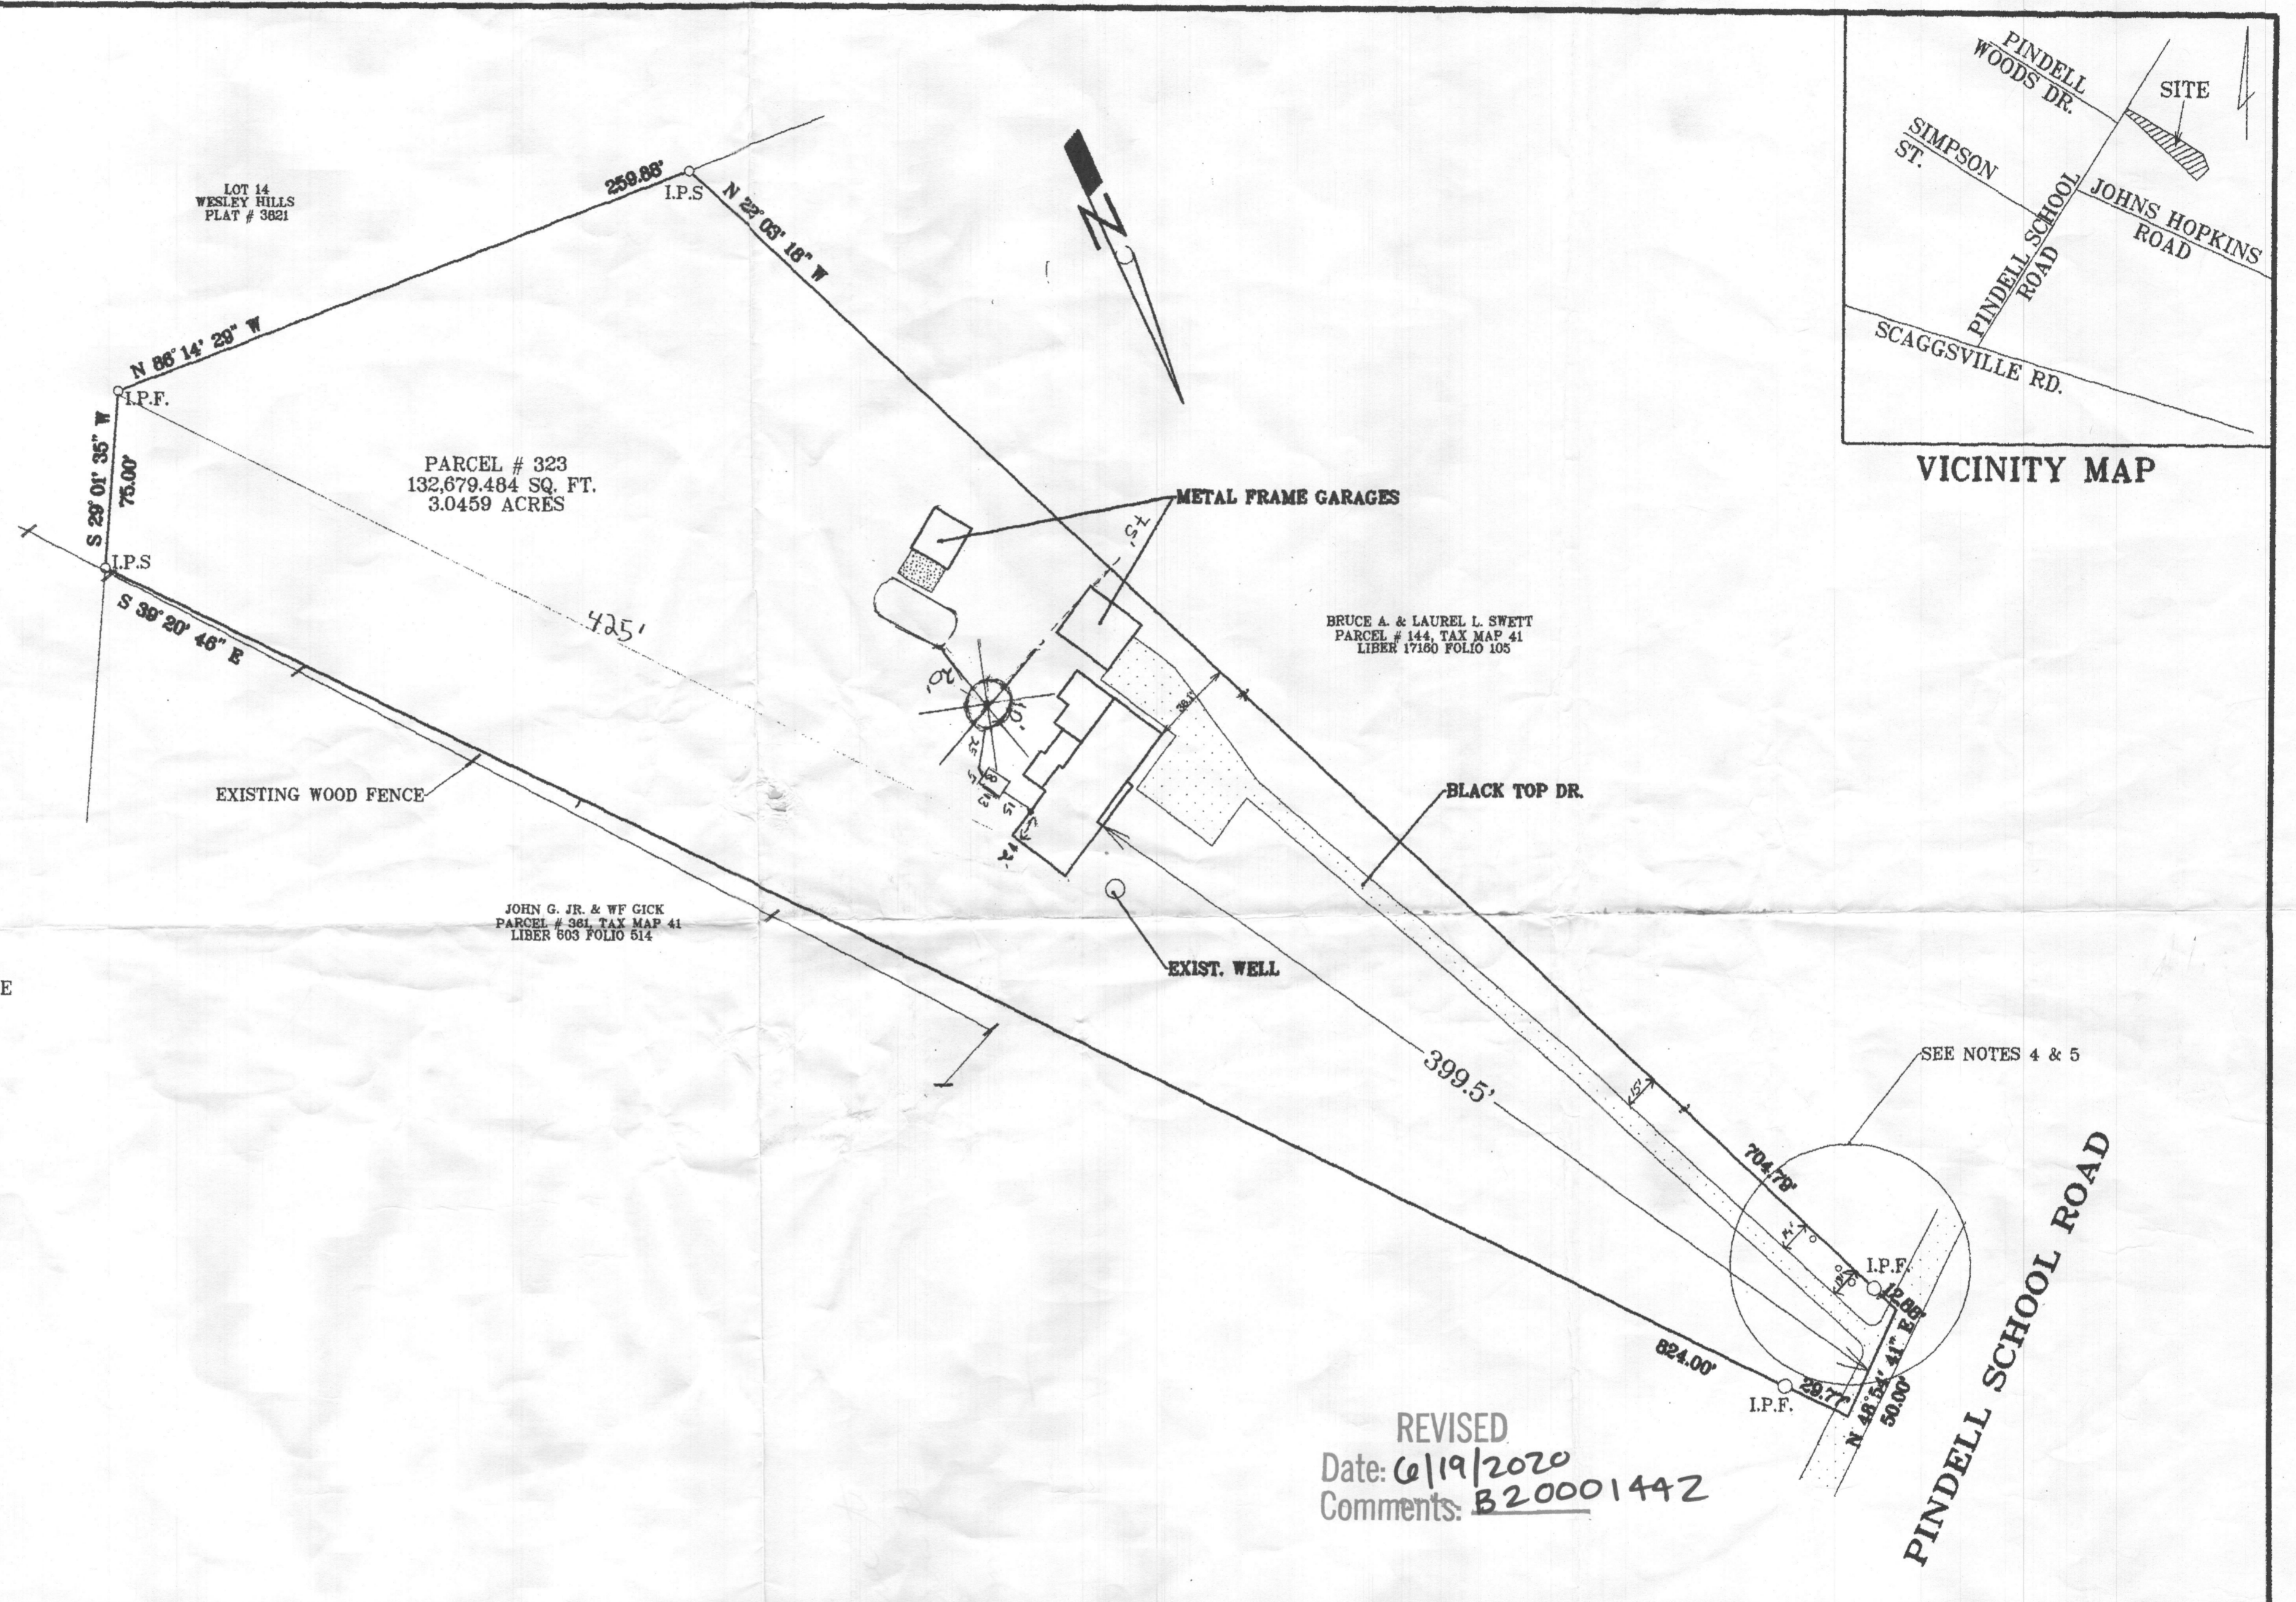

REVISED
Date: 6/19/2020
Comments: B20001442

NOTE: LICENSE NO. 574
EXPIRATION DATE 03/21/19

MARYLAND LAND SURVEYING
CONSULTING LAND SURVEYORS AND PLANNERS
9890 LYON AVENUE
LAUREL, MARYLAND 20723
(301) 206-2258

SURVEYOR'S CERTIFICATION

I HEREBY CERTIFY THAT THE PROPERTY DELINEATED HEREON IS IN ACCORDANCE WITH THE PLAT OF SUBDIVISION AND DEED OF RECORD AND THAT THE IMPROVEMENTS SHOWN WERE LOCATED BY ACCEPTED FIELD PRACTICES. THIS BOUNDARY SURVEY IS FOR THE DETERMINING PROPERTY LINES, AND NO TITLE REPORT WAS FURNISHED TO THIS SURVEYOR, AND LOT CORNERS HAVE BEEN SET BY THIS SURVEY.



BOUNDARY SURVEY
FOR
CINDY E. ROSALES-COOPER & BENJAMIN MASON COOPER
LIBER 17337, FOLIO 287
TAX MAP 41, PARCEL 323
ELECTION DISTRICT 5
RECORDED IN HOWARD COUNTY, MARYLAND
7201 PINDELL SCHOOL ROAD

DATE 10/13/17
SCALE 1" = 50'
CHECKED BY
DRAWN BY
DESIGNED BY
SHEET
1 OF 1