

FILE INQUIRY NOTES

DATE	RESULTS OF REVIEW FOR FILE
7/10/17	Site visit to verify stake. Two stakes in front yard - homeowner Mark on site, says either stake is preferred location. Check records of surrounding properties for neighboring septic systems. (SC)
7/11/17	Records show that septic system of 3657 Daisy Rd. (across street) is close to road, proposed replacement well locations would be downstream of septic. No records for 3654 Daisy Rd - found septic in front yard, also upstream of stakes. Homeowner Jennifer on site - discussed possibly drilling in backyard. She wants the garage to take up almost whole area behind driveway + above dog fence. Possibly place well inside fence if septic at 3656 Daisy Rd. is not close. (SC)
7/13/17	Met Andy from Fogle's and Jennifer on site. Tried to locate trench on property - found some mounding in the yard but couldn't determine exact location. Located approx. edge of garage + pulled 30' off foundation, 10' off prop. line + found a spot that could be 90' from septic. I urged the homeowners to submit garage plans for a building permit so that we know the well meets 30' setback - Jennifer said it's not in their budget right now, + garage will not be built if new well is not successful. (SC)
9-11-17	Spoke with Mr. Marks. He is preparing a permit for this property and need me to send him information on procedure and setbacks.


Phone # (410) 368-3668

3-27-18 Spoke with Richard. He has been hired to complete work. Dream Design Build. Emailed set backs and request WB

From: Mark Daniels mdaniels2940@gmail.com

Date: Jun 10, 2018 at 1:47:24 PM


To: Mark Daniels mdaniels2940@gmail.com

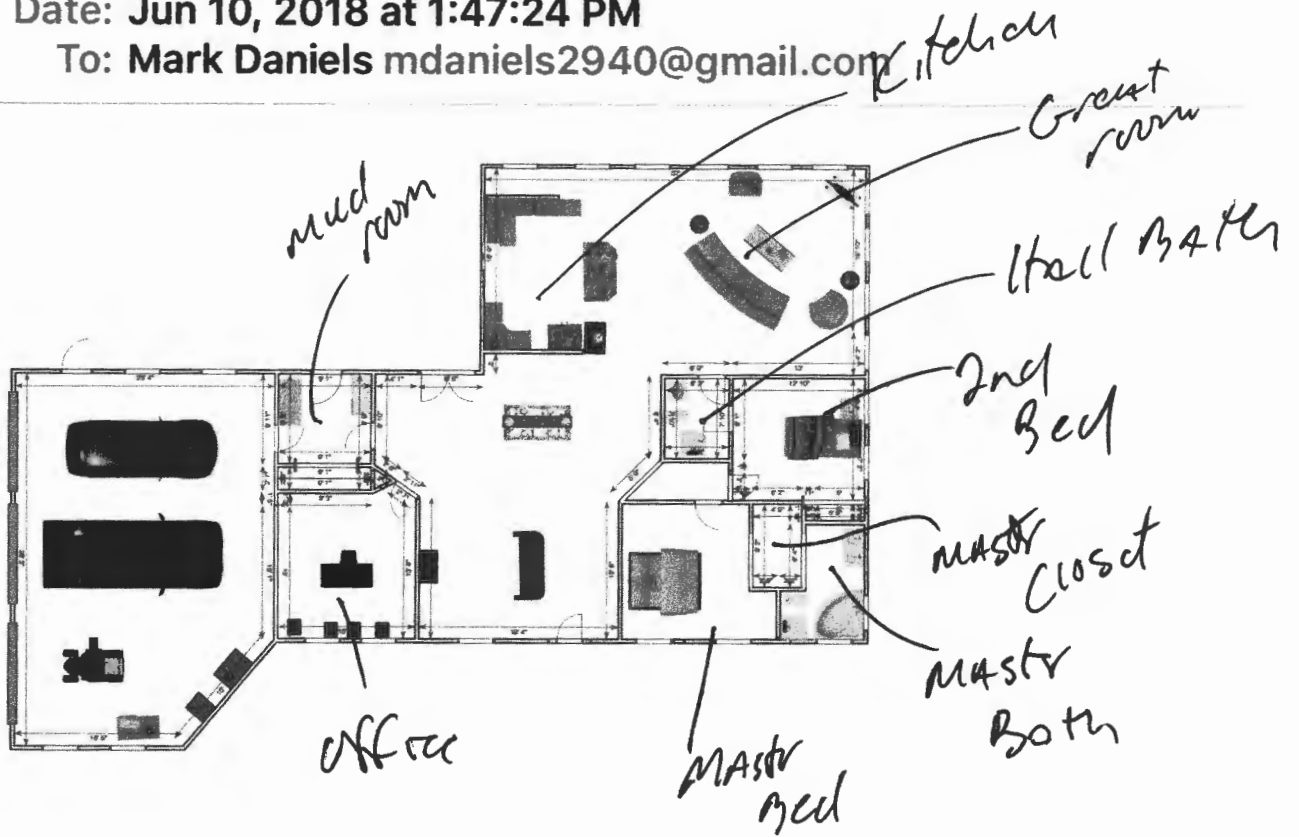

From: Mark Daniels mdaniels2940@gmail.com

Date: Jun 10, 2018 at 1:47:01 PM

To: Mark Daniels mdaniels2940@gmail.com

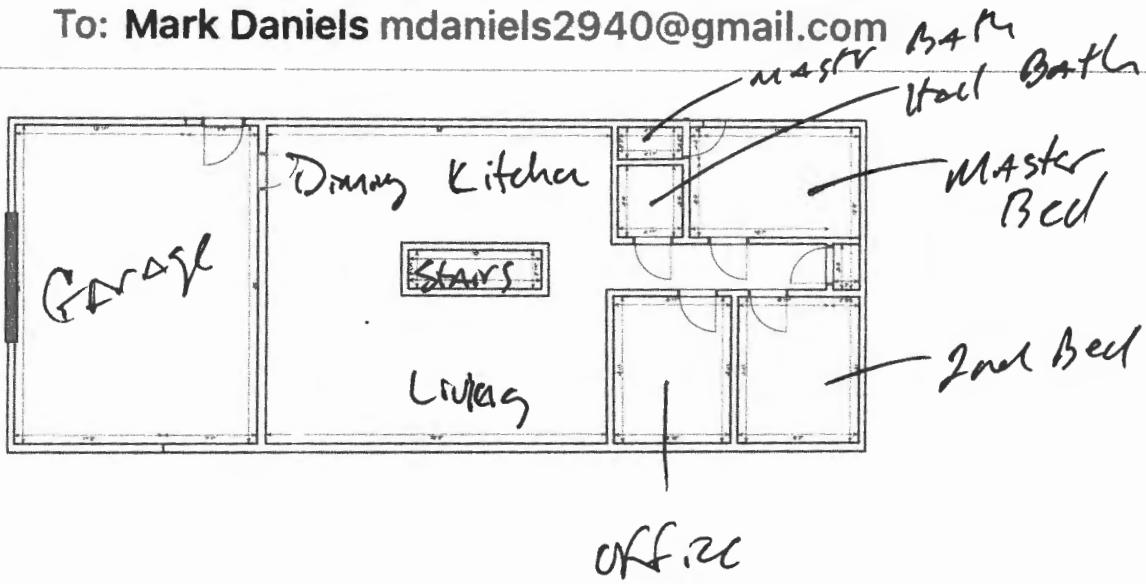

30-
35-0"
M.S.M.

New
plans
Copper
wall

36-0
Bathroom wall on

5'
24.0

4113-
if not shown

11
Walls fine - 6/11/82

was Dickerson

Keyed

25 set of

← Lower
open

← Lower

