

10/13/18

Site visit.

John Hidey of inspections present.

He informed me prop. conn. to pub. sewer 6.22.10. Construction did the work. Connected

to public water 10/18. He just signed off. Spoke

to owner who said that tank was crushed

time of connection. well about. to follow H.O.

Posts are triple 2x6


All material is pressure treated

New footers shown with x-box

All footers are 16" round, 10" thick and 30" below grade

Triple 2x6 header on the shorter spans

Double 2 x12 header on this span

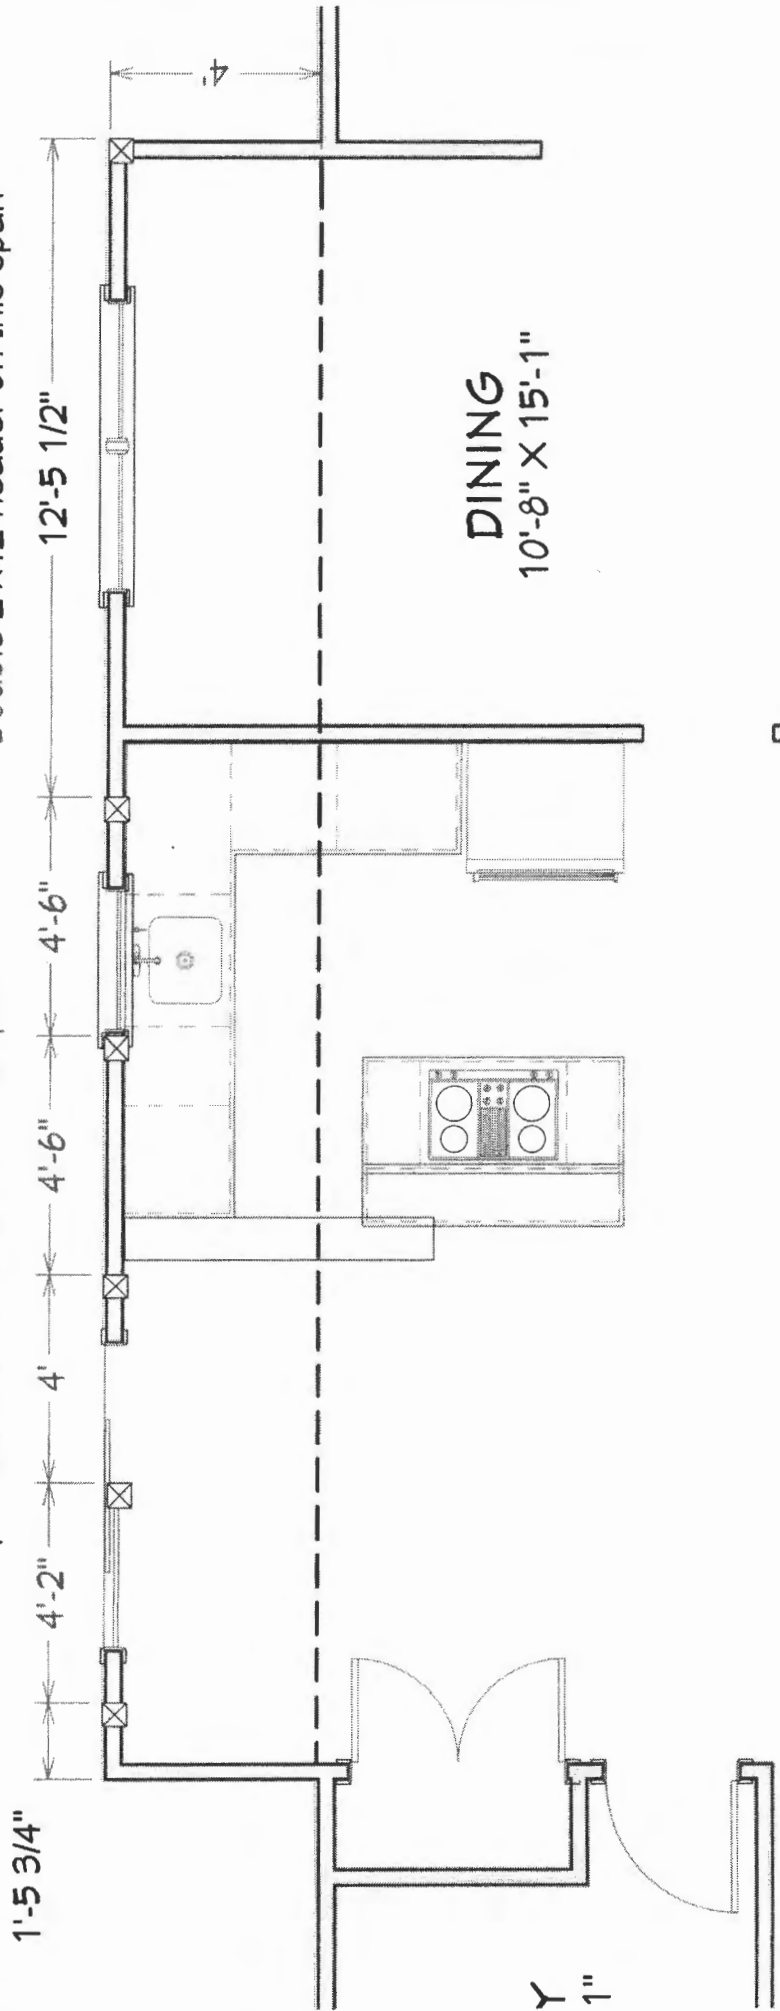

SLDA REQUIREMENTS

TOTAL DIRT MOVEMENT _____ CU FT
 (UNDER 1000 CU FT)
 (UNDER 2,700 CU FT) sec 19.2
 TOTAL NEW IMPERVIOUS AREA 1184 SQ FT
 (UNDER 1,200 SQ FT)
 TOTAL DISTURBED DIRT 4000 sq ft
 (UNDER 20,000 SQ FT)
 (UNDER 5,000 SQ FT) sec 19.2

PROJECT INFORMATION


DONALD MURPHY GARAGE ADDITION
 address 18019 SHAFFERS MILL ROAD
 MT AIRY MD 21771-3119
 LOT _6_ BLOCK _B_
 LIBER 615__ FOLIO-440
 PARCEL 0171
 LOT AREA 3.0000 AC
 ZONING RC-DEO

DESIGN CRITERIA

CODE 2015 INTERNATIONAL RESIDENTIAL CODE
 USE GROUP
 CONST. TYPE.
 SQ FOOTAGE 1184 SQ FT NEW space
 LIVE LOADS:
 GROUND SNOW LOAD 30 PSF
 SOIL CAPACITY 2000 PSF MIN
 SOIL LATERAL PRESSURE 45 PCF.
 FROST LINE DEPTH 30"
 WIND SPEED 90 MPH
 WINTER DESIGN TEMP: 13 DEG. F
 SPRINKLER SYSTEM NO
 FIRE ALARM SYSTEM NO

DRAWING INDEX

- ITEM-SHEET
- 1 COVER SHEET
 - 1-1 SIGHTPLAN
 - 1-2 RIGHT ELEV
 - 2-2 BACK ELEVATION
 - 3-2 RIGHT ELEV
 - 4-2 FRONT ELEVATION
 - 1-3 SECTION & DETAILS
 - 1-4 1ST FLR FRAMING PLAN
 - 2-4 FOUNDATION PLAN
 - 1-5 ROOF TRUSS LAYOUT

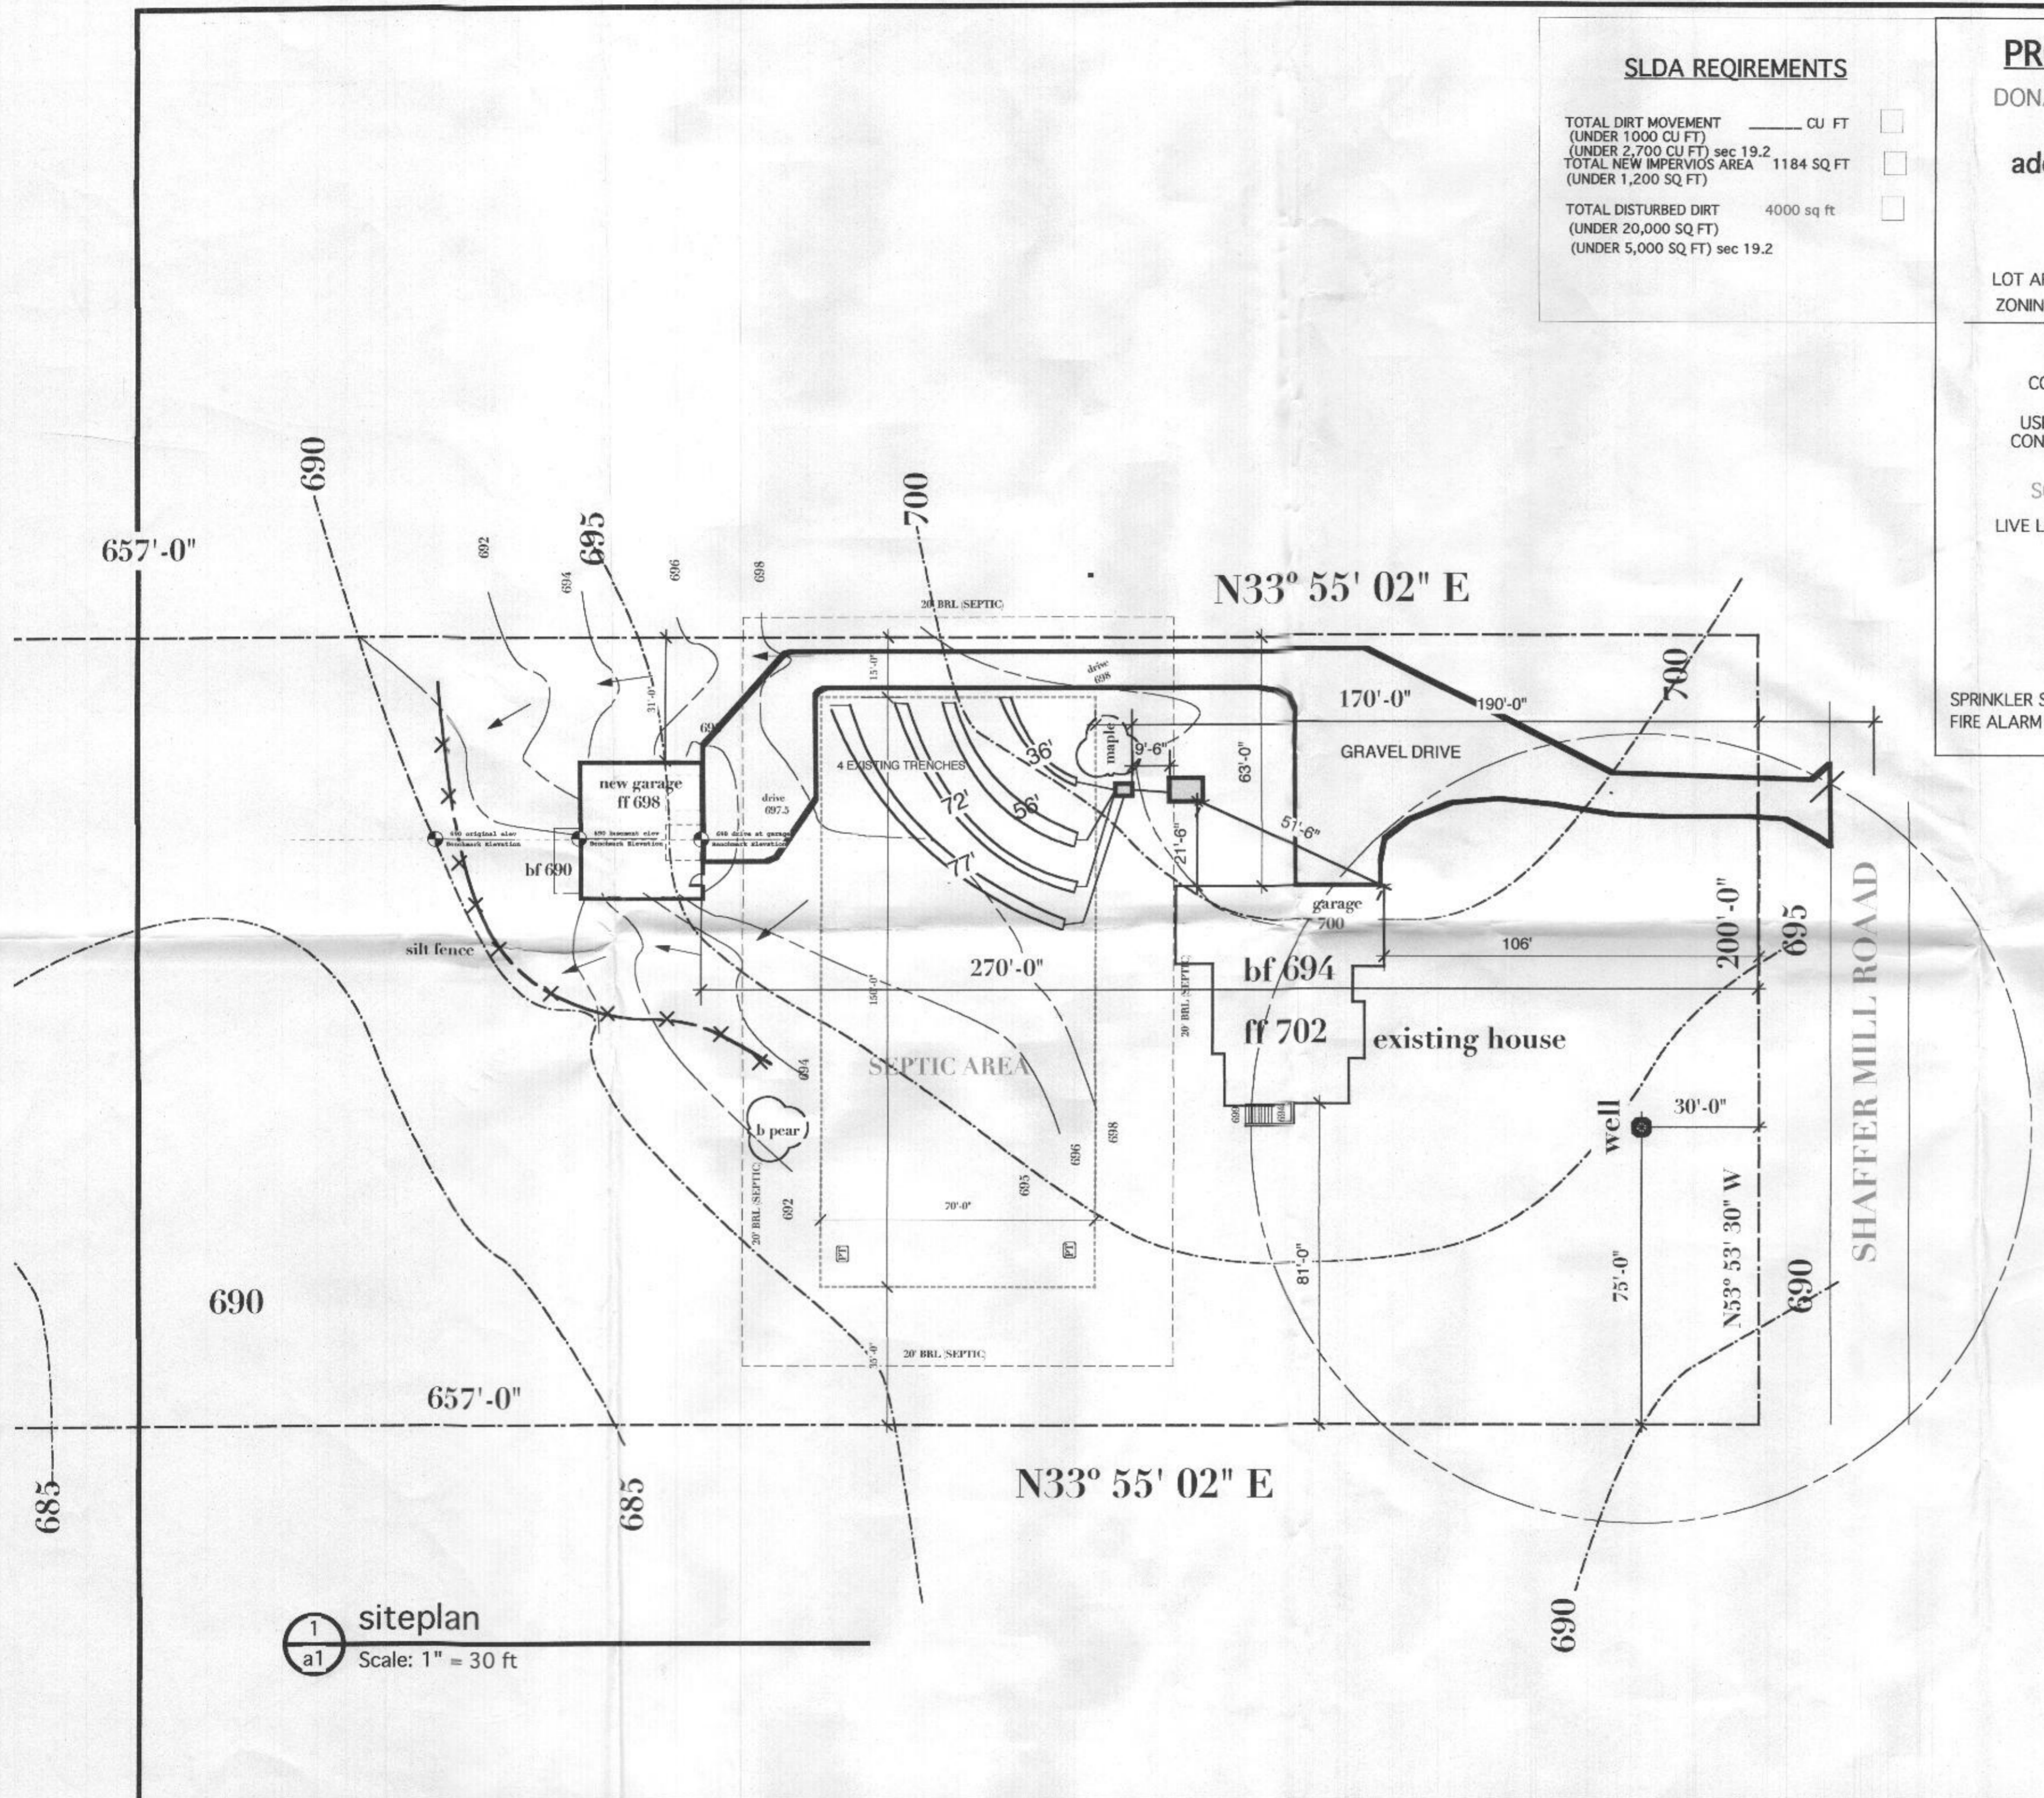

1 siteplan
 a1 Scale: 1" = 30 ft

10/1/18 - Site plan
 approved as shown
 for B18051719
 (detached garage)
 -H.O.

DONALD MURPHY
 GARAGE ADDITION

SLDA REQUIREMENTS

TOTAL DIRT MOVEMENT _____ CU FT
 (UNDER 1000 CU FT)
 (UNDER 2,700 CU FT) sec 19.2
 TOTAL NEW IMPERVIOUS AREA 1184 SQ FT
 (UNDER 1,200 SQ FT)
 TOTAL DISTURBED DIRT 4000 sq ft
 (UNDER 20,000 SQ FT)
 (UNDER 5,000 SQ FT) sec 19.2

PROJECT INFORMATION


DONALD MURPHY GARAGE ADDITION
 18019 SHAFFERS MILL ROAD
 address MT AIRY MD 21771-3119
 LOT _6_ BLOCK _B_
 LIBER 615_ FOLIO-440
 PARCEL 0171
 LOT AREA 3.0000 AC
 ZONING RC-DEO

DESIGN CRITERIA

CODE 2015 INTERNATIONAL RESIDENTIAL CODE
 USE GROUP
 CONST. TYPE.
 SQ FOOTAGE 1184 SQ FT NEW space
 LIVE LOADS:
 GROUND SNOW LOAD 30 PSF
 SOIL CAPACITY 2000 PSF MIN
 SOIL LATERAL PRESSURE 45 PCF..
 FROST LINE DEPTH 30"
 WIND SPEED 90 MPH
 WINTER DESIGN TEMP: 13 DEG. F
 SPRINKLER SYSTEM NO
 FIRE ALARM SYSTEM NO

DRAWING INDEX

- ITEM-SHEET
- 1 COVER SHEET
 - 1-1 SIGHTPLAN
 - 1-2 RIGHT ELEV
 - 2-2 BACK ELEVATION
 - 3-2 RIGHT ELEV
 - 4-2 FRONT ELEVATION
 - 1-3 SECTION & DETAILS
 - 1-4 1ST FLR FRAMING PLAN
 - 2-4 FOUNDATION PLAN
 - 1-5 ROOF TRUSS LAYOUT

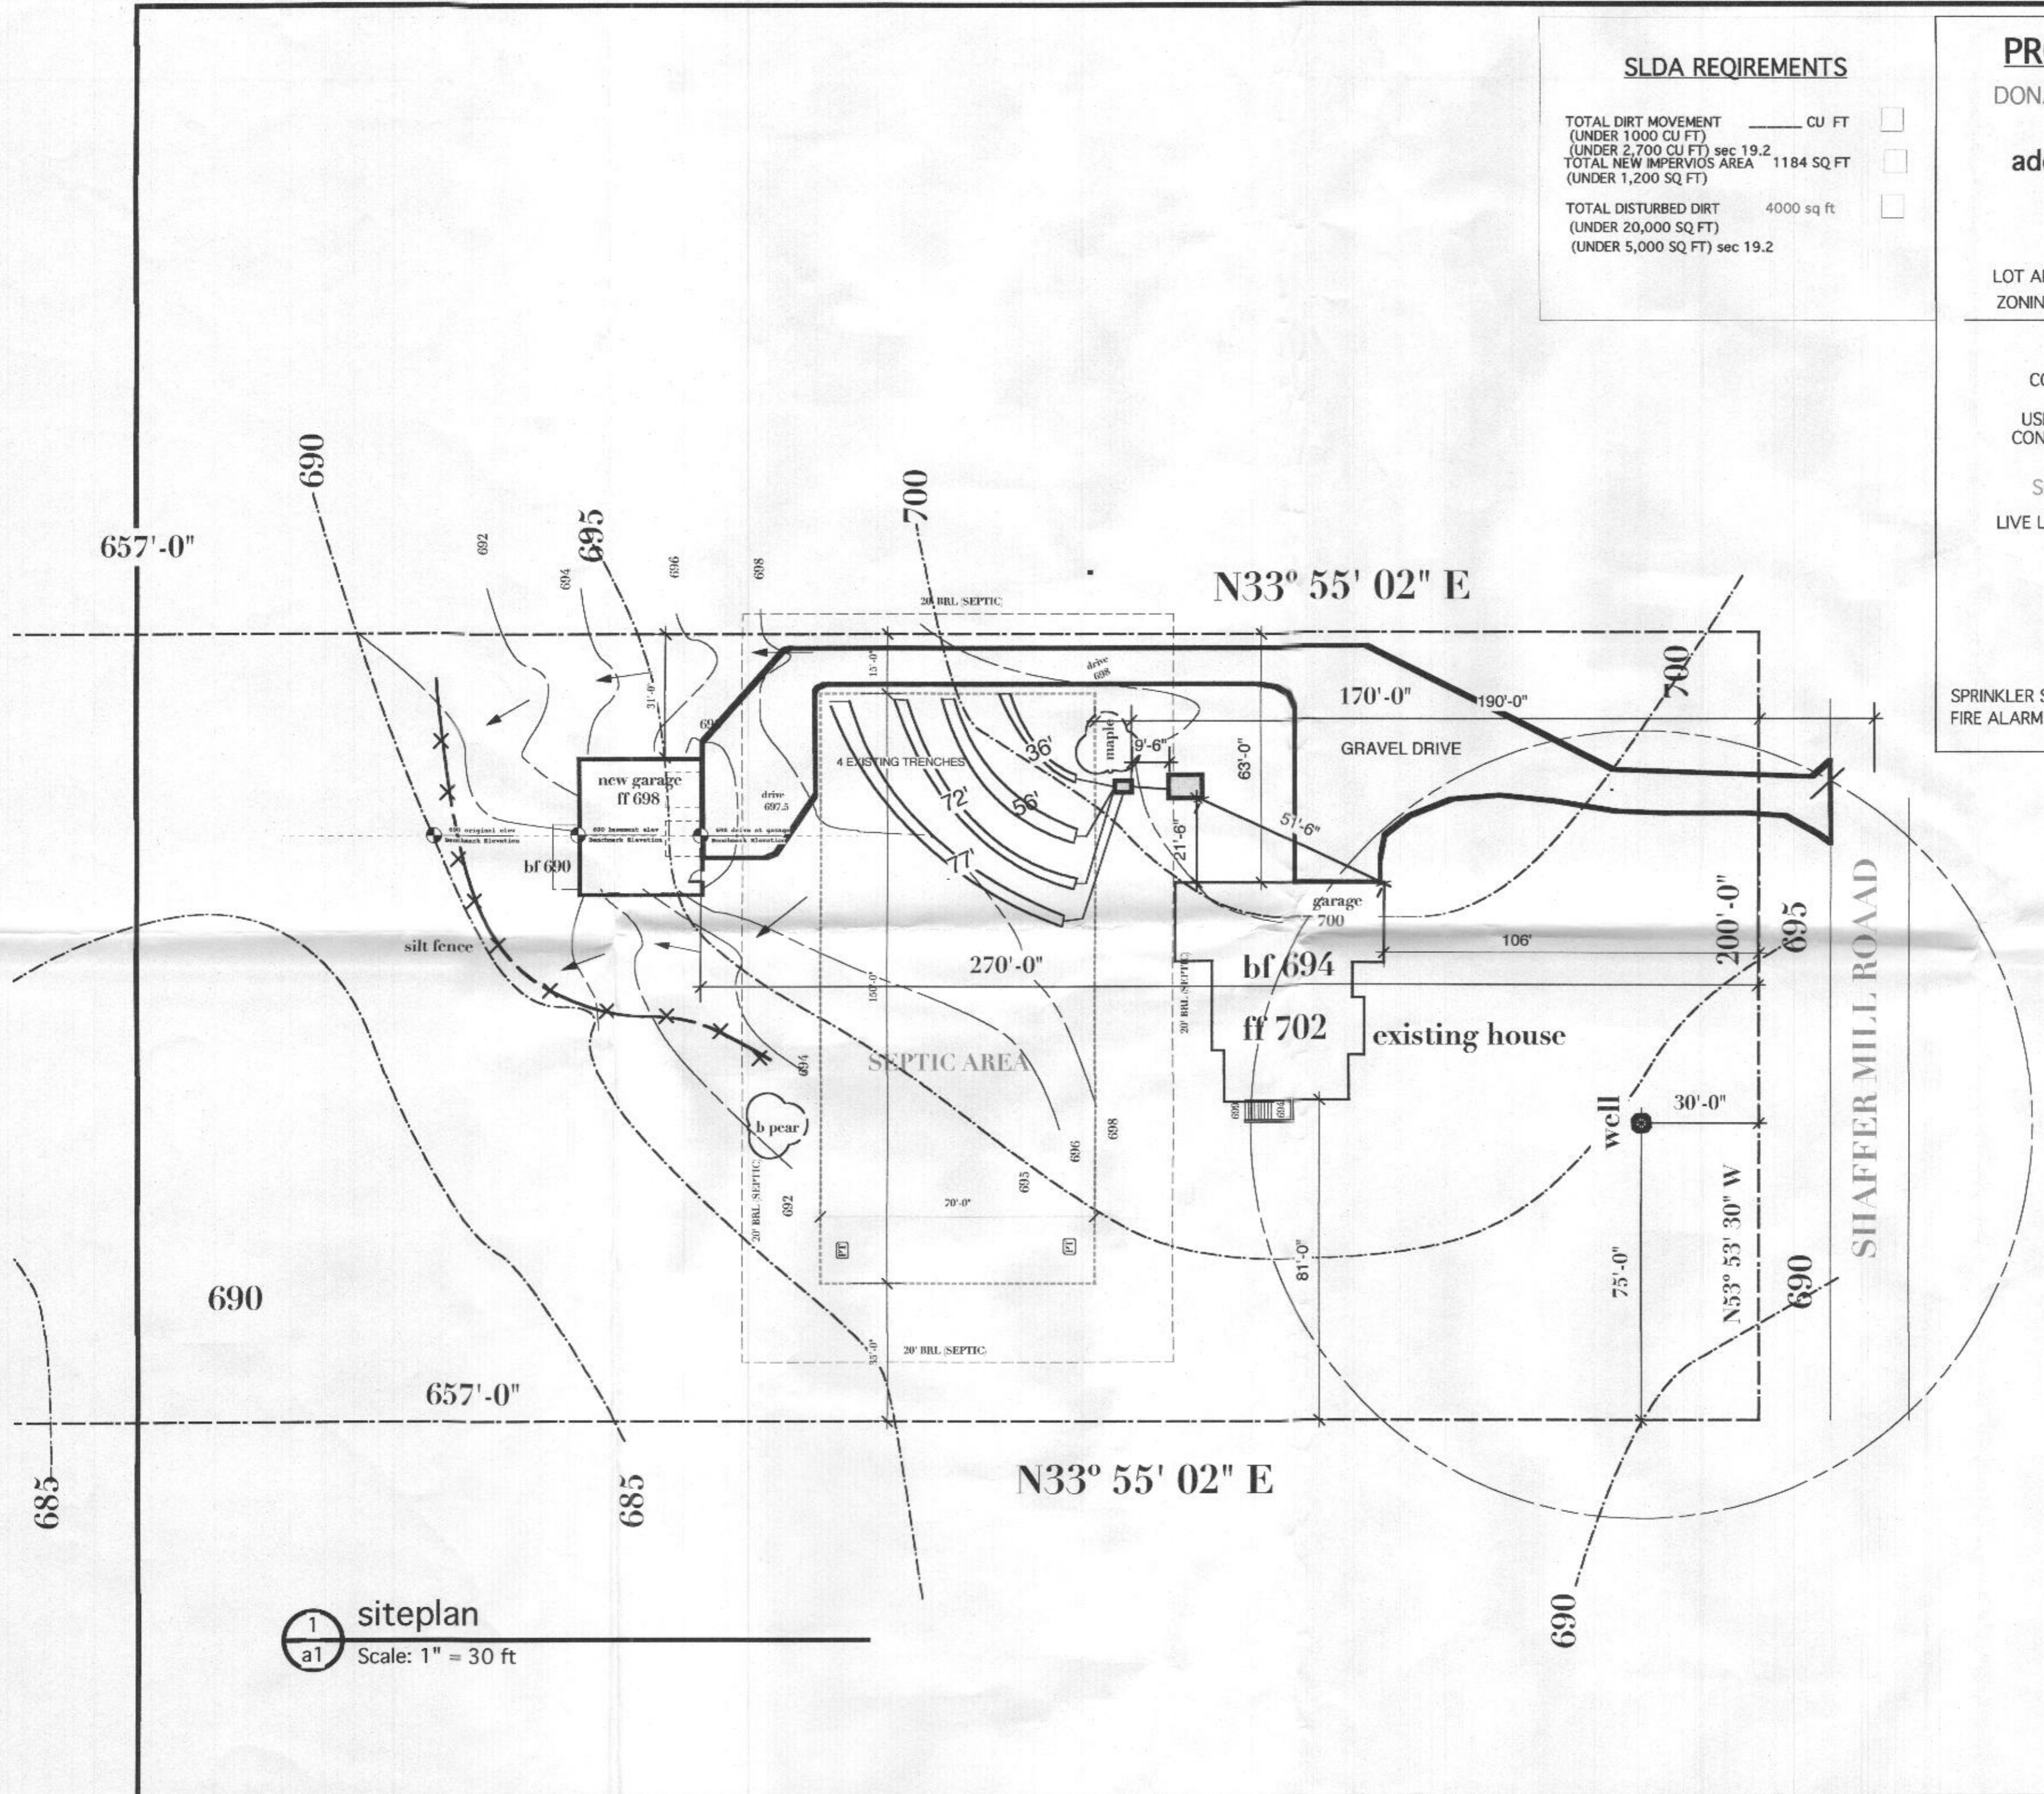

1 siteplan
 a1 Scale: 1" = 30 ft

10/1/18. Site plan approved as shown for B18001719 (detached garage) L.H.O.

DONALD MURPHY GARAGE ADDITION