


Building Restriction Line:
 Front... 50'
 Sides... 10' & 20'
 Rear... 30'

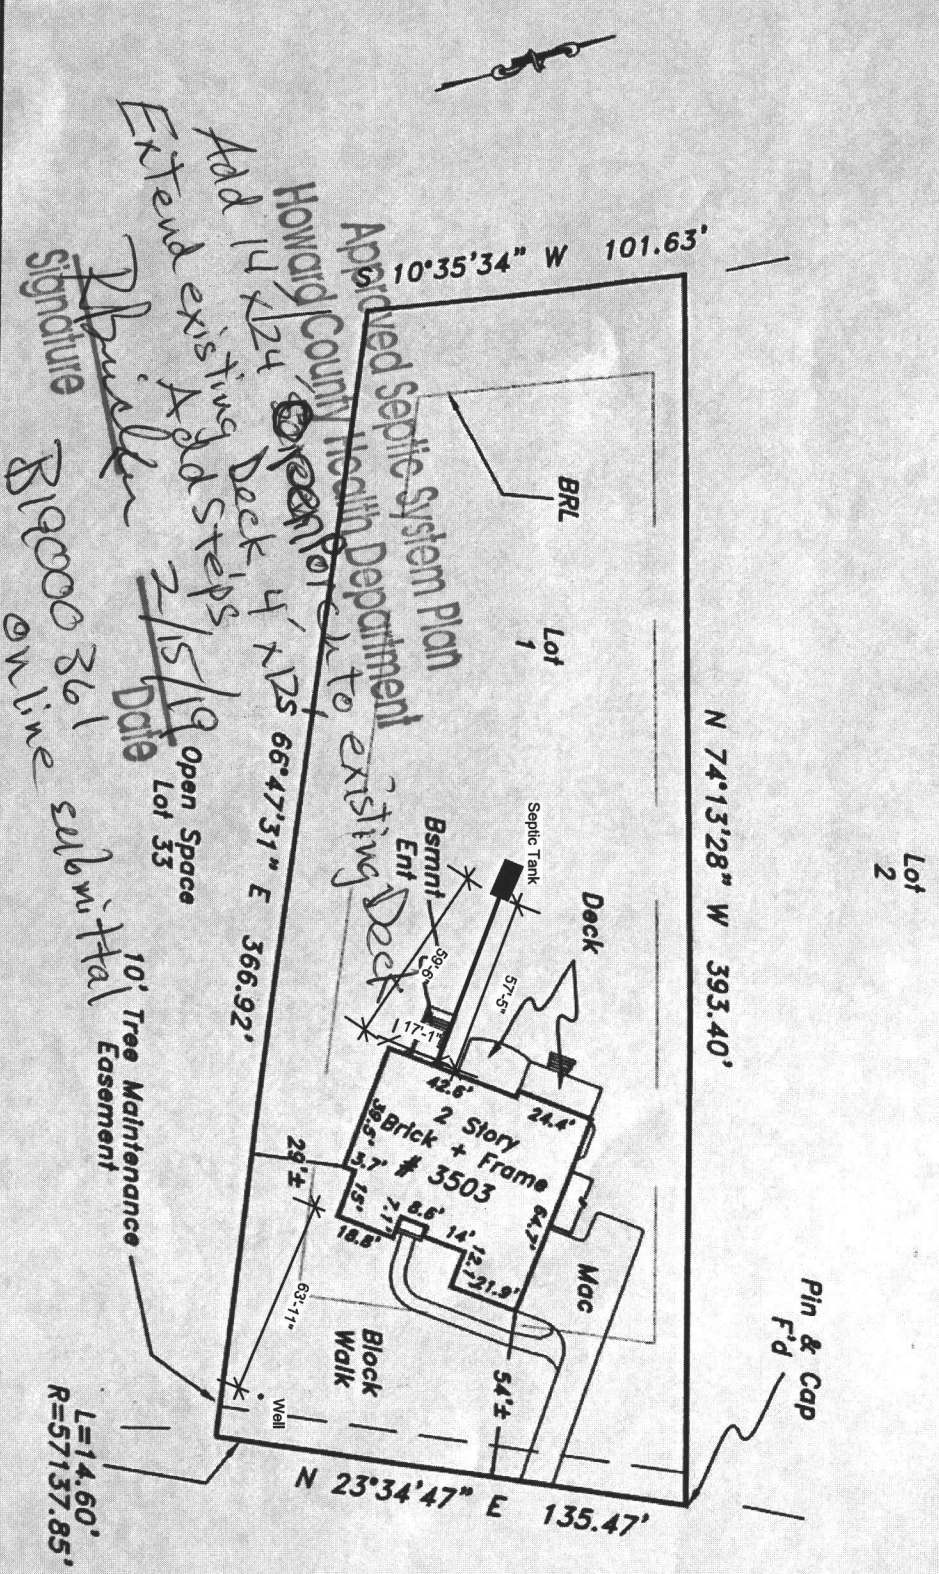

Snow Chief Road

The purpose of this drawing is to locate, describe, and represent the positions of buildings and substantial improvements affecting the property shown hereon, being known as:
 Lot 1,
 THE PADDOCKS
 recorded among the land records of Howard County, Maryland in Plat 14482

PREPARED FOR:



SAGE TITLE GROUP
 THE WISE CHOICE

This is page one of a two page document. The advice found on the affixed page is an integral part of this drawing, and is not valid without all pages.



LOCATION DRAWING
 3503 Snow Chief Road
 3RD ELECTION DISTRICT
 HOWARD COUNTY, MARYLAND

NTT Associates, Inc.
 16205 Old Frederick Rd.
 Mt. Airy, Maryland 21771
 Phone: (410) 442-2031
 Fax: (410) 442-1315
 www.nttsurveyors.com

Scale:	1" = 60'
Date:	4-28-16
Field By:	DR
Drawn By:	DR
File No.:	172556NRS
Page No.:	1 of 2

3503 Snow Chief Rd.
B19000361
online submission

Menu Save Reset Cancel Help

Record Detail * (This section is required.)

Permit Type	Permit Number	Opened Date
Building/Residential/Misc/Porch	B19000361	02/12/2019
Description of Work		
SFD/ ADD 14' X 24' OPEN PORCH TO EXISTING DECK, EXTEND EXISTING DECK 4' X 12' & ADD STEPS		

[check spelling](#)

Address * (This section is required.)

Search Reset Clear Get Parcel & Owner

Street #	Street Name	Street Type	
3503	SNOW CHIEF	RD	
Unit Type	Unit #	X Coordinate	Y Coordinate
--Select--		-76.99059	39.27381
City	State	Zip Code	Primary
GLENELG	MD	21737	Yes

Parcel * (This section is required.)

Search Reset Clear Get Address & Owner

GIS ID *	Parcel	Parcel Area	Land Value	Improved Value	Exemption Value	Plan Area
891747	141	1.08	212700	1054700	842000	RURAL
Legal Description						
IMPSLOT 1 1.089 A.[]3503 SNOW CHIEF RD[]THE PADDOCKS						

[check spelling](#)

Block	Lot	Census Tract	Council Dist	Supervisor Dist	Map #	DAP Zone	Primary
9999	1	603000	5				Yes
Plan Area	State Tax Id	Subdivision Name					
	1403332829	THE PADDOCKS					
Section	Area	Tax Map					
		22					
Grid	Zoning District	ADC Map					
22-7	RR-DEO	4813-B7					
SDP No.	Final Plan No.	WP File No.					
Record Plat No.	WS Contract No.	FDP No.					
14482							
Owner Occupied	Year Built	Historic District					
<input type="radio"/> Yes <input type="radio"/> No	2001	<input type="radio"/> Yes <input checked="" type="radio"/> No					
Historic District Registry No.	Stat Area	Flood Plain					
	3-04	<input type="radio"/> Yes <input checked="" type="radio"/> No					
Building No							

3503 Snow Chief Rd
 B 19000361
 Online submittal

Owner * (This section is required.)

Search Reset Clear

Name *

STEVEN DEVORE		
Address Line 1		
3503 SNOW CHIEF RD		
Address Line 2		
Address Line 3		
Mail City	Mail State	Mail Zip Code
GLENELG	MD	21737
Phone	Primary	
443-866-0757	Yes	
E-mail		
Cell Number	Fax Number	

Professionals (This section is not required.)

Search Reset Clear

License # *	Business Name		
08010020247	PRO BUILT CONSTRUCTION		
License Type *	First Name	Middle Name	Last Name
MHIC Ind	EDWARD		PACYLOWSKI
Primary	Address Line 1		
No	13330 CLARKSVILLE PIKE		
Address Line 2			
City		State	ZIP Code
HIGHLAND		MD	20777-9701
Phone 1	Phone 2	Fax	
3018540821		3018549632	
E-mail			
EDWARD@PROBUILTCONSTRUCTION.COM			

Applicant (This section is not required.)

Search As Owner As Lic. Prof As Contact

Type *	First Name	MI	Last Name
Applicant	EDWARD		PACYLOWSKI
Relationship	Full Name		
Applicant	EDWARD PACYLOWSKI		
Primary	Organization Name		
Yes	PRO BUILT CONSTRUCTION		
Street Address			
13330 CLARKSVILLE PIKE			
Address Line 2			
City		State	Zip Code
HIGHLAND		MD	20777-9701
Phone	Cell	Fax	
3018540821		3018549632	
E-mail *			

EDWARD@PROBUILTCONSTRUCTION.COM

3503 Snow Chief
B19000361
online submittal

Addtl Info

Est Construction Cost *	Housing Units *	Number of Buildings *	Public Owned
25000	0	0	No
Construction Type			
--Select--			

PORCH INFORMATION

PORCH INFORMATION

Capital Project-No Fee *	Capital Project Number	Fee Exempt *	Roadside Tree Project Permit *	Roadside Tree Project Permit #
<input type="radio"/> Yes <input checked="" type="radio"/> No		<input type="radio"/> Yes <input checked="" type="radio"/> No	<input type="radio"/> Yes <input checked="" type="radio"/> No	
Existing Use *	Type of Porch *	Type of Porch Foundation *	Total Square Footage *	
SFD	Open Porch	Existing Deck	336 SQFT	
Water Supply	Sewage Disposal	Expiration Date		
Private	Private	8/14/2019		

PAYMENT INFORMATION

Check 1	Payee 1	Check 2	Payee 2	SAP Doc No	SAP Entered

Submit Cancel