

MARYLAND DEPARTMENT OF THE ENVIRONMENT, WATER MANAGEMENT ADMINISTRATION  
2500 BROENING HIGHWAY, BALTIMORE, MARYLAND 21224, (410) 631-3784

\*\*\*\*\*  
WATER WELL ABANDONMENT-SEALING REPORT FORM  
\*\*\*\*\*

SUBMIT COPIES OF COMPLETED FORM TO:

- \* COUNTY ENVIRONMENT AGENCY (contact MDE, WMA if address needed)
- \* WELL OWNER
- \* MDE, WATER MANAGEMENT ADMINISTRATION, WELL PROGRAM

DATE WELL ABANDONED: 8/30/02 (month/day/year)

\* PERMIT NUMBER OF ABANDONED WELL (if any) \_\_\_\_\_


\* PERMIT NUMBER OF REPLACEMENT WELL - Public Water Conn.

\* PERSON ABANDONING WELL: Ed Linsenmeyer WELL DRILLERS LICENSE NUMBER: \_\_\_\_\_

\* OWNER'S NAME: Ross

CIRCLE: MWD/MSD/MGD

\* WELL LOCATION: 10332 Route 99 (Old Frederick)  
 COUNTY: HOWARD  
 NEAREST TOWN: WOODSTOCK  
 TAX MAP 17 BLOCK \_\_\_\_\_ PARCEL 1166  
 SUBDIVISION: None  
 SECTION: \_\_\_\_\_ LOT: \_\_\_\_\_  
 NEAREST ROAD: OLD FREDERICK

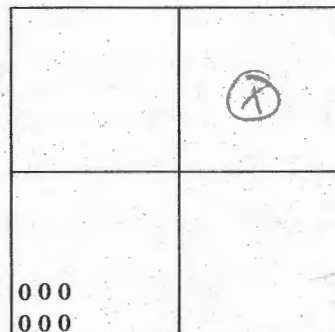

000  
000

SHOW WELL LOCATION BY X WITHIN BOX

MARYLAND GRID COORDINATES

BOX NUMBER  
 E 837  
 N 537

\* TYPE OF WELL BEING ABANDONED:

- \_\_\_\_\_ DRILLED
- \_\_\_\_\_ BORED/AUGURED
- \_\_\_\_\_ OTHER (specify) \_\_\_\_\_
- \_\_\_\_\_ JETTED
- X HAND DUG

\* USE CODE:

- X DOMESTIC
- \_\_\_\_\_ IRRIGATION
- \_\_\_\_\_ TEST/OBSERVATION
- \_\_\_\_\_ MUNICIPAL/PUBLIC
- \_\_\_\_\_ INDUSTRIAL

\* TYPE OF CASING:

- \_\_\_\_\_ STEEL
- \_\_\_\_\_ CONCRETE
- \_\_\_\_\_ PLASTIC
- ✓ OTHER (specify) Rock

\* SIZE OF CASING: 4 1/2 INCHES IN DIAMETER

\* DEPTH OF WELL: 42 FEET DEEP

\* WAS ANY CASING REMOVED? \_\_\_\_\_ YES \_\_\_\_\_ NO  
 if yes, length removed, in feet: \_\_\_\_\_

\* WAS CASING RIPPED OR PERFORATED? \_\_\_\_\_ YES  NO

LOG OF SEALING MATERIAL

| MATERIAL          | FEET                   |           |
|-------------------|------------------------|-----------|
|                   | FROM                   | TO        |
| <u>fine sand</u>  | <u>38</u><br><u>42</u> | <u>4'</u> |
| <u>Cement cap</u> | <u>4'</u>              | <u>2'</u> |
| <u>Backfill</u>   | <u>2'</u>              | <u>0</u>  |

SIGNATURE-Master Well Driller OR SUPERVISING SANITARIAN LICENSE # \_\_\_\_\_ CIRCLE ONE DATE \_\_\_\_\_



WATER INSTALLATION RECORD

Application No. 1-03-205  
Date Applied 08/20/2002

Type of Installation:

Future  Capital Project

*Garret*  
Utilities

Dev. Agreement   
ADO No.

Applicant Address:


10332 OLD FREDERICK RD  
WOODSTOCK MD 21163-0000

W.H.C.:  
Size Tap: C 1"  
Size Meter: B 3/4"

Date of Tap 8-26-02  
Length of Connection 47'  
Diameter 1"  
Kind of Pipe COPPER  
Size of Corp. Cock 1"  
Meter Size 3/4 Make

9-3-02  
Date  
~~XXXXXXXXXX~~  
Plumbing Permit No.  
123114

TRIANGULATION

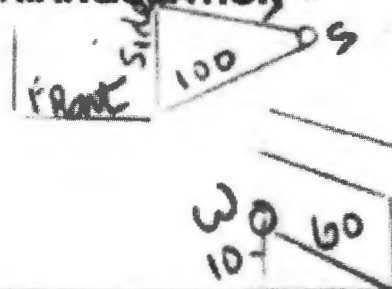

OLD FRED. RD.

Number 24139958  
Date of Meter Setting 8-27  
Meter Location  Pit  I  
Location

Radio in Pit 10 FT. E

60 FT. left of D.W.

Reading:  
Meter 0 Remote RAD

10332 Old Frederick Rd.

Edward Imannmayer  
Address

EDWARD LINSENMAYER PEH  
Plumber's Signature

Installed By BOBBY JONES

SEWER INSTALLATION RECORD

Account No. ~~00103205~~ 17-05-1610  
 Sewer Add \_\_\_\_\_ Water Add \_\_\_\_\_  
 Size S.H.C.: G 4"

Application No. 2-03-201 ✓  
 Date Applied 08/20/2002 ✓  
 W&S Contract No. 24-3115-D  
 W&S Contract No. 2740-S

| Street           | House No. | Lot No. | Subdivision |
|------------------|-----------|---------|-------------|
| OLD FREDERICK RD | 10332     |         |             |


| Type of Property             | Town/Vicinity & Zip     | Applicant Name & Address  |
|------------------------------|-------------------------|---|
| A1<br>SINGLE FAMILY DETACHED | WOODSTOCK<br>21163-0000 | EDWARD J ROSS III<br>10332 OLD FREDERICK RD<br>WOODSTOCK MD 211630000 |

Type of Installation:  
 Future  Capital Project  Utilities  Dev. Agreement   
 ADO No.

|                |         |
|----------------|---------|
| Depth of Sewer | Lateral |
| 8'             | 10'     |

Length of Conn. From DH MH 0+70

Plugged Sewer Information

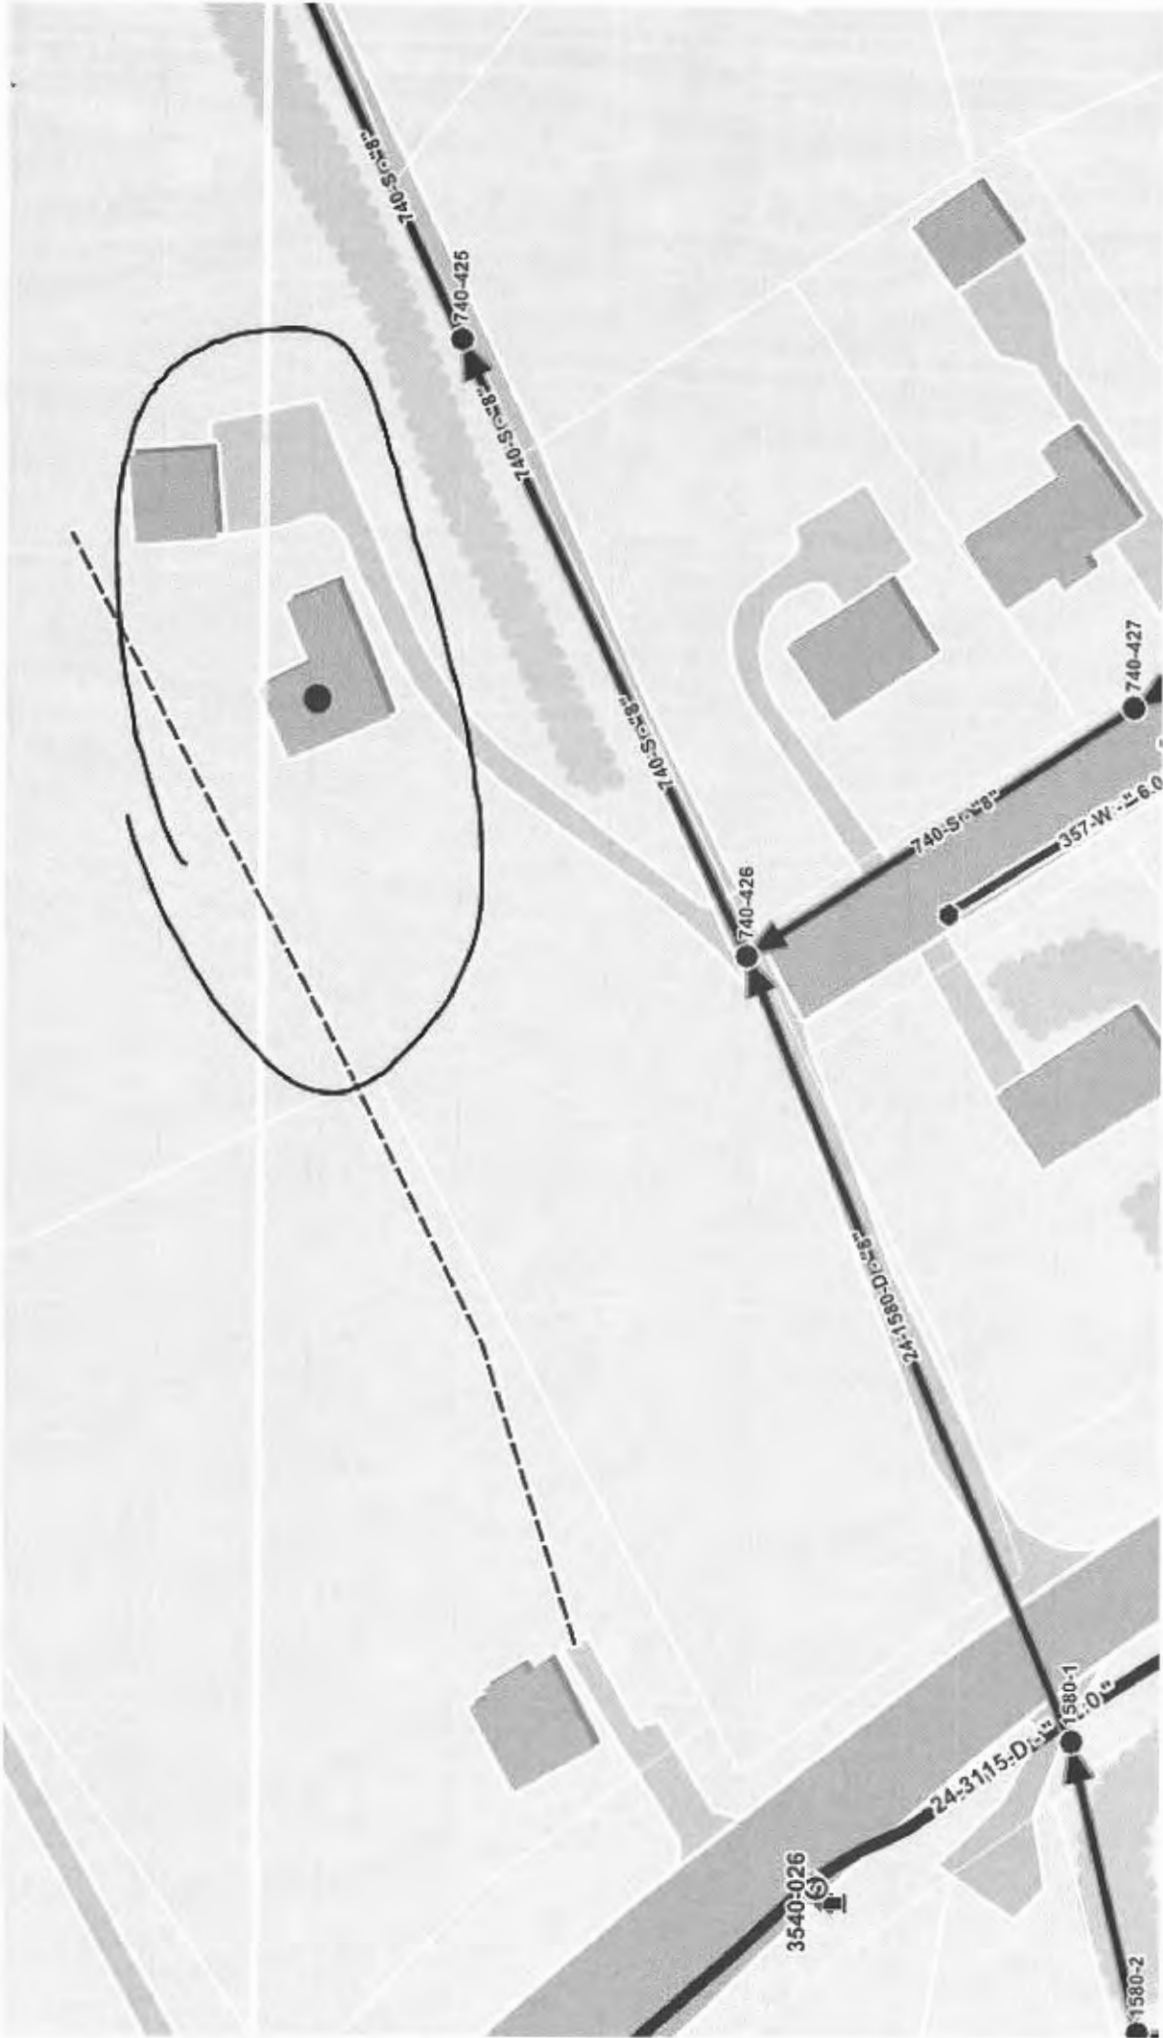

SITE INSPECTION SHEET

OWNER: Ned Ross 410-465-1709

DATE REQUESTED: \_\_\_\_\_

PHONE #: \_\_\_\_\_


CONTRACTOR: \_\_\_\_\_

ADDRESS: 10332 Route 99

WELL TAG #: \_\_\_\_\_

COUNTY #: \_\_\_\_\_

PROPOSAL: emergency metro district inclusion

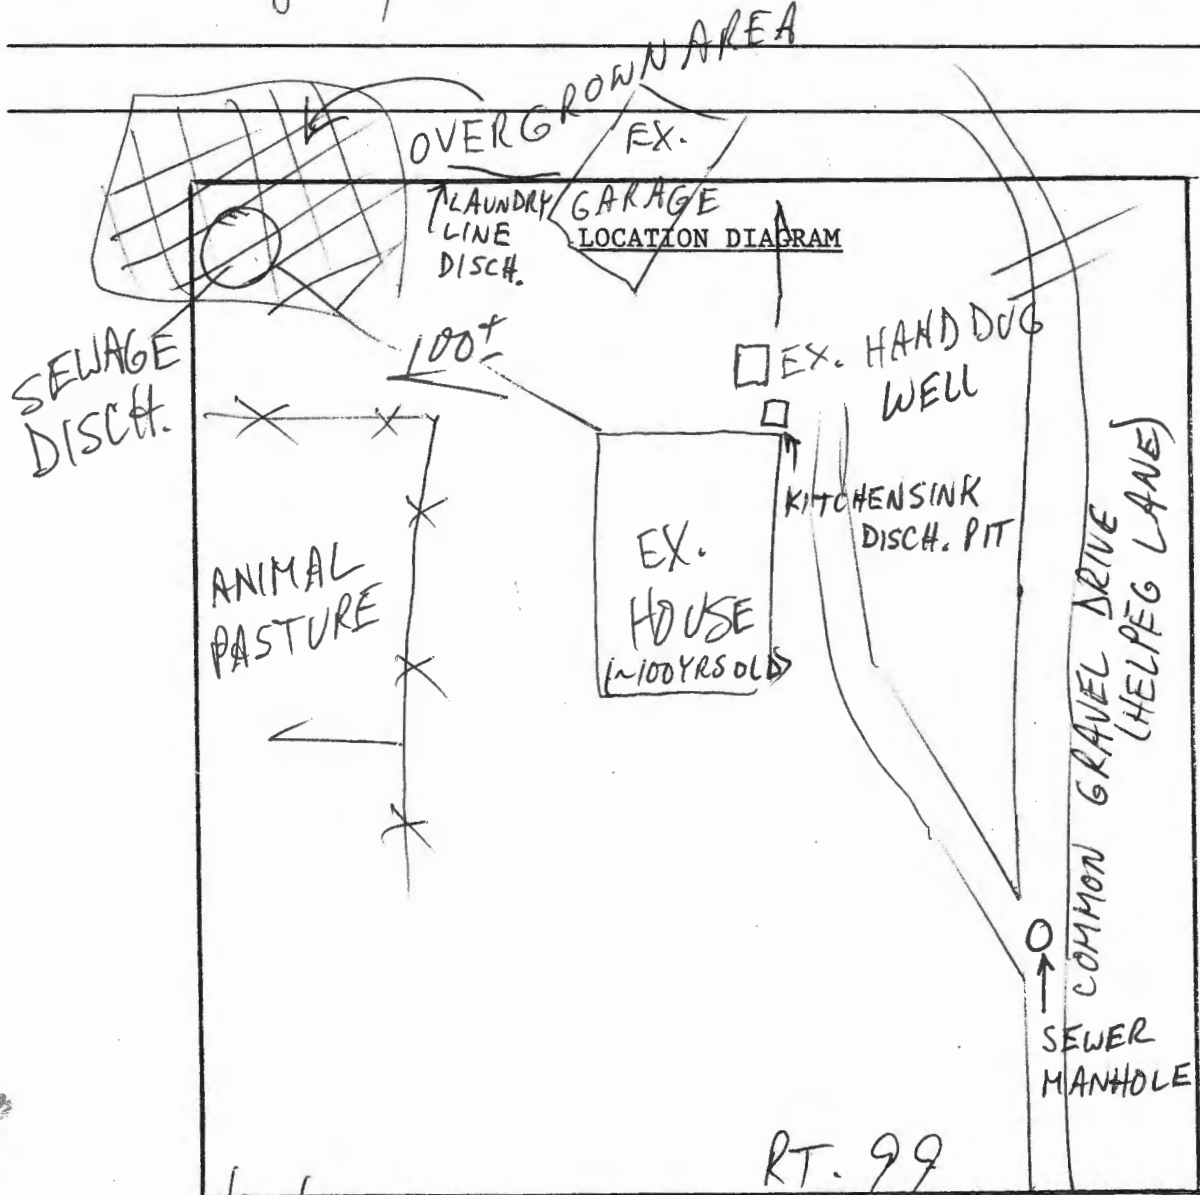

COMMENTS: 6/26/01 MET OWNER @ SITE; HAND DUG WELL ~42' DEEP w/ ~8' H<sub>2</sub>O; SEWAGE DISCH. OBS'D AS SHOWN; NUMEROUS OPTIONS EXIST TO REPAIR EACH w/o CONN TO UTILITIES; OWNERS ADVISED OF NEED TO CONSULT SUPERVISORS FOR ADD'L REVIEW (MR)

DATE: \_\_\_\_\_

INSPECTOR: \_\_\_\_\_



## HOWARD COUNTY HEALTH DEPARTMENT

Bureau of Environmental Health  
3525-H Ellicott Mills Drive, Ellicott City, Maryland 21043-4544

(410) 313-2640 Fax (410) 313-2648

TDD (410) 313-2323 Toll Free 1-877-4MD-DHMH

*Penny E. Borenstein, M.D., M.P.H., Howard County Health Officer*

CERTIFIED MAIL

August 19, 2002

Mr. & Mrs. Ned Ross  
10332 Route 99  
Woodstock, Maryland 21163

RE: **ORDER to Connect to the  
Public Water & Sewer Systems**  
10332 Route 99  
Woodstock, MD. 21163

Dear Mr. & Mrs. Ross

On June 26, 2002, a sanitarian from this office met with you to discuss and evaluate on-going hand dug well water supply deficiencies, plus evidence of septic system failure (including the potential impact of kitchen sink discharge on the well) at the above referenced address.

Based upon the aforementioned information and departmental evaluation, the insufficient quantity of water available from your current hand dug well, plus contamination concerns regarding the potential waste water on the water supply, creates a condition that is considered a potential threat to health as described in Howard County Code Section 12.105.

Therefore, pursuant to provisions of Section 12.105 as recently amended by Council Bill 32-2002, you are hereby **ORDERED** to apply for the necessary permits for connection to the public water supply and sanitary sewer within thirty (30) days of receipt of this letter, and complete both connections within sixty (60) days of receipt of this letter. In addition, you are required to abandon the existing well and leave it in such a way that it cannot be used or be a health threat. This must be accomplished by abandonment and sealing in conformance with COMAR 26.04.04.11. Similarly, the septic tank (and any associated dry well if existing) is to be pumped out and collapsed by a licensed plumber following applicable codes.

This decision may be appealed to the Board of Health. If you choose to appeal, you shall file a written request to the executive secretary of the Board of Health (at the above address) within fifteen (15) days of receipt of this order.

Failure to comply with this order shall be grounds for further enforcement action(s) as set forth in Section 12 of the Howard County Code.

If you have any questions, contact Frank Skinner or Bert Nixon from the Bureau of Environmental Health at (410) 313-2640.

Sincerely,



Penny Borenstein, MD, MPH  
County Health Officer

Cc: Barbara Cook, County Solicitor  
Don Lieu, DPW Utility Design Division  
Dale Neubert, Director of Finance  
Joe Rutter, Director Planning & Zoning  
Frank Skinner, Director Environmental Health  
Jeff Welty, DPW