



HOWARD COUNTY HEALTH DEPARTMENT

67340

DATE
3/13/20

PS

Received From

Hogles Septic Clean PHONE # 410 795-3010

For

Manor Repair - Blv 30
Nichols Dr.

CASH

CHECK

NO.

01551


Fifty - Five

Dollars

\$ 55.00

Received By

J King

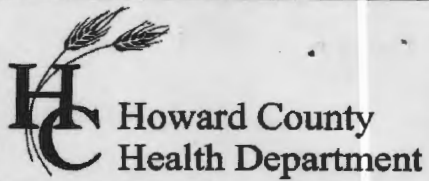

Bureau of Environmental Health
 8930 Stanford Boulevard, Columbia, MD 21045
 Main: 410-313-2640 | Fax: 410-313-2648
 TDD 410-313-2323 | Toll Free 1-866-313-6300
www.hchealth.org
 Facebook: www.facebook.com/hocohealth

Maura J. Rossman, M.D., Health Officer

RECEIPT DATE: 3/13/20

ONSITE SEWAGE DISPOSAL SYSTEM

P 567340

INSTALLATION
 APPROVAL DATE: 3/17/20

PERMIT

A _____

MINOR REPAIR

PROPERTY ADDRESS: 13630 Nichols Drive

SUBDIVISION: Clifton C. Link Property

LOT: 1 TAX ID: 05-357780

CONTRACTOR: Fogle's Septic Clean Inc.

EMAIL: kim@foglesinc.com

CONTRACTOR ADDRESS: 580 Obrecht Road, Sykesville, MD 21784

PHONE: 410-795-5670

PROPERTY OWNER: Don Proia

EMAIL: _____

OWNER ADDRESS: 13630 Nichols Drive, Clarksville, MD 21029

PHONE: 301-854-2118

NUMBER OF BEDROOMS: _____ SEPTIC TANK SIZE: _____ DRAINFIELD SIZE/TYPE: _____

LOCATION:	
NOTES:	Drywell to be collapsed. Dbox to be installed and connected to two existing trenches.

ISSUED BY: Kevin Wolf

ISSUE DATE: 3/13/20

EXPIRATION DATE: 3/13/21

NOTE: CONTRACTOR MUST SCHEDULE AN INSPECTION AND GAIN APPROVAL OF ALL COMPONENTS PRIOR TO COVERING

NOTE: AN ELECTRICAL PERMIT IS REQUIRED FOR INSTALLATION OF ANY ELECTRICAL COMPONENTS OF THE SYSTEM

NOTE: MDE RECOMMENDS SEPTIC TANKS, BAT, AND OTHER PRETREATMENT UNITS BE PUMPED AT A FREQUENCY ADEQUATE TO ENSURE THAT SOLIDS ARE NOT DISCHARGED TO THE DISPOSAL AREA

**NEITHER THE HOWARD COUNTY COUNCIL NOR THE HEALTH DEPARTMENT IS RESPONSIBLE FOR THE SUCCESSFUL OPERATION OF ANY SYSTEM.
 PERMITTEE RESPONSIBLE FOR OBTAINING FINAL APPROVAL ON THIS PERMIT.
 CALL 410-313-1771 FOR INSPECTION OF SEPTIC SYSTEM.**

279189279189

NOT TO SCALE

TRENCH/DRAINFIELD DATA

WIDTH _____ INLET _____ BOTTOM _____

NUMBER OF TRENCHES _____

TOTAL LENGTH _____

ABSORPTION AREA _____

DISTRIBUTION BOX LEVEL _____

DISTRIBUTION BOX BAFFLE _____

DISTRIBUTION BOX PORT _____

PRE-CONSTRUCTION:

Ed **SEPTIC TANK DATA**

SEPTIC TANK I LEVEL ?

MANUFACTURER N/A

CAPACITY _____ GAL

SEAM LOC mid

TANK LID DEPTH _____

BAFFLES _____

BAFFLE FILTER _____

MANHOLE LOC None

6" PORT LOC Front

WATERTIGHT TEST OK

SLOTTED _____

DATE ON LID _____

PUMP/SEPTIC TANK LEVEL _____

MANUFACTURER _____

CAPACITY _____ GAL

SEAM LOC _____

TANK LID DEPTH _____

BAFFLES _____

BAFFLE FILTER _____


MANHOLE LOC _____

6" PORT LOC _____

WATERTIGHT TEST _____

SLOTTED _____

DATE ON LID _____

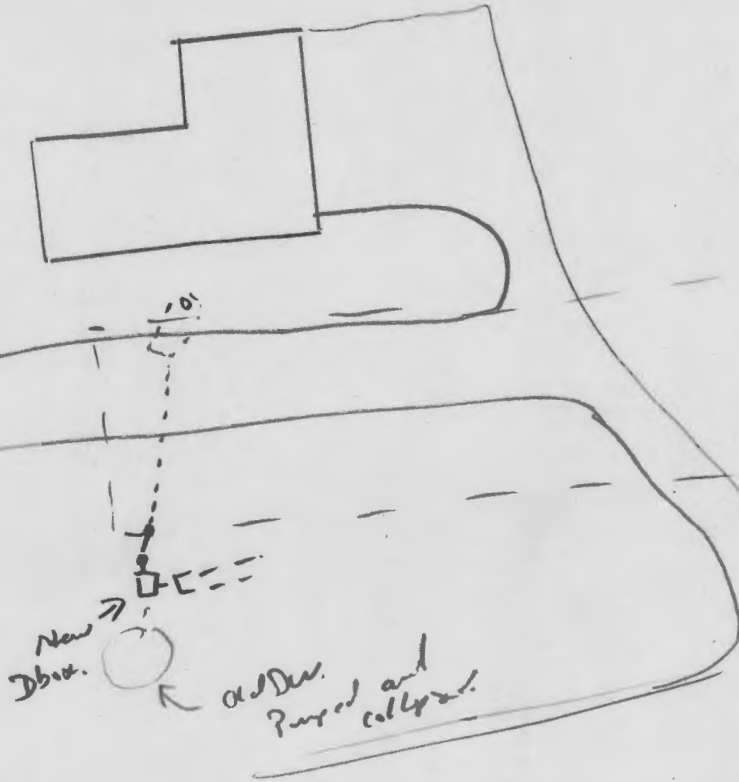

ROAD NAME

INSTALLATION: 3/17/20 *Ed* Dayrell pumped and collapsed.
 New Dbox installed. Initial few ft of stone in ex. trench
 check, why. Could not confirm outlet baffle w/
 contractor. This may need to be confirmed for future use.
 However was made aware. (KAW)

FINAL INSPECTOR

K. Wolf

DATE OF APPROVAL

3/17/20

Minor repair



Bureau of Environmental Health
8930 Stanford Boulevard, Columbia, MD 21045
Main: 410-313-2640 | Fax: 410-313-2648
TDD 410-313-2323 | Toll Free 1-866-313-6300
www.hchealth.org
Facebook: www.facebook.com/hocohealth
Twitter: HowardCoHealthDep

Dr. Maura J. Rossman, M.D., Health Officer

INFORMATION FORM - SEPTIC SYSTEM REPAIR/UPGRADE

Reason for Request:

- Failing System
- System relocation for proposed addition
- System upgrade for proposed addition
- Inadequate treatment zone
- Collapsed septic tank
- Collapsed drywell

Has the septic tank been pumped within the last month?

- Yes Date pumped: _____
- No

Was a visual inspection of the septic tank and/or drain fields conducted?

- Yes Explain observations: _____
- No

Existing system design

- Drywell
- Trench
- Mound
- Unknown
- Other: _____

Was a visual inspection of the sewage line conducted?

- Yes
 - Blockage leading to the tank
 - Yes Explain: _____
 - No
 - Blockage leading to the field
 - Yes Explain: _____
 - No

Is discharge surfacing on the ground?

- Yes
- No

Additional Comments: _____

Pump, crush existing Drywell & replace dist box & connect to existing Trenches

*For REPAIRS, are the owners proposing, or do they plan to add in the future, any additions or modifications to the property, i.e. pools, living space additions, garages, etc? This information must be disclosed at the time of this application. The Health Department will not be able to accommodate requests in the field for property modifications unrelated to the repair request. Such requests may require an additional fee, testing, and submittal of a Percolation Certification Plan, if the property does not meet current Code and Regulation.

Septic Contractor: Fogle's Septic Clean Contractor's Phone: 410-795-5170
Contractor's Address: 530 Obrecht Rd Sykesville 21784

Property Address: 13630 Nichols Dr Clarksville County file: _____
Subdivisio: Clifton Chink Lot: 1 Year Built: 1980
Owner's Name: Don Proia Owner's Phone: 301-854-2118

Name of previous owners: _____ Existing bedrooms: 5
Proposed bedrooms: _____

Has this request been previously discussed with a Sanitarian? (Name): Kenn Volf (KW)
Public Sewer available/nearby: _____

*A Sanitarian will be in contact within three business days, depending upon the urgency of the situation, to coordinate the scheduling/review of the repair or upgrade.

Prior to scheduling inspections, scaled plans should be submitted to clarify the nature of the addition.
Print out a copy of Real Property Data via Dept. of Taxation website _____ Indexed file found _____

If public sewer may be nearby, verify whether sewer is technically "available" through the Bureau of Engineering.
If sewer is available and the property is within the Metropolitan District, connection to sewer is required. If the owner believes reason for exemption exists, the owner should justify the request in writing.

If soil/site conditions are limited and sewer and/or Metro District status is not conducive to connection, the Sanitarian may recommend pursuit of Emergency Sewer Extension or Emergency Metro District Inclusion. The Owner should contact the Bureau of Utilities for details.

No permit is to be issued nor inspection to be scheduled without prior fee collection at the office unless an emergency situation exists. The contractor is to notify office of the emergency situation as soon as possible.