


LOT 3 - MARIANI PROPERTY

AP 772
 Brown loam 8"
 Red/Yellow Clay loam 3 1/2"
 Red Si loam
 Si loam
 HARD BOTTOM 10'

273
 Brown loam 2'
 Red/Brown Clay loam 3'
 Brown/tan Yellow Si loam
 10-15% changing mica schist
 HARD BOTTOM 11'

281
 Brown loam 1'
 Tan/Yellow/Red Si loam 2'
 Yellow/Brown Si loam
 10-15% mica schist changing

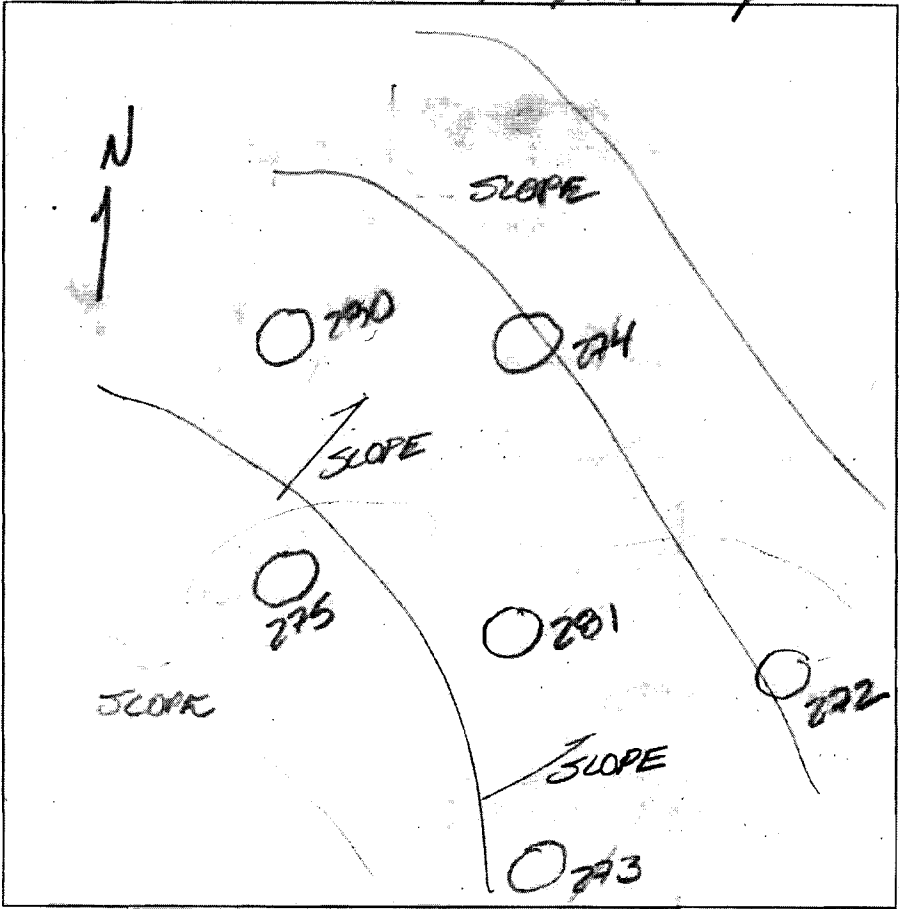

275
 Brown/Red Si loam 2 1/2'
 Red/tan Brown Si loam
 10% changing mica schist

274
 Brown loam 1'
 Red/Brown Si loam 6'
 Brown/Red tan Si loam
 5% changing mica schist

280
 Brown/tan Si loam 2'
 Red/Orange Si loam 3 1/2'
 Tan/Brown Si loam
 10-15% changing mica schist

DATE	TEST #	DEPTH	START	BREAK 1" DROP	STOP 2" DROP	TIME OF 2nd INCH	P/F/H
4/26/04	272	4' / 10'	10:57	11:00	11:03	3 min	F
	273	3 1/2' / 11'	11:05	11:20	11:27	7 min	P
	281	5' / 11'	11:40	11:47	12:00	13 min	P
	275	4 1/2' / 12'	12:56	1:01	1:10	9 min	P
	274	4 1/2' / 12'	12:55	1:02	1:13	11 min	P
	280	4 1/2' / 13 1/2'	1:11	1:16	1:22	6 min	P

REMARKS _____
 SANITARIAN FA/KB BACKHOE Open Kalamen OTHERS Mark P. P.
 TEST HOLES USED IN SDA _____ AVG. PERC TIME _____ SQ. FT/BR _____
 TRENCH WIDTH _____ INLET DEPTH _____ MAX. BOT DEPTH _____ EFFECTIVE SAW _____


(2-2)

LOT 3 - MARIANI PROPERTY

AP

276

Brown loam 1'
 Brown / Red Clay loam 2'
 Red / orange Si cl loam 3'
 tan / orange yellow Si loam
 5-10% micr schist
 14'

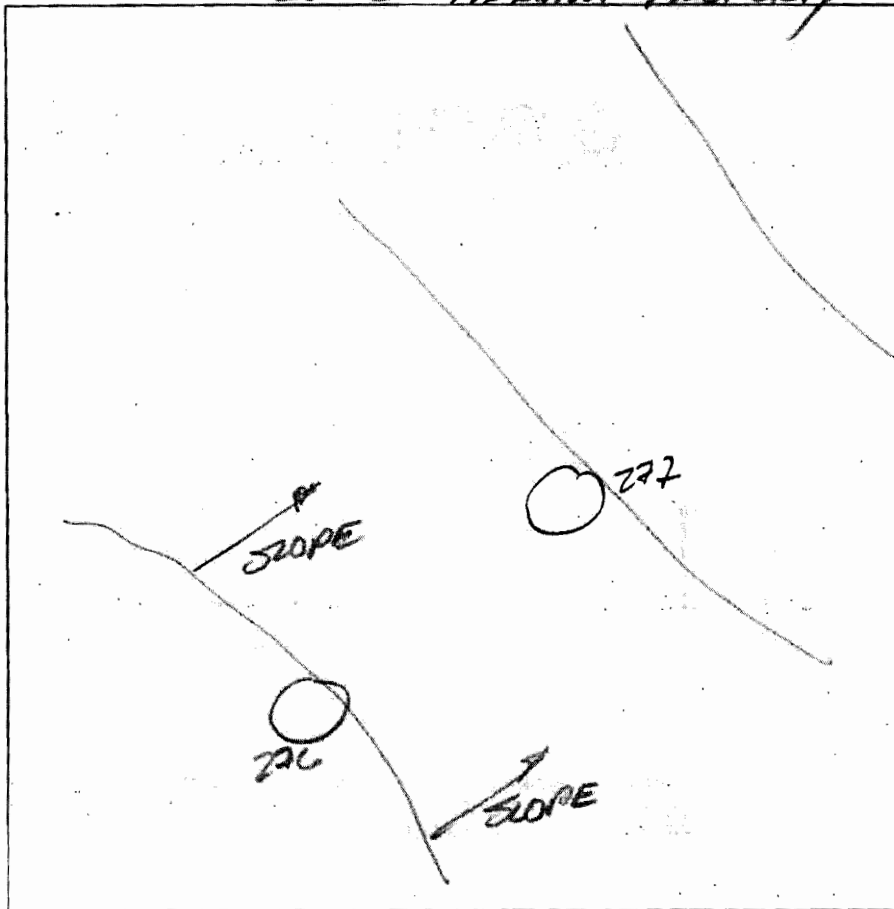

277

Brown / black loam 1'
 Brown / orange tan Clay loam 3'
 Red / brown orange / tan Si loam
 5% granully mica schist
 water
 13'

DATE	TEST #	DEPTH	START	BREAK 1" DROP	STOP 2" DROP	TIME OF 2nd INCH	P/F/H
1/21/04	276	4 1/2' / 14'		1:26	1:33	7 min	P
	277	7 1/2' / 13'	1:25	1:32	1:43	11 min	P

REMARKS _____

SANITARIAN FA/KB

BACKHOE Olin Jr

OTHERS Olin Keenan
Olin Jr.

TEST HOLES USED IN SDA _____

AVG. PERC TIME _____

SQ. FT/BR _____

TRENCH WIDTH _____

INLET DEPTH _____

MAX. BOT DEPTH _____

EFFECTIVE SW _____

(1-2)