

Record Detail * (This section is required.)


Permit Type	Permit Number	Opened Date
Building/Residential/Misc/Tanks	B21003870	10/14/2021
Description of Work		
SFD/ INSTALL (1) 120 GALLON ABOVE GROUND LP TANK		

check spelling

Address * (This section is required.)

Search Reset Clear Get Parcel & Owner

Street #	Street Name	Street Type	
2884	FLORENCE	RD	
Unit Type	Unit #	X Coordinate	Y Coordinate
--Select--		-77.11716	39.31403
City	State	Zip Code	Primary
WOODBINE	MD	21797	Yes

Approved 10/15/21


Parcel * (This section is required.)

Search Reset Clear Get Address & Owner

GIS ID *	Parcel	Parcel Area	Land Value	Improved Value	Exemption Value	Plan Area
910195	115	3.2	221500	402100	180600	RURAL
Legal Description						
IMPSLOT 2 3.200 A[2884 FLORENCE RD][ST MICHAELS OVERLOOK						

check spelling

Block	Lot	Census Tract	Council Dist	Inspection Dist	Supervisor Dist	Map #	DAP Zone
	2	604001	5				
Plan Area	State Tax Id	Subdivision Name					
	1404352432						
Section	Area	Tax Map					
		13					
Grid	Zoning District	ADC Map					
13-1	RC-DEO	4691-B10					
SDP No.	Final Plan No.	WP File No.					
Record Plat No.	WS Contract No.	FDP No.	Primary				
9839			Yes				
Owner Occupied	Year Built	Historic District					
<input type="radio"/> Yes <input type="radio"/> No	1993	<input type="radio"/> Yes <input checked="" type="radio"/> No					
Historic District Registry No.	Stat Area	Flood Plain					
	4-04	<input type="radio"/> Yes <input checked="" type="radio"/> No					
Building No							

Owner * (This section is required.)

Search Reset Clear

Name *	MAYHEW MICHAEL J	
Address Line 1	2884 FLORENCE RD	
Address Line 2		
Address Line 3		
Mail City	Mail State	Mail Zip Code
WOODBINE	MD	21797
Phone	Primary	
301-251-0606	Yes	
E-mail		
Cell Number	Fax Number	

Professionals (This section is not required.)

Search Reset Clear

License # *	Business Name		
20100078263	SUBURBAN PROPANE		
License Type *	First Name	Middle Name	Last Name
Propane Gs <input checked="" type="checkbox"/>	BRENT		STUBBS
Primary	Address Line 1		
Yes <input checked="" type="checkbox"/>	31 DERWOOD CIRCLE		
	Address Line 2		
	City	State	ZIP Code
	ROCKVILLE	MD	20850-0000
	Phone 1	Phone 2	Fax
	3012510606		3012510608
	E-mail		
	BSTUBBS@SUBURBANPROPANE.COM		

Applicant (This section is not required.)

Search As Owner As Lic. Prof As Contact

Type *	First Name	MI	Last Name
Applicant <input checked="" type="checkbox"/>	MARIA		STAMOULIS
Relationship	Full Name		
--Select-- <input checked="" type="checkbox"/>	MARIA STAMOULIS		
Primary	Organization Name		
Yes <input checked="" type="checkbox"/>	SUBURBAN PROPANE		
	Street Address		
	31 DERWOOD CIRCLE		
	Address Line 2		
	City	State	Zip Code
	ROCKVILLE	MD	20850
	Phone	Cell	Fax
	301-251-0606		
	E-mail *		
	MSTAMOULIS@SUBURBANPROPANE.COM		

Addtl Info

Est Construction Cost *	Housing Units *	Number of Buildings *	Public Owned
800	0	0	No <input checked="" type="checkbox"/>
Construction Type	--Select-- <input checked="" type="checkbox"/>		

TANK INFORMATION

RESIDENTIAL TANK INFORMATION

Capital Project-No Fee *	Capital Project Number	Fee Exempt *	Roadside Tree Project Permit *	Roadside Tree Permit #
<input type="radio"/> Yes <input checked="" type="radio"/> No		<input type="radio"/> Yes <input checked="" type="radio"/> No	<input type="radio"/> Yes <input checked="" type="radio"/> No	
Existing Use	Number of Tanks Installed *	Number of Tanks Removed *		
SFD <input checked="" type="checkbox"/>	1	0		
Water Supply	Sewage Disposal	Expiration Date	Relocate Existing Tank *	
Private <input checked="" type="checkbox"/>	Private <input checked="" type="checkbox"/>	4/12/2022 <input type="checkbox"/>	0	

PAYMENT INFORMATION

Check 1	Payee 1	Check 2	Payee 2	SAP Doc No	SAP Entered


Related Records

Showing 1-2 of 2

Permit Number	Record Type Alias	Status	Number	Street Name	Opened Date	Description
B21003870	Residential Tank Permit	Review In Process	2884	FLORENCE	10/14/2021	SFD// INSTALL (1) 120 GALLON ABOVE GROUND LP TANK
P21004107	Residential Plumbing Addition Alteration Permit	Incomplete	2884	FLORENCE	10/14/2021	SFD// INSTALL GAS FIXTURE// 1 - GAS LINE TO FIREPLACE

Page 1 of 1

Submit Cancel

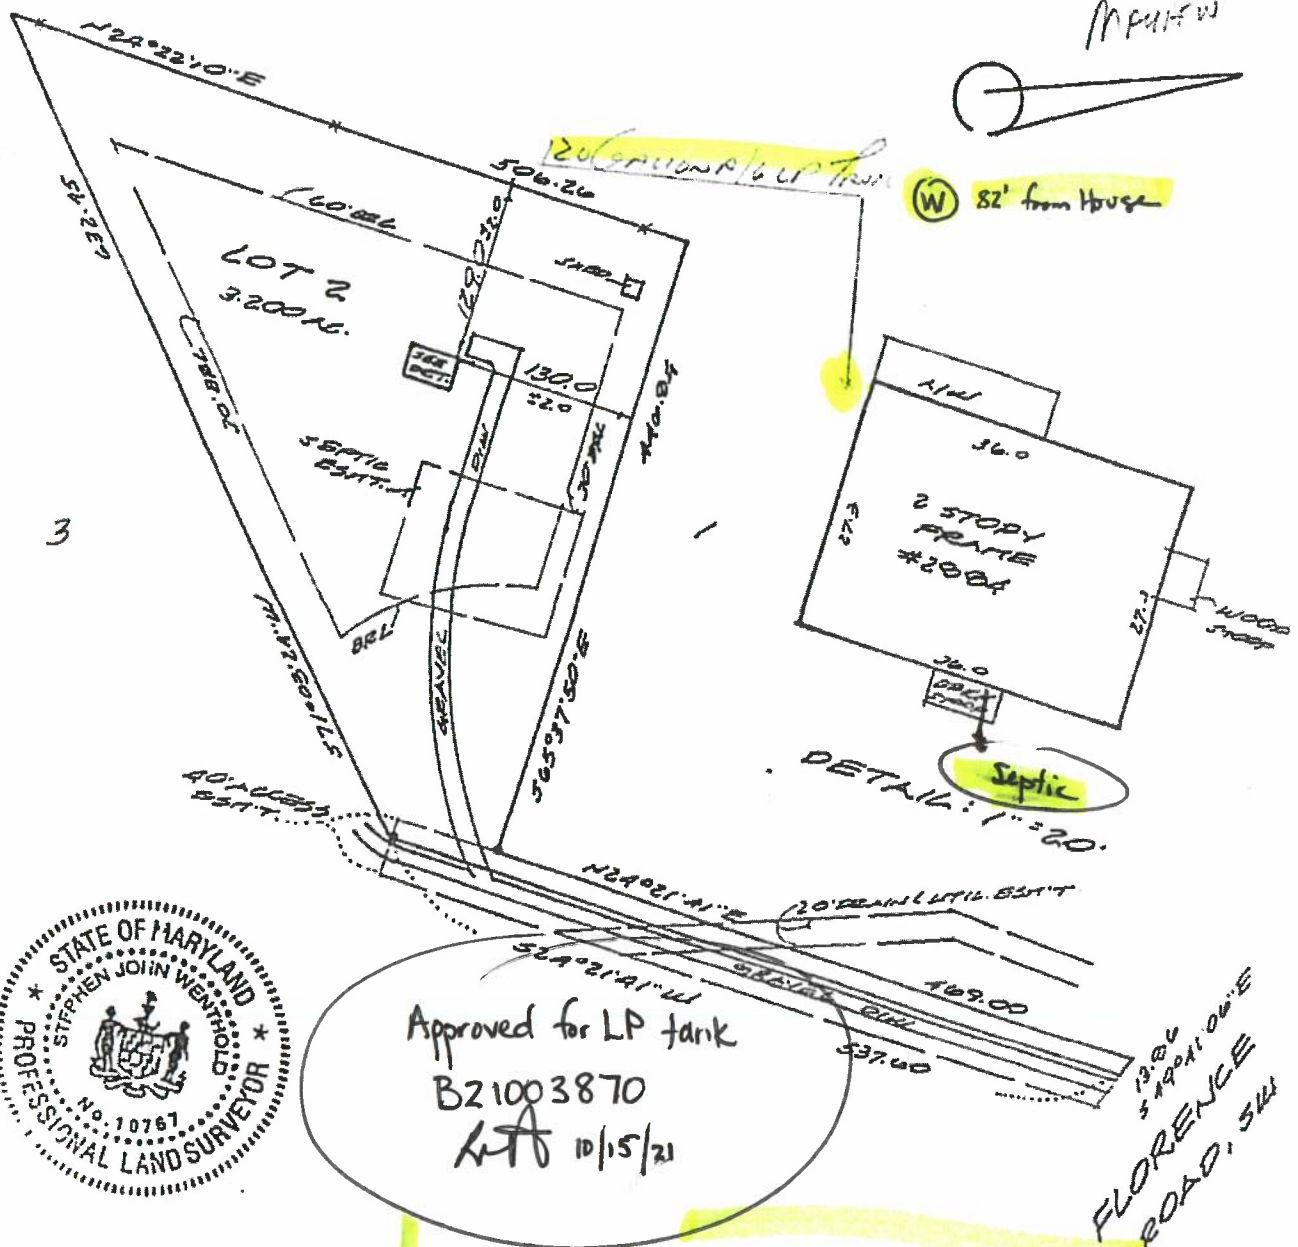

Approved for LP tank
 B21003870
 LTA 10/15/21

verified off of Archive file
 A46169-04-352432-2884 Florence Rd

Date: 04-05-04
 Plat Book: 91
 Plat No.: 9839
 Work Order: 04-2127
 Address: 2884 FLORENCE ROAD, SW
 District: 4
 Jurisdiction: HOWARD COUNTY, MD

Scale: 1"=25' Dm: S.D.
 NO TITLE REPORT FURNISHED

Surveyor's Certification

I hereby certify that the survey shown hereon is correct to the best of my knowledge and that, unless noted otherwise, it has been prepared utilizing description of record. This survey is not a boundary survey and the location of existence of property corners is neither guaranteed nor implied. Fence lines, if shown, are approximate in location. This property does not lie within a 100 year flood plain according to FEMA insurance maps as interpreted by the originator unless otherwise shown hereon. Building restriction lines shown are as per available information and are subject to the interpretation of the originator.

Stephen J. Wenthold

NOTE: This plat is of benefit to a consumer only insofar as it is required by a lender or a title insurance company or its agent in connection with contemplated transfer, financing or refinancing. This plat is not to be relied upon for the establishment or location of fences, garages, buildings, or other existing or future improvements. This plat does not provide for the accurate identification of property boundary lines, but such identification may not be required for the transfer of title or securing financing or refinancing.



Meridian Surveys, Inc.
 811 Russell Avenue
 Suite #303
 Gaithersburg, MD 20879
 (301) 721-9400



STEEL TANKS & CYLINDERS FOR LP GAS SYSTEMS



100 LB (POL VALVE)



Ring top available for Canadian market



100 LB (MULTI-VALVE)



28.6 GALLON ASME Manchester's 'MINI'



57 GALLON ASME 200 LB DOT



118 GALLON ASME 420 LB DOT

STANDARD

	DOT			ASME		
SIZE (LB)	100 LB	200 LB	420 LB	28.6 GAL "MINI"	57 GAL	118 GAL
LPG CAPACITY (GAL)	22.9	45.6	95.9	22.9	45.6	95.9
WATER CAPACITY (LB)	238	476	1000	28.5 GAL	57 GAL	118 GAL
OVERALL HEIGHT (IN)	46.6	41.9	53.8	37.1	41.9	53.8
BODY HEIGHT (IN)	41	34.1	45.6	29.8	34.1	45.6
CYLINDER DIAMETER (IN)	15.1	24	30	18	24	30
BASE DIAMETER (IN)	14	20	23.1	15.5	20	23.1
TARE WEIGHT (LB)	71	152	278	85	188	291
STANDARD SPECIFICATION	4BW240	4BW240	4BW240	ASME	ASME	ASME
VALVE	POL (VAPOR OR LIQUID) MULTI-VALVE	CGA-510	CGA-510	CGA-510	CGA-510	CGA-510
SIGHT GAUGE	N/A	YES	YES	YES	YES	YES
COLOR	DOT-GRAY / TC-WHITE	WHITE	WHITE	WHITE	WHITE	WHITE
PALLET QUANTITY	18	16	9	20	16	9

METRIC

	DOT			ASME		
SIZE (LB)	100 LB	200 LB	420 LB	28.6 GAL "MINI"	57 GAL	118 GAL
LPG CAPACITY (L)	87	172.9	363	86.6	172.9	363
WATER CAPACITY (KG)	108	216	450	108.3	216	450
OVERALL HEIGHT (MM)	1184	1064	1366	942	1064	1366
BODY HEIGHT (MM)	1041	865	1159	756	865	1159
CYLINDER DIAMETER (MM)	383	610	762	457	610	762
BASE DIAMETER (MM)	356	508	587	394	508	587.0
TARE WEIGHT (KG)	31.8	85.3	126.1	38.6	85.3	132.0
STANDARD SPECIFICATION	4BW240	4BW240	4BW240	ASME	ASME	ASME
VALVE	POL (VAPOR OR LIQUID) MULTI-VALVE	CGA-510	CGA-510	CGA-510	CGA-510	CGA-510
SIGHT GAUGE	N/A	YES	YES	YES	YES	YES
COLOR	DOT-GRAY / TC-WHITE	WHITE	WHITE	WHITE	WHITE	WHITE
PALLET QUANTITY	18	16	9	20	16	9