

Save Reset Cancel Help

Record Detail * (This section is required.)

Permit Type	Permit Number	Opened Date
Building/Residential/Misc/Deck	B21003344	09/08/2021
Description of Work		
NOV/ SFD/ REPLACE EXISTING DECK WITH NEW 36 X 13 OPEN DECK W/RAMP (NOT ADA COMPLIANT) CB10557		

check spelling

Address * (This section is required.)

Search Reset Clear Get Parcel & Owner

Street #	Street Name	Street Type
16377	OLD FREDERICK	RD
Unit Type	Unit #	X Coordinate
-Select-		-77.08689
		Y Coordinate
		39.3493
City	State	Zip Code
MOUNT AIRY	MD	21771
		Primary
		Yes

Parcel * (This section is required.)

Search Reset Clear Get Address & Owner

GIS ID *	Parcel	Parcel Area	Land Value	Improved Value	Exemption Value	Plan Area
829998	409	2.19	196900	357800	160900	RURAL
Legal Description						
MPVLOT 1 2.1935 A.[]16377 OLD FREDERICK RD[]LISBON						

check spelling

Block	Lot	Census Tract	Council Dist	Inspection Dist	Supervisor Dist	Map #	DAP Zone
	17 D	604001	5				
Plan Area	State Tax Id	Subdivision Name					
	1404332342						
Section	Area	Tax Map					
		2					
Grid	Zoning District	ADC Map					
7-4	RC-DEO	4891-G5					
SDP No.	Final Plan No.	WP File No.					
Record Plat No.	WS Contract No.	FDP No.					
Owner Occupied	Year Built	Historic District					
<input type="radio"/> Yes <input type="radio"/> No	1983	<input type="radio"/> Yes <input checked="" type="radio"/> No					
Historic District Registry No.	Stat Area	Flood Plain					
	4-02	<input type="radio"/> Yes <input checked="" type="radio"/> No					
Building No							

Owner * (This section is required.)

Search Reset Clear

Name *		
PACK TADAS		
Address Line 1		
16377 OLD FREDERICK RD		
Address Line 2		
Address Line 3		
Mail City	Mail State	Mail Zip Code
MT AIRY	MD	21771
Phone	Primary	
2404218736	Yes	
E-mail		
IT@DATACORP.COM		
Cell Number	Fax Number	

Professionals (This section is not required.)

Approved
B21003344
RAC
10/18/2021

Search Reset Clear

License # *	Business Name		
License Type *	First Name	Middle Name	Last Name
--Select--			
Primary	Address Line 1		
Yes	Address Line 2		
	City		
	State	ZIP Code	
	Phone 1	Phone 2	Fax
	E-mail		

Applicant *(This section is not required.)*

Search As Owner As Lic. Prof As Contact

Type *	First Name	MI	Last Name
Applicant	VYTAUTAS		PAKAJISKIS
Relationship	Full Name		
Applicant	PAK TADAS		
Primary	Organization Name		
Yes	Street Address		
	16377 OLD FREDERICK RD		
	Address Line 2		
	City	State	Zip Code
	MT AIRY	MD	21771
	Phone	Cell	Fax
	2404218736		
	E-mail *		
	IT@DATACORP.COM		

Addtl Info

Est Construction Cost *	Housing Units *	Number of Buildings *	Public Owned
5000	0	0	No
Construction Type			
101 - Single Family Houses Detached			

MISC PERMIT INFO

MISCELLANEOUS PERMIT INFORMATION

Capital Project-No Fee *	Capital Project Number	Fee Exempt *	Roadside Tree Project Permit *	Roadside Tree Project Permit #
<input type="radio"/> Yes <input checked="" type="radio"/> No		<input type="radio"/> Yes <input checked="" type="radio"/> No	<input type="radio"/> Yes <input checked="" type="radio"/> No	
Existing Use *	Water	Sewage	Expiration Date	
SFD	Private	Private	3/8/2022	

PAYMENT INFORMATION

Check 1	Payee 1	Check 2	Payee 2	SAP Doc No	SAP Entered

Submit Cancel

PERMIT NUMBER: B 21003344

DATE ACCEPTED:

DILP 2021 SEP 7 PM 4:53



RESIDENTIAL BUILDING PERMIT APPLICATION

HOWARD COUNTY DEPARTMENT OF INSPECTIONS, LICENSES, AND PERMITS
3430 COURT HOUSE DRIVE, ELLICOTT CITY, MD 21043 - PHONE: (410) 313-2455 OPTION #4
www.howardcountymd.gov

BUILDING SITE ADDRESS REQUIRED

Street Address: 16377 Old Frederick Rd
City: Mt Airy
State: MD
Zip Code: 21771
Subdivision/Village/Complex Name:
SDP/WP/BA #:
Lot: 121157 Tax Map: 0007 Parcel: 0463 Grading Permit #:

DESCRIPTION OF WORK REQUIRED

Existing Use: Free standing Deck Proposed Use: Free standing Deck Estimated Cost: \$ 5000
Trade Work to Be Completed (Separate Permits Required): Mechanical (HVACR) Electrical Plumbing None
Replacing existing deck with a ramp size 36' x 13'
Open deck w/ ramp NOT ADA compliant

PROPERTY OWNER INFORMATION REQUIRED

Owner(s) Name(s) (As it appears on tax records): TADAS PACE Primary Residence: Yes No
Owner's Street Address: 16377 Old Frederick Rd
City: Mt Airy State: MD Zip Code: 21771
Phone: 240-921-8736 Email: itadatas@comcast.net

APPLICANT NAME REQUIRED - INDIVIDUAL WHO SIGNS THIS APPLICATION

Business Name: Contact Name: Vytautas B. Kovaliskis
Street Address: same address as 16377 Old Frederick Rd
City: Mt Airy State: MD Zip Code: 21771
Phone: 301-695-4195 Email: itadatas@comcast.net

CONTRACTOR INFORMATION REQUIRED

Business Name:
Licensee's Name: License #:
Street Address:
City: State: Zip Code:
Phone: Email:

ARCHITECT/ENGINEER INFORMATION INDIVIDUAL WHO SIGNED PLANS, IF APPLICABLE

Business Name: Name:
Street Address:
City: State: Zip Code:
Phone: Email:

BUILDING CHARACTERISTICS REQUIRED

Primary Structure: SF Dwelling SF Townhouse SF Duplex Mobile Home Multi-Family Dwelling (MF*) Condo: Yes No
Utilities: Electric Gas Water Supply: Public Private (Well) Sewage Disposal: Public Private (Septic)
Heating System: Electric Natural Gas Propane Other: Roadside Tree Project: No Yes: #
Sprinkler System: NFPA 13 NFPA 13R NFPA 13D None Fire Alarm System: Yes No Voice Evac

ADDITIONAL RESIDENTIAL INFORMATION (PLEASE SELECT/COMPLETE ALL THAT APPLY)

Model Name & Options:
of Bedrooms (SF): # of efficiency units (MF*): # of 1 BR (MF*): # of 2 BR (MF*): # of 3 BR (MF*):
Rooms: # Full Baths: # Half Baths: # Fireplaces:
Garage/Carport Info: Attached Garage Detached Garage Integral Garage Carport None
Basement/Foundation Info: Slab on Grade Post & Pier Unfinished Basement Finished Basement Full or Partial
1st Fl Width: 1st Fl Depth: 2nd Fl Width: 2nd Fl Depth: Bsmt Width: Bsmt Depth:
Energy Method: Prescriptive Performance UA Alternative ERI Gross Area: sq ft Occupiable Area: sq ft

AGREEMENT/ DISCALIMER REQUIRED

THE UNDERSIGNED HEREBY CERTIFIES AND AGREES AS FOLLOWS: (1) THAT HE/SHE IS AUTHORIZED TO MAKE THIS APPLICATION; (2) THAT THE INFORMATION IS CORRECT; (3) THAT HE/SHE WILL COMPLY WITH ALL REGULATIONS OF HOWARD COUNTY WHICH ARE APPLICABLE THERETO; (4) THAT HE/SHE WILL PERFORM NO WORK ON THE ABOVE REFERENCED PROPERTY NOT SPECIFICALLY DESCRIBED IN THIS APPLICATION; (5) THAT HE/SHE GRANTS COUNTY OFFICIALS THE RIGHT TO ENTER ONTO THIS PROPERTY FOR THE PURPOSE OF INSPECTING THE WORK PERMITTED AND POSTING NOTICES.

APPLICANT'S ORIGINAL SIGNATURE DATE SIGNED 9/27/2021

FOR OFFICE USE ONLY


CHECKS PAYABLE TO: DIRECTOR OF FINANCE OF HOWARD COUNTY

AGENCIES REQUIRED/APPROVALS:

PR DPZ DED Health SHA CID
10/18/2021 R/E

SUBMITTAL FEES: 155 PAYMENT: 369 ACCEPTED BY: [Signature]

OLD VERSION PLOT MAP

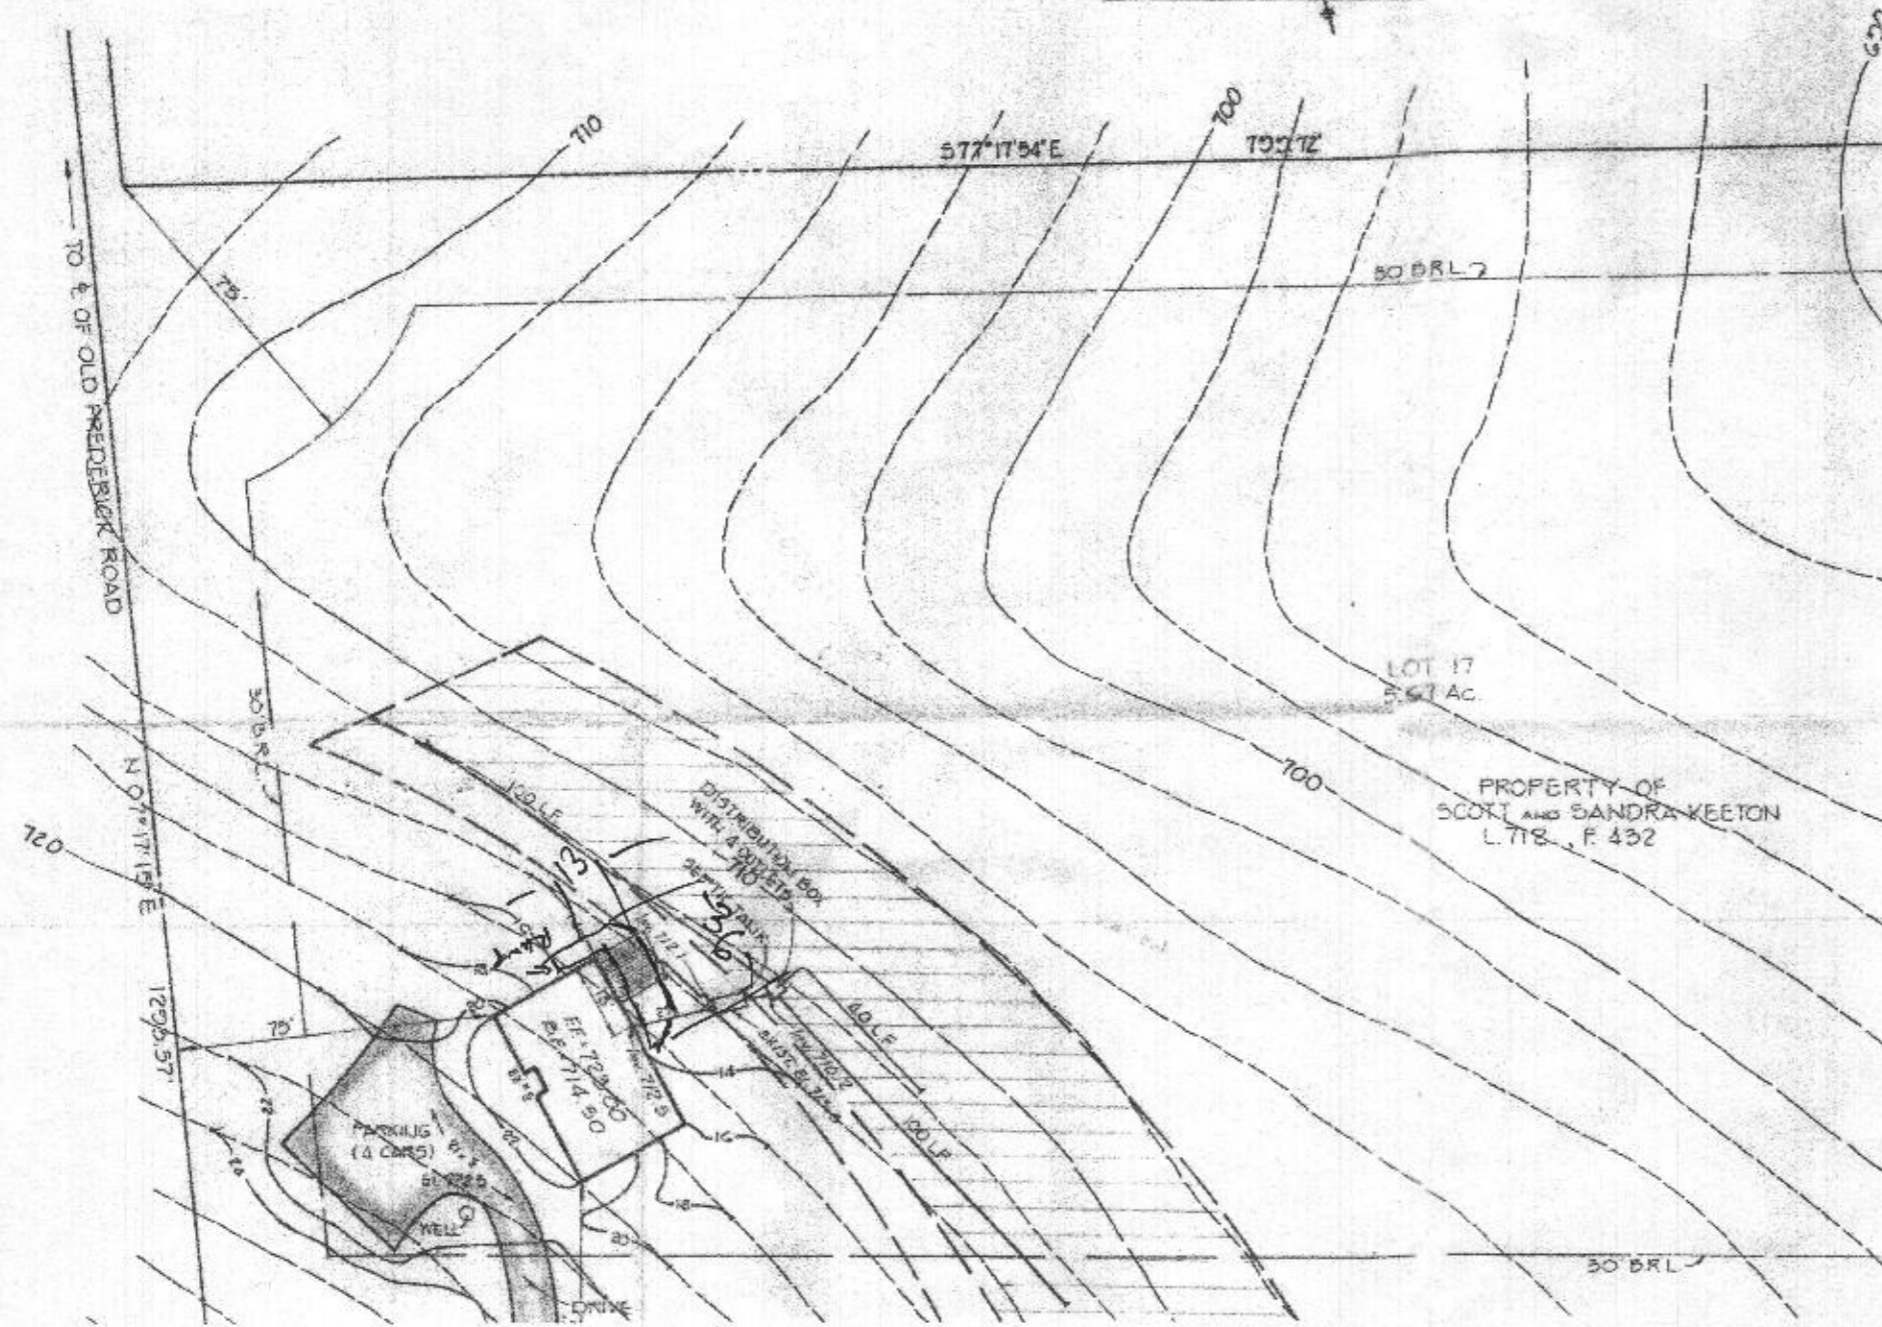

Approved
B21603344
R/E 10/18/2021

HoCo Health Dept
Environmental Health
SEP 09 2021

HoCo Health Dept
Environmental Health
SEP 08 2021