

Menu

Refine Search

GIS

Help

Data Filter: Filter TMP's

My Filters

--Select--


Showing 1 of 1

<input type="checkbox"/> Permit #	Status	Record Type Alias	Street #	Street Name	Type	Unit Type	Unit #	City
<input type="checkbox"/> B21003429	Review In Process	Residential Interior Alteration Single Family Dwelling Permit	14881	OLD FREDERICK	RD			WOODB

Page 1 of 1



Online Complete

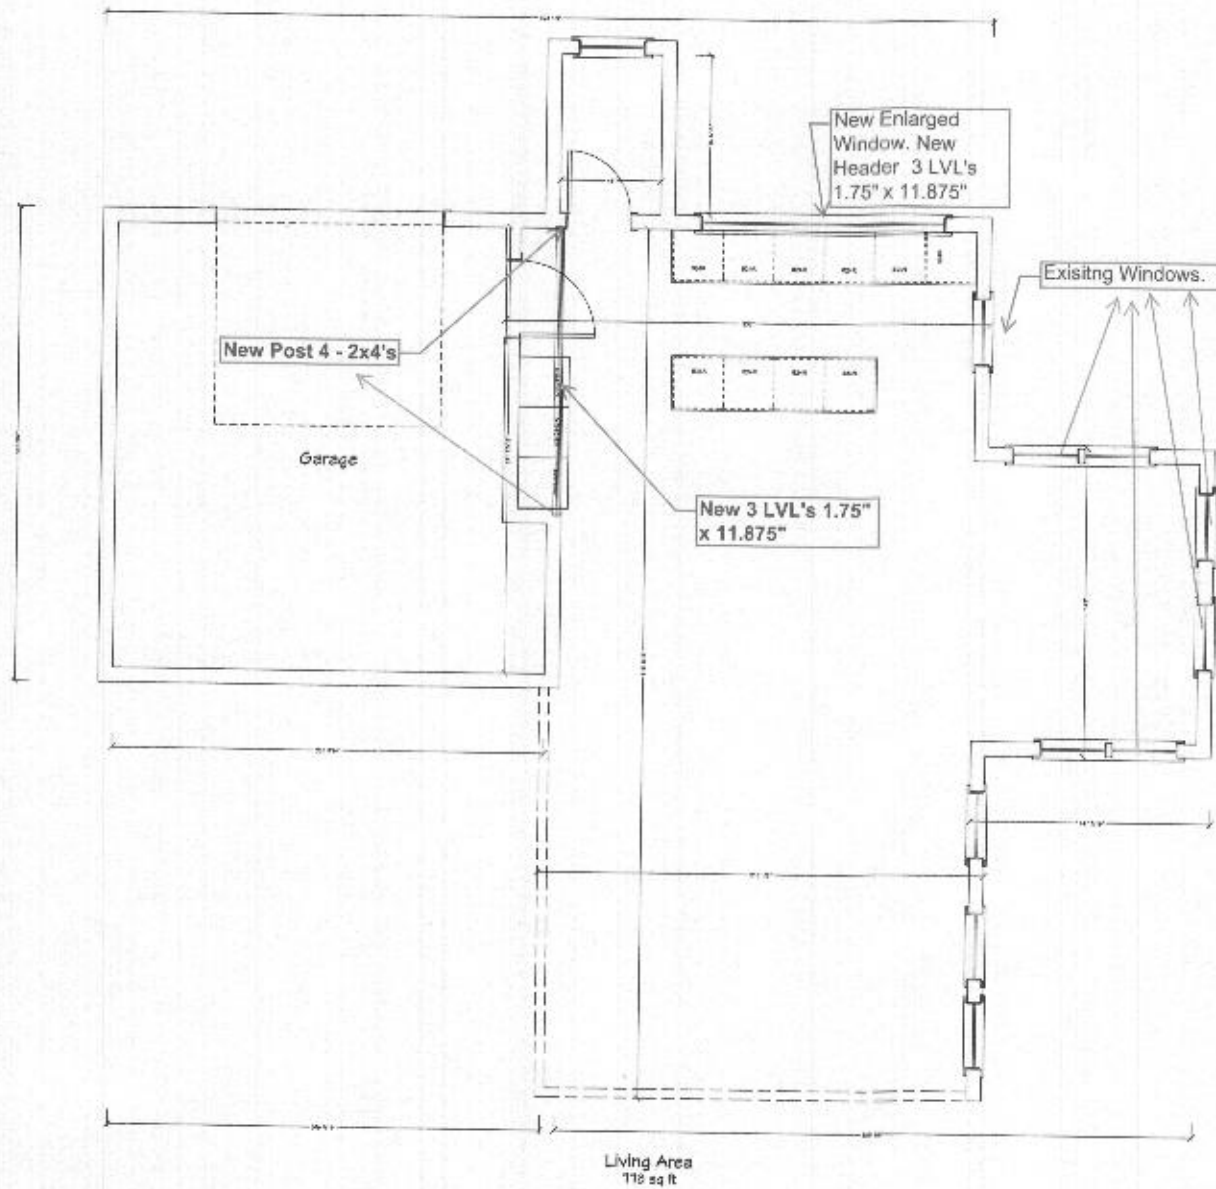

Approved Septic System Plan
 Howard County Health Department
Dana Bernard 10-12-20
 Signature Date
 B21003429