
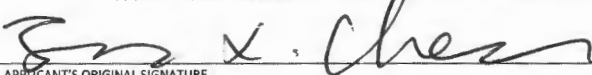



PERMIT NUMBER: B **21003390**

DATE ACCEPTED:

RESIDENTIAL BUILDING PERMIT APPLICATION					
HOWARD COUNTY DEPARTMENT OF INSPECTIONS, LICENSES, AND PERMITS					
3430 COURT HOUSE DRIVE, ELLICOTT CITY, MD 21043 - PHONE: (410) 313-2455 OPTION #4					
www.howardcountymd.gov					
BUILDING SITE ADDRESS <i>REQUIRED</i>					
Street Address: 11027 Hunters View Rd					Unit:
City: Ellicott City			State: MD		Zip Code: 21042
Subdivision/Village/Complex Name: RIVERWOOD				SDP/WP/BA #: PH 2,RSB	
Lot: 51	Tax Map: 0029	Parcel: 0020	Grading Permit #: 0004		
DESCRIPTION OF WORK <i>REQUIRED</i>					
Existing Use:		Proposed Use: Attached Deck behind the house		Estimated Cost: \$8,000.00	
Trade Work to Be Completed (<i>Separate Permits Required</i>): <input type="checkbox"/> Mechanical (HVAC) <input type="checkbox"/> Electrical <input type="checkbox"/> Plumbing <input checked="" type="checkbox"/> None					
Deck - 35.7' X 12' Composite PVC - sandy brown with white railing and steps to grass					
PROPERTY OWNER INFORMATION <i>REQUIRED</i>					
Owner(s) Name(s) (<i>As it appears on tax records</i>): Xinsheng Chen					Primary Residence: <input checked="" type="checkbox"/> Yes <input type="checkbox"/> No
Owner's Street Address: 11027 Hunters View Rd					
City: Ellicott City			State: MD		Zip Code: 21042
Phone: (410) 562-2432			Email: Jxchen99@yahoo.com		
APPLICANT NAME <i>REQUIRED - INDIVIDUAL WHO SIGNS THIS APPLICATION</i>					
Business Name: James Xinsheng Chen			Contact Name: James Xinsheng Chen		
Street Address: 11027 Hunters View Rd					
City: Ellicott City			State: MD		Zip Code: 21042
Phone: (410) 562-2432			Email: Jxchen99@yahoo.com		
CONTRACTOR INFORMATION <i>REQUIRED</i>					
Business Name: Owner to Act as Contractor					
Licensee's Name: Owner to Act as Contractor			License #: N/A		
Street Address: 11027 Hunters View Rd					
City: Ellicott City			State: MD		Zip Code: 21042
Phone: (410) 562-2432			Email: Jxchen99@yahoo.com		
ARCHITECT/ENGINEER INFORMATION <i>INDIVIDUAL WHO SIGNED PLANS, IF APPLICABLE</i>					
Business Name: James Xinsheng Chen			Name: James Xinsheng Chen		
Street Address: 11027 Hunters View Rd					
City: Ellicott City			State: MD		Zip Code: 21042
Phone: (410) 562-2432			Email: Jxchen99@yahoo.com		
BUILDING CHARACTERISTICS <i>REQUIRED</i>					
Primary Structure: <input checked="" type="checkbox"/> SF Dwelling <input type="checkbox"/> SF Townhouse <input type="checkbox"/> SF Duplex <input type="checkbox"/> Mobile Home <input type="checkbox"/> Multi-Family Dwelling (MF*)					Condo: <input type="checkbox"/> Yes <input checked="" type="checkbox"/> No
Utilities: <input checked="" type="checkbox"/> Electric <input checked="" type="checkbox"/> Gas		Water Supply: <input type="checkbox"/> Public <input checked="" type="checkbox"/> Private (Well)		Sewage Disposal: <input type="checkbox"/> Public <input checked="" type="checkbox"/> Private (Septic)	
Heating System: <input type="checkbox"/> Electric <input checked="" type="checkbox"/> Natural Gas <input type="checkbox"/> Propane <input type="checkbox"/> Other:			Roadside Tree Project: <input checked="" type="checkbox"/> No <input type="checkbox"/> Yes: #		
Sprinkler System: <input type="checkbox"/> NFPA 13 <input checked="" type="checkbox"/> NFPA 13R <input type="checkbox"/> NFPA 13D <input type="checkbox"/> None			Fire Alarm System: <input checked="" type="checkbox"/> Yes <input type="checkbox"/> No <input type="checkbox"/> Voice Evac		
ADDITIONAL RESIDENTIAL INFORMATION <i>(PLEASE SELECT/COMPLETE ALL THAT APPLY)</i>					
Model Name & Options: Winchester home - Elevation 92					
# of Bedrooms (SF): 405		# of efficiency units (MF*): 2,185		# of 1 BR (MF*): 132	
# of 2 BR (MF*): 132		# of 3 BR (MF*): 132			
# Rooms: 4		# Full Baths: 3		# Half Baths: 1	
# Fireplaces: 1					
Garage/Carport Info: <input checked="" type="checkbox"/> Attached Garage <input type="checkbox"/> Detached Garage <input type="checkbox"/> Integral Garage <input type="checkbox"/> Carport <input type="checkbox"/> None					
Basement/Foundation Info: <input type="checkbox"/> Slab on Grade <input type="checkbox"/> Post & Pier <input checked="" type="checkbox"/> Unfinished Basement <input type="checkbox"/> Finished Basement: <input type="checkbox"/> Full or <input type="checkbox"/> Partial					
1 st Fl Width: 61		1 st Fl Depth: 48		2 nd Fl Width: 61	
2 nd Fl Depth: 48		Bsmt Width: 61		Bsmt Depth: 48	
Energy Method: <input type="checkbox"/> Prescriptive <input type="checkbox"/> Performance <input type="checkbox"/> UA Alternative <input type="checkbox"/> ERI			Gross Area: 32,051 sq ft		
			Occupiable Area: 4,371 sq ft		
AGREEMENT/ DISCALIMER <i>REQUIRED</i>					
THE UNDERSIGNED HEREBY CERTIFIES AND AGREES AS FOLLOWS: (1) THAT HE/SHE IS AUTHORIZED TO MAKE THIS APPLICATION; (2) THAT THE INFORMATION IS CORRECT; (3) THAT HE/SHE WILL COMPLY WITH ALL REGULATIONS OF HOWARD COUNTY WHICH ARE APPLICABLE THERETO; (4) THAT HE/SHE WILL PERFORM NO WORK ON THE ABOVE REFERENCED PROPERTY NOT SPECIFICALLY DESCRIBED IN THIS APPLICATION; (5) THAT HE/SHE GRANTS COUNTY OFFICIALS THE RIGHT TO ENTER ONTO THIS PROPERTY FOR THE PURPOSE OF INSPECTING THE WORK PERMITTED AND POSTING NOTICES.					
 APPLICANT'S ORIGINAL SIGNATURE				9/7/2021 DATE SIGNED	
FOR OFFICE USE ONLY <i>CHECKS PAYABLE TO: DIRECTOR OF FINANCE OF HOWARD COUNTY</i>					
AGENCIES REQUIRED/APPROVALS:					
<input type="checkbox"/> PR	<input type="checkbox"/> DPZ	<input type="checkbox"/> DED	<input checked="" type="checkbox"/> Health 9/29/2021	<input type="checkbox"/> SHA	<input type="checkbox"/> CID
SUBMITTAL FEES:		PAYMENT:		ACCEPTED BY:	

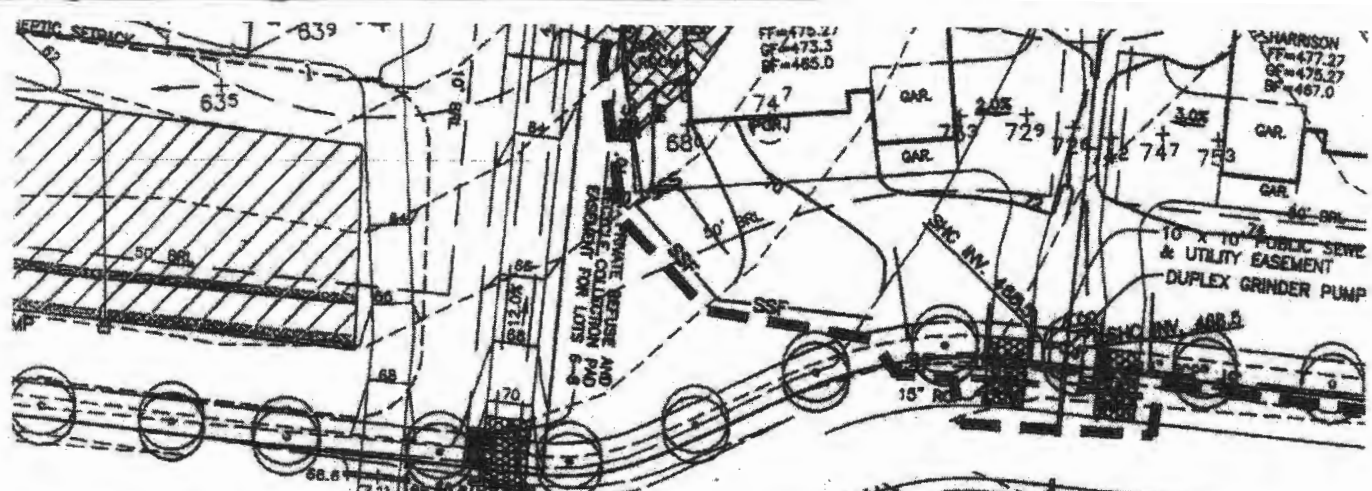

Hunters Views RD

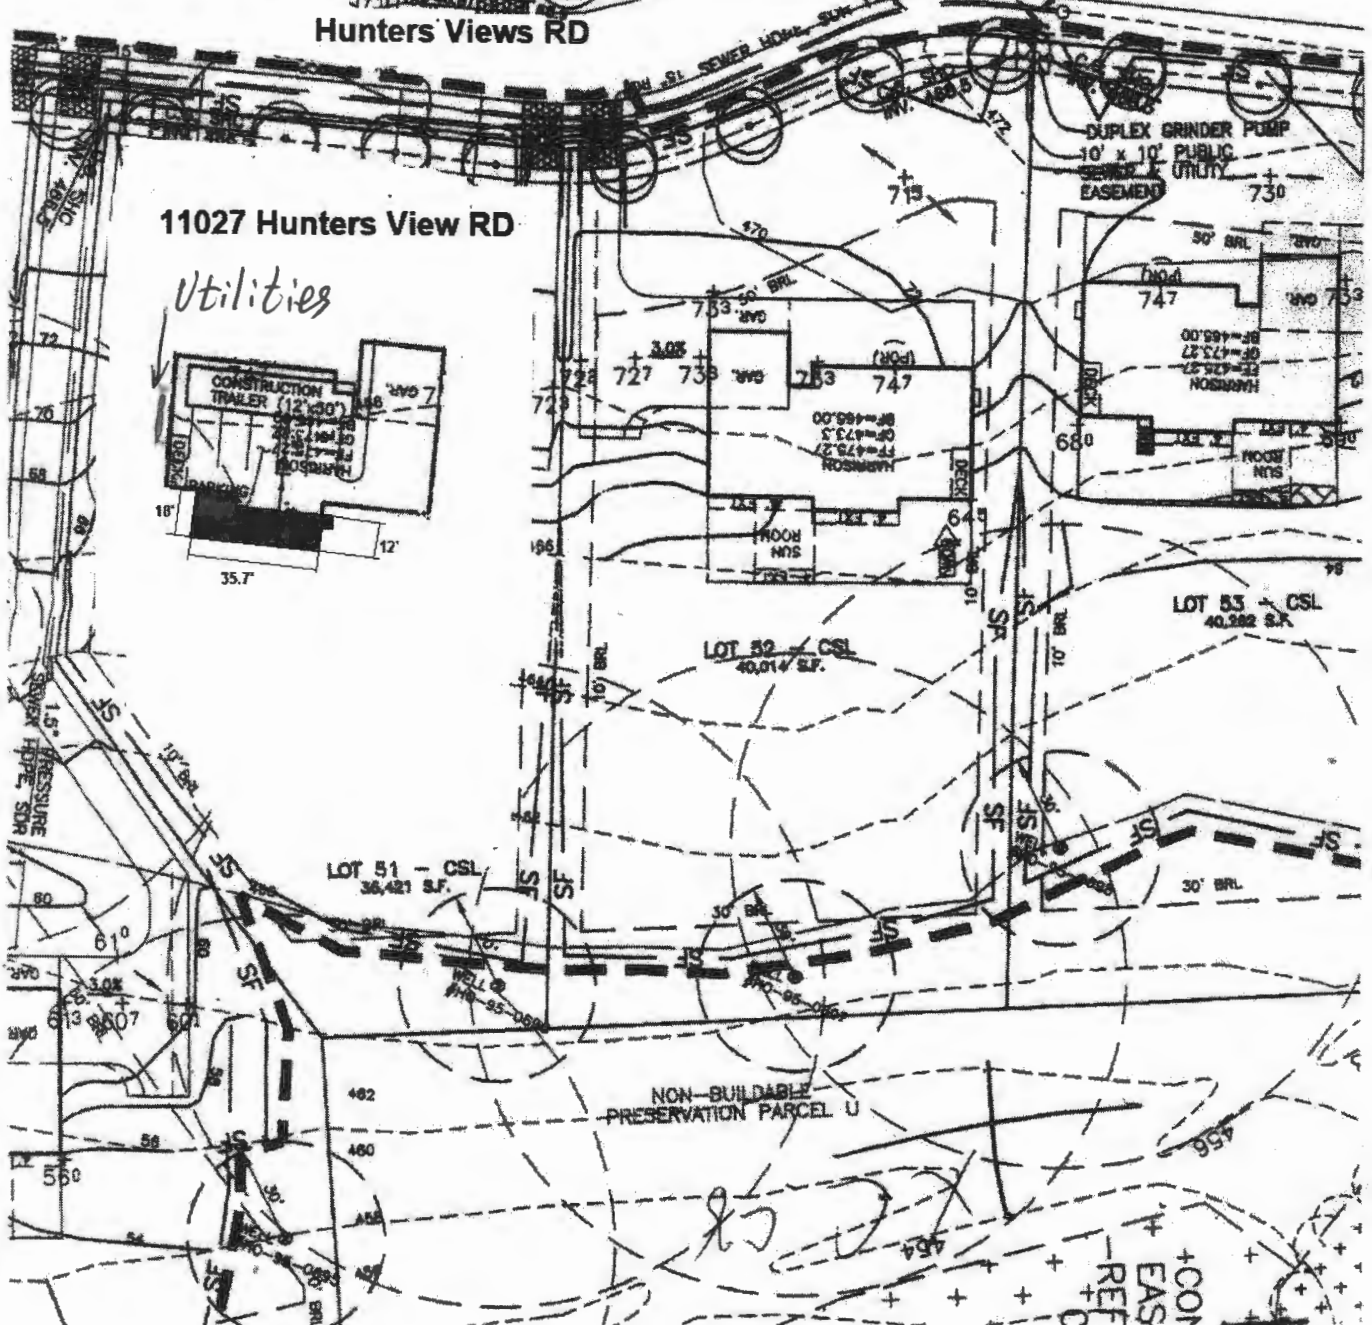

Approval B21003390
 RUC 9/28/2021