

# APPLICATION

SEWAGE DISPOSAL TESTING

STATE OF MARYLAND - DEPARTMENT OF HEALTH AND MENTAL HYGIENE

A 37517

P \_\_\_\_\_

HOWARD COUNTY HEALTH DEPARTMENT  
ENVIRONMENTAL HEALTH SERVICES  
P. O. BOX 473 ELLICOTT CITY, MARYLAND 21043  
TELEPHONE: 992-2330

DISTRICT \_\_\_\_\_

DATE 8/14/86

TO: THE COUNTY HEALTH OFFICER  
ELLICOTT CITY, MARYLAND

I, HEREBY, APPLY FOR THE NECESSARY TEST IN ORDER TO CONSTRUCT (OR RECONSTRUCT) A SEWAGE DISPOSAL SYSTEM.

PROPERTY OWNER J.J.M. Partnership Donald E + Patricia T. O'Connor

ADDRESS 5570-201 Sterrett Place PHONE 740-4466  
Columbia, Maryland 21045

PROPERTY LOCATION: LOT 21 on prelin

SUBDIVISION Chapel Woods II LOT NO. 20 LOT 21 on 2ND Prelin

ROAD AND DESCRIPTION West side of Middle Patuxent; North of Route 108

(11807 Shepards Crossing Court)

**OLD. PERMIT SIGNED**

**AND RETURNED 4-7-88**

Serial # 1574110523  
residential - 5BR

SIZE OF LOT 3.88 ac. TYPE BLDG. \_\_\_\_\_

(NUMBER OF BEDROOMS)

THE SYSTEM INSTALLED UNDER THIS APPLICATION IS ACCEPTABLE ONLY UNTIL PUBLIC FACILITIES BECOME AVAILABLE. I FULLY UNDERSTAND THE FEE CONNECTED WITH THE FILING OF THIS PERC TEST APPLICATION IS NON-REFUNDABLE UNDER ANY CIRCUMSTANCES. I ALSO AGREE TO COMPLY WITH ALL M.O.S.H.A. REQUIREMENTS IN TESTING THIS LOT.

John Mikolasko  
(SIGNATURE OF APPLICANT)

APPROVED BY Sidney Abel FOR Standard Permit DATE 7-24-89

REJECTED BY \_\_\_\_\_ FOR \_\_\_\_\_ DATE \_\_\_\_\_


HOLD PENDING FURTHER TESTS \_\_\_\_\_ DATE \_\_\_\_\_

REASONS FOR REJECTION OR HOLDING 9-10-86 Rec SATISFACTORY; Hold For Subdivision PLANS S. Abel

# THIS IS NOT A PERMIT

ⓓ ⓑ  
SOIL PROFILE

0  
4"  
3.5'  
to 4'  
A1-3  
RED BROWN  
SILT LOAM  
9-12% CLAY  
<10% FRAGS  
Yellow BC  
SAND SILT  
10-15%  
FRAGS.

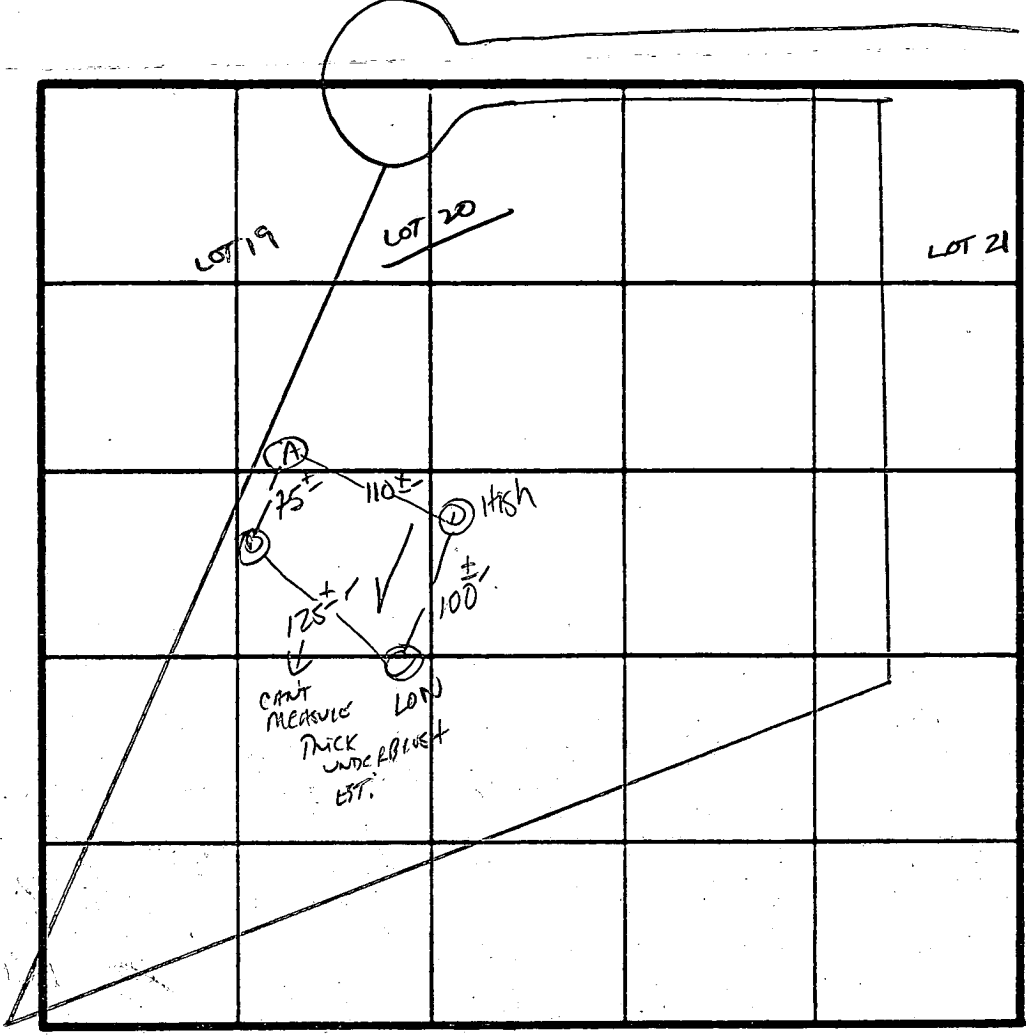

$\bar{X} = 10$   
INLET 4  
MAX 6 1/2

INDICATE NORTH - NAME ADJOINING ROADWAY AS BASE LINE.

0  
4"  
3.5'  
13'  
ⓐ ⓑ  
A1-3  
Yellow BC. Silt  
LOAM 9-12%  
CLAY <10%  
FRAGS  
Yellow BR  
SAND LOAM  
10-15%  
FRAGMENTS  
SMALL  
ROCK LAYER  
AT 5'

DATE	TEST NO.	DEPTH	PRE-WET		TEST - 1" DROP		TIME
			START	STOP	START	STOP	
9/10/86	D S M	3.5	11:16	11:19	11:19	11:22	3 MIN
		7.5	11:16	11:24	11:24		
	D V	13	UNIFORM SOIL BELOW 3.5'				
	C S	3.5	11:23	11:37	11:37	12:05	28 MIN
	C V	13	UNIFORM SOIL BELOW 3.5' w/ SMALL ROCK LAYER AT 5'				
	A S	5.0	11:48	11:52	11:52	11:58	6 MIN
	A V	12.5	UNIFORM SOIL BELOW 4.0 - 4.5'				
	B S	4.5	11:31	11:33	11:33	11:36	3 MIN
	B V	12.5	UNIFORM SOIL BELOW 4'				

REMARKS HOLE APPROX TO PLAT  
 TYPE OF SOIL CHESTER / MANDRA  
 TESTED BY S. Abel ALSO PRESENT HO / OWEN / DEVELOP.

EH 12 1079