

Heath

U. Was AT Cottontail Cree


PERMIT NUMBER: B 20000263

DATE ACCEPTED:

RESIDENTIAL BUILDING PERMIT APPLICATION					
HOWARD COUNTY DEPARTMENT OF INSPECTIONS, LICENSES, AND PERMITS 3430 COURT HOUSE DRIVE, ELLICOTT CITY, MD 21043 - PHONE: (410) 313-2455 OPTION #4 www.howardcountymd.gov					
BUILDING SITE ADDRESS REQUIRED					
Street Address: 15122 Players Way					
City: Glenwood		State: MD		Unit:	
Subdivision/Village/Complex Name:				Zip Code: 21738	
Lot: 8	Tax Map:	Parcel: 0229	SDP/WP/BA #:		
Grading Permit #:					
DESCRIPTION OF WORK REQUIRED					
Existing Use: Open		Proposed Use: Deck		Estimated Cost: \$29,390.00	
Trade Work to Be Completed (Separate Permits Required): <input type="checkbox"/> Mechanical (HVAC) <input type="checkbox"/> Electrical <input type="checkbox"/> Plumbing <input checked="" type="checkbox"/> None					
PROPERTY OWNER INFORMATION REQUIRED					
Owner(s) Name(s) (As it appears on tax records): Janice Ulrich					
Owner's Street Address: 15122 Players Way				Primary Residence: <input checked="" type="checkbox"/> Yes <input type="checkbox"/> No	
City: Glenwood		State: MD		Zip Code: 21738	
Phone: (443) 745-0759		Email: julrichilc@verizon.net			
APPLICANT NAME REQUIRED - INDIVIDUAL WHO SIGNS THIS APPLICATION					
Business Name: WCI, Inc. DBA Archadeck			Contact Name: Justin Dunkelberger		
Street Address: 8302 Brink Road					
City: Galthersburg		State: MD		Zip Code: 20882	
Phone: (570) 490-2789		Email: dunk@archadeck.net			
CONTRACTOR INFORMATION REQUIRED					
Business Name: WCI, Inc.					
Licensee's Name: John Barrett			License #: 121329		
Street Address: 8302 Brink Road					
City: Galthersburg		State: MD		Zip Code: 20882	
Phone: (301) 926-3001		Email: centralmaryland@archadeck.net			
ARCHITECT/ENGINEER INFORMATION INDIVIDUAL WHO SIGNED PLANS, IF APPLICABLE					
Business Name:			Name:		
Street Address:					
City:		State:		Zip Code:	
Phone:		Email:			
BUILDING CHARACTERISTICS REQUIRED					
Primary Structure: <input type="checkbox"/> SF Dwelling <input checked="" type="checkbox"/> SF Townhouse <input type="checkbox"/> SF Duplex <input type="checkbox"/> Mobile Home <input type="checkbox"/> Multi-Family Dwelling (MF*) <input type="checkbox"/> Condo: <input type="checkbox"/> Yes <input type="checkbox"/> No					
Utilities: <input type="checkbox"/> Electric <input type="checkbox"/> Gas		Water Supply: <input checked="" type="checkbox"/> Public <input type="checkbox"/> Private (Well)		Sewage Disposal: <input type="checkbox"/> Public <input type="checkbox"/> Private (Septic)	
Heating System: <input type="checkbox"/> Electric <input type="checkbox"/> Natural Gas <input type="checkbox"/> Propane <input type="checkbox"/> Other:			Roadside Tree Project: <input type="checkbox"/> No <input type="checkbox"/> Yes: #		
Sprinkler System: <input type="checkbox"/> NFPA 13 <input type="checkbox"/> NFPA 13R <input type="checkbox"/> NFPA 13D <input type="checkbox"/> None			Fire Alarm System: <input type="checkbox"/> Yes <input type="checkbox"/> No <input type="checkbox"/> Voice Evac		
ADDITIONAL RESIDENTIAL INFORMATION (PLEASE SELECT/COMPLETE ALL THAT APPLY)					
Model Name & Options:					
# of Bedrooms (SF):	# of efficiency units (MF*):	# of 1 BR (MF*):	# of 2 BR (MF*):	# of 3 BR (MF*):	
# Rooms:	# Full Baths:	# Half Baths:	# Fireplaces:		
Garage/Carport Info: <input type="checkbox"/> Attached Garage <input type="checkbox"/> Detached Garage <input type="checkbox"/> Integral Garage <input type="checkbox"/> Carport <input type="checkbox"/> None					
Basement/Foundation Info: <input type="checkbox"/> Slab on Grade <input type="checkbox"/> Post & Pier <input type="checkbox"/> Unfinished Basement <input type="checkbox"/> Finished Basement: <input type="checkbox"/> Full or <input type="checkbox"/> Partial					
1 st Fl Width:		1 st Fl Depth:		2 nd Fl Width:	
2 nd Fl Depth:		Bsmt Width:		Bsmt Depth:	
Energy Method: <input type="checkbox"/> Prescriptive <input type="checkbox"/> Performance <input type="checkbox"/> UA Alternative <input type="checkbox"/> ERI		Gross Area:		Occupable Area:	
		sq ft		sq ft	
AGREEMENT/ DISCALIMER REQUIRED					
THE UNDERSIGNED HEREBY CERTIFIES AND AGREES AS FOLLOWS: (1) THAT HE/SHE IS AUTHORIZED TO MAKE THIS APPLICATION; (2) THAT THE INFORMATION IS CORRECT; (3) THAT HE/SHE WILL COMPLY WITH ALL REGULATIONS OF HOWARD COUNTY WHICH ARE APPLICABLE THERETO; (4) THAT HE/SHE WILL PERFORM NO WORK ON THE ABOVE REFERENCED PROPERTY NOT SPECIFICALLY DESCRIBED IN THIS APPLICATION; (5) THAT HE/SHE GRANTS COUNTY OFFICIALS THE RIGHT TO ENTER ONTO THIS PROPERTY FOR THE PURPOSE OF INSPECTING THE WORK PERMITTED AND POSTING NOTICES.					
APPLICANT'S ORIGINAL SIGNATURE			DATE SIGNED		
			7-6-20		
FOR OFFICE USE ONLY					
AGENCIES REQUIRED/APPROVALS:					
CHECKS PAYABLE TO: DIRECTOR OF FINANCE OF HOWARD COUNTY					
<input checked="" type="checkbox"/> CRK	<input checked="" type="checkbox"/> DP2	<input checked="" type="checkbox"/> DPED	8/3/2020	<input type="checkbox"/> SHA	<input type="checkbox"/> CID
SUBMITTAL FEES:		PAYMENT: CK# 3601 \$ 2500 pd		ACCEPTED BY:	

RECEIVED
JUL 10 2020
LICENSES & PERMITS
DIVISION

STAGE 28
CONDOMINIUM PLAN, UNIT
THE VILLAGES AT CATHAL
CREEK
PLAT NOS. 10867 A

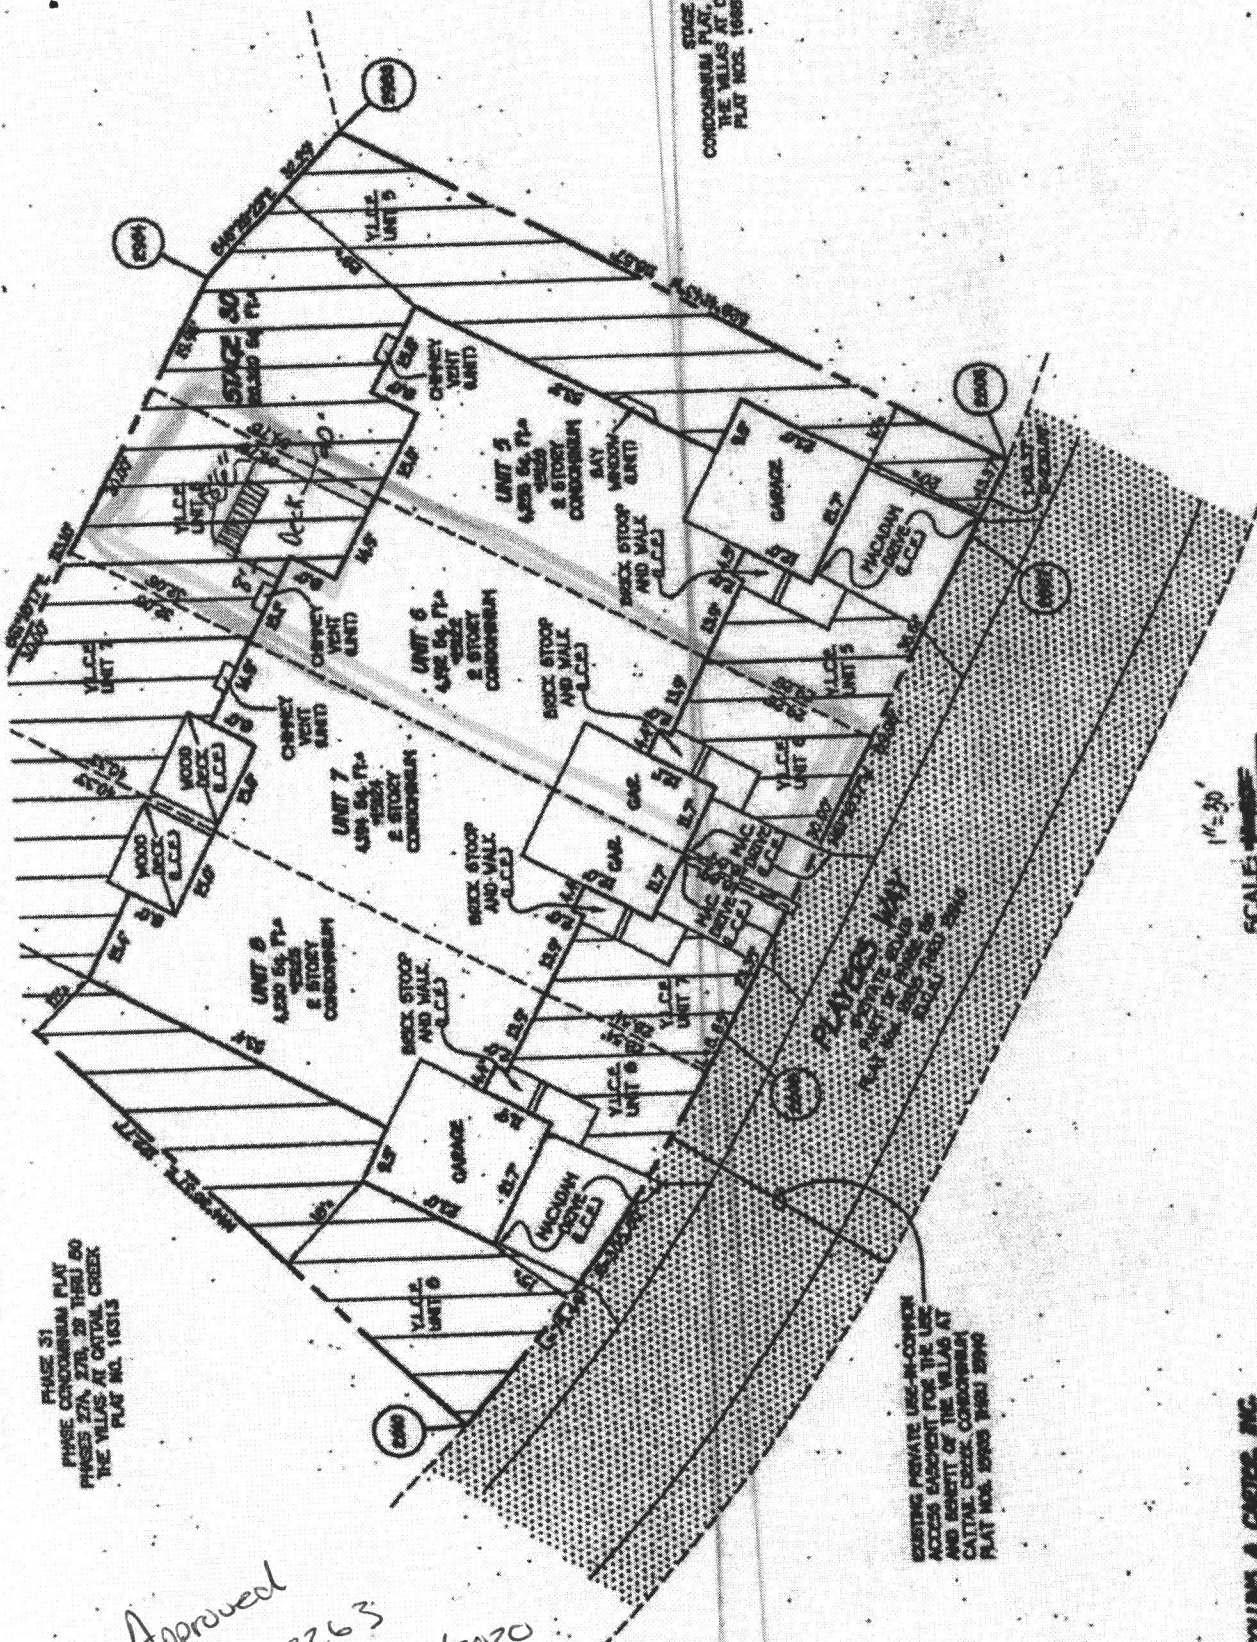

PHASE 31
PHASE CONDOMINIUM PLAN
PHASES 27A, 27B, 28, 29, 30, 31
THE VILLAGES AT CATHAL CREEK
PLAT NO. 10813

EXISTING PRIVATE USE-IN-COMMON
ACCESS EASEMENT FOR THE USE
AND BENEFIT OF THE VILLAGES AT
CATHAL CREEK CONDOMINIUM
PLAT NOS. 10813, 10814, 10815

Approved
1326002263
R/K 8/5/2020

1" = 30'

SCALE: 1" = 30'

FISHER COLLINS & CARRIS, INC.
CIVIL ENGINEERING, ARCHITECTURE & LAND SURVEYING
1000 W. 10TH STREET, SUITE 1000
DALLAS, TEXAS 75208-1000
TEL: 972-342-1000
FAX: 972-342-1001

Health


PERMIT NUMBER: B 20002263

DATE ACCEPTED:

RESIDENTIAL BUILDING PERMIT APPLICATION					
HOWARD COUNTY DEPARTMENT OF INSPECTIONS, LICENSES, AND PERMITS					
3430 COURT HOUSE DRIVE, ELLICOTT CITY, MD 21043 - PHONE: (410) 313-2455 OPTION #4					
www.howardcountymd.gov					
BUILDING SITE ADDRESS REQUIRED					
Street Address: 15122 Players Way					Unit:
City: Glenwood			State: MD		Zip Code: 21738
Subdivision/Village/Complex Name:				SDP/WP/BA #:	
Lot: 6	Tax Map:	Parcel: 0229	Grading Permit #:		
DESCRIPTION OF WORK REQUIRED					
Existing Use: Open		Proposed Use: Deck		Estimated Cost: \$29,390.00	
Trade Work to Be Completed (Separate Permits Required): <input type="checkbox"/> Mechanical (HVAC) <input type="checkbox"/> Electrical <input type="checkbox"/> Plumbing <input checked="" type="checkbox"/> None					
PROPERTY OWNER INFORMATION REQUIRED					
Owner(s) Name(s) (As it appears on tax records): Janice Ulrich				Primary Residence: <input checked="" type="checkbox"/> Yes <input type="checkbox"/> No	
Owner's Street Address: 15122 Players Way					
City: Glenwood			State: MD		Zip Code: 21738
Phone: (443) 745-0759			Email: julrichllc@verizon.net		
APPLICANT NAME REQUIRED - INDIVIDUAL WHO SIGNS THIS APPLICATION					
Business Name: WCI, Inc. DBA Archadeck			Contact Name: Justin Dunkelberger		
Street Address: 8302 Brink Road					
City: Galthersburg			State: MD		Zip Code: 20882
Phone: (570) 490-2789			Email: jdunk@archadeck.net		
CONTRACTOR INFORMATION REQUIRED					
Business Name: WCI, Inc.					
Licensee's Name: John Barrett			License #: 121329		
Street Address: 8302 Brink Road					
City: Galthersburg			State: MD		Zip Code: 20882
Phone: (301) 926-3001			Email: centralmaryland@archadeck.net		
ARCHITECT/ENGINEER INFORMATION INDIVIDUAL WHO SIGNED PLANS, IF APPLICABLE					
Business Name:			Name:		
Street Address:					
City:			State:		Zip Code:
Phone:			Email:		
BUILDING CHARACTERISTICS REQUIRED					
Primary Structure: <input type="checkbox"/> SF Dwelling <input checked="" type="checkbox"/> SF Townhouse <input type="checkbox"/> SF Duplex <input type="checkbox"/> Mobile Home <input type="checkbox"/> Multi-Family Dwelling (MF*)					Condo: <input checked="" type="checkbox"/> Yes <input type="checkbox"/> No
Utilities: <input type="checkbox"/> Electric <input type="checkbox"/> Gas		Water Supply: <input checked="" type="checkbox"/> Public <input type="checkbox"/> Private (Well)		Sewage Disposal: <input checked="" type="checkbox"/> Public <input type="checkbox"/> Private (Septic)	
Heating System: <input type="checkbox"/> Electric <input type="checkbox"/> Natural Gas <input type="checkbox"/> Propane <input type="checkbox"/> Other:				Roadside Tree Project: <input checked="" type="checkbox"/> No <input type="checkbox"/> Yes: #	
Sprinkler System: <input type="checkbox"/> NFPA 13 <input type="checkbox"/> NFPA 13R <input type="checkbox"/> NFPA 13D <input type="checkbox"/> None			Fire Alarm System: <input checked="" type="checkbox"/> Yes <input type="checkbox"/> No <input type="checkbox"/> Voice Evac		
ADDITIONAL RESIDENTIAL INFORMATION (PLEASE SELECT/COMPLETE ALL THAT APPLY)					
Model Name & Options:					
# of Bedrooms (SF):		# of efficiency units (MF*):		# of 1 BR (MF*):	
# of 2 BR (MF*):		# of 3 BR (MF*):		# of Fireplaces:	
# Rooms:		# Full Baths:		# Half Baths:	
Garage/Carport Info: <input type="checkbox"/> Attached Garage <input type="checkbox"/> Detached Garage <input type="checkbox"/> Integral Garage <input type="checkbox"/> Carport <input type="checkbox"/> None					
Basement/Foundation Info: <input type="checkbox"/> Slab on Grade <input type="checkbox"/> Post & Pier <input type="checkbox"/> Unfinished Basement <input type="checkbox"/> Finished Basement: <input type="checkbox"/> Full or <input type="checkbox"/> Partial					
1 st Fl Width:		1 st Fl Depth:		2 nd Fl Width:	
2 nd Fl Depth:		Bsmt Width:		Bsmt Depth:	
Energy Method: <input type="checkbox"/> Prescriptive <input type="checkbox"/> Performance <input type="checkbox"/> UA Alternative <input type="checkbox"/> ERI			Gross Area: sq ft		
Occupable Area: sq ft					
AGREEMENT/ DISCALIMER REQUIRED					
THE UNDERSIGNED HEREBY CERTIFIES AND AGREES AS FOLLOWS: (1) THAT HE/SHE IS AUTHORIZED TO MAKE THIS APPLICATION; (2) THAT THE INFORMATION IS CORRECT; (3) THAT HE/SHE WILL COMPLY WITH ALL REGULATIONS OF HOWARD COUNTY WHICH ARE APPLICABLE THERETO; (4) THAT HE/SHE WILL PERFORM NO WORK ON THE ABOVE REFERENCED PROPERTY NOT SPECIFICALLY DESCRIBED IN THIS APPLICATION; (5) THAT HE/SHE GRANTS COUNTY OFFICIALS THE RIGHT TO ENTER ONTO THIS PROPERTY FOR THE PURPOSE OF INSPECTING THE WORK PERMITTED AND POSTING NOTICES.					
APPLICANT'S ORIGINAL SIGNATURE				DATE SIGNED	
				7-6-20	
FOR OFFICE USE ONLY					
CHECKS PAYABLE TO: DIRECTOR OF FINANCE OF HOWARD COUNTY					
AGENCIES REQUIRED/APPROVALS:					
<input type="checkbox"/> DMR	<input type="checkbox"/> DPZ	<input type="checkbox"/> PDED	<input checked="" type="checkbox"/> Health	<input type="checkbox"/> SHA	<input type="checkbox"/> CID
SUBMITTAL FEES:		PAYMENT: \$3601		ACCEPTED BY:	
		\$2500 pd		[Signature]	

RECEIVED
JUL 10 2020
LICENSES & PERMITS
DIVISION

PHASE 31
 PHASE CONDOMINIUM PLAN
 PHASES 27A, 27B, 28 THRU 30
 THE VILLAGES AT CATALINA CREEK
 PLAT NO. 16313

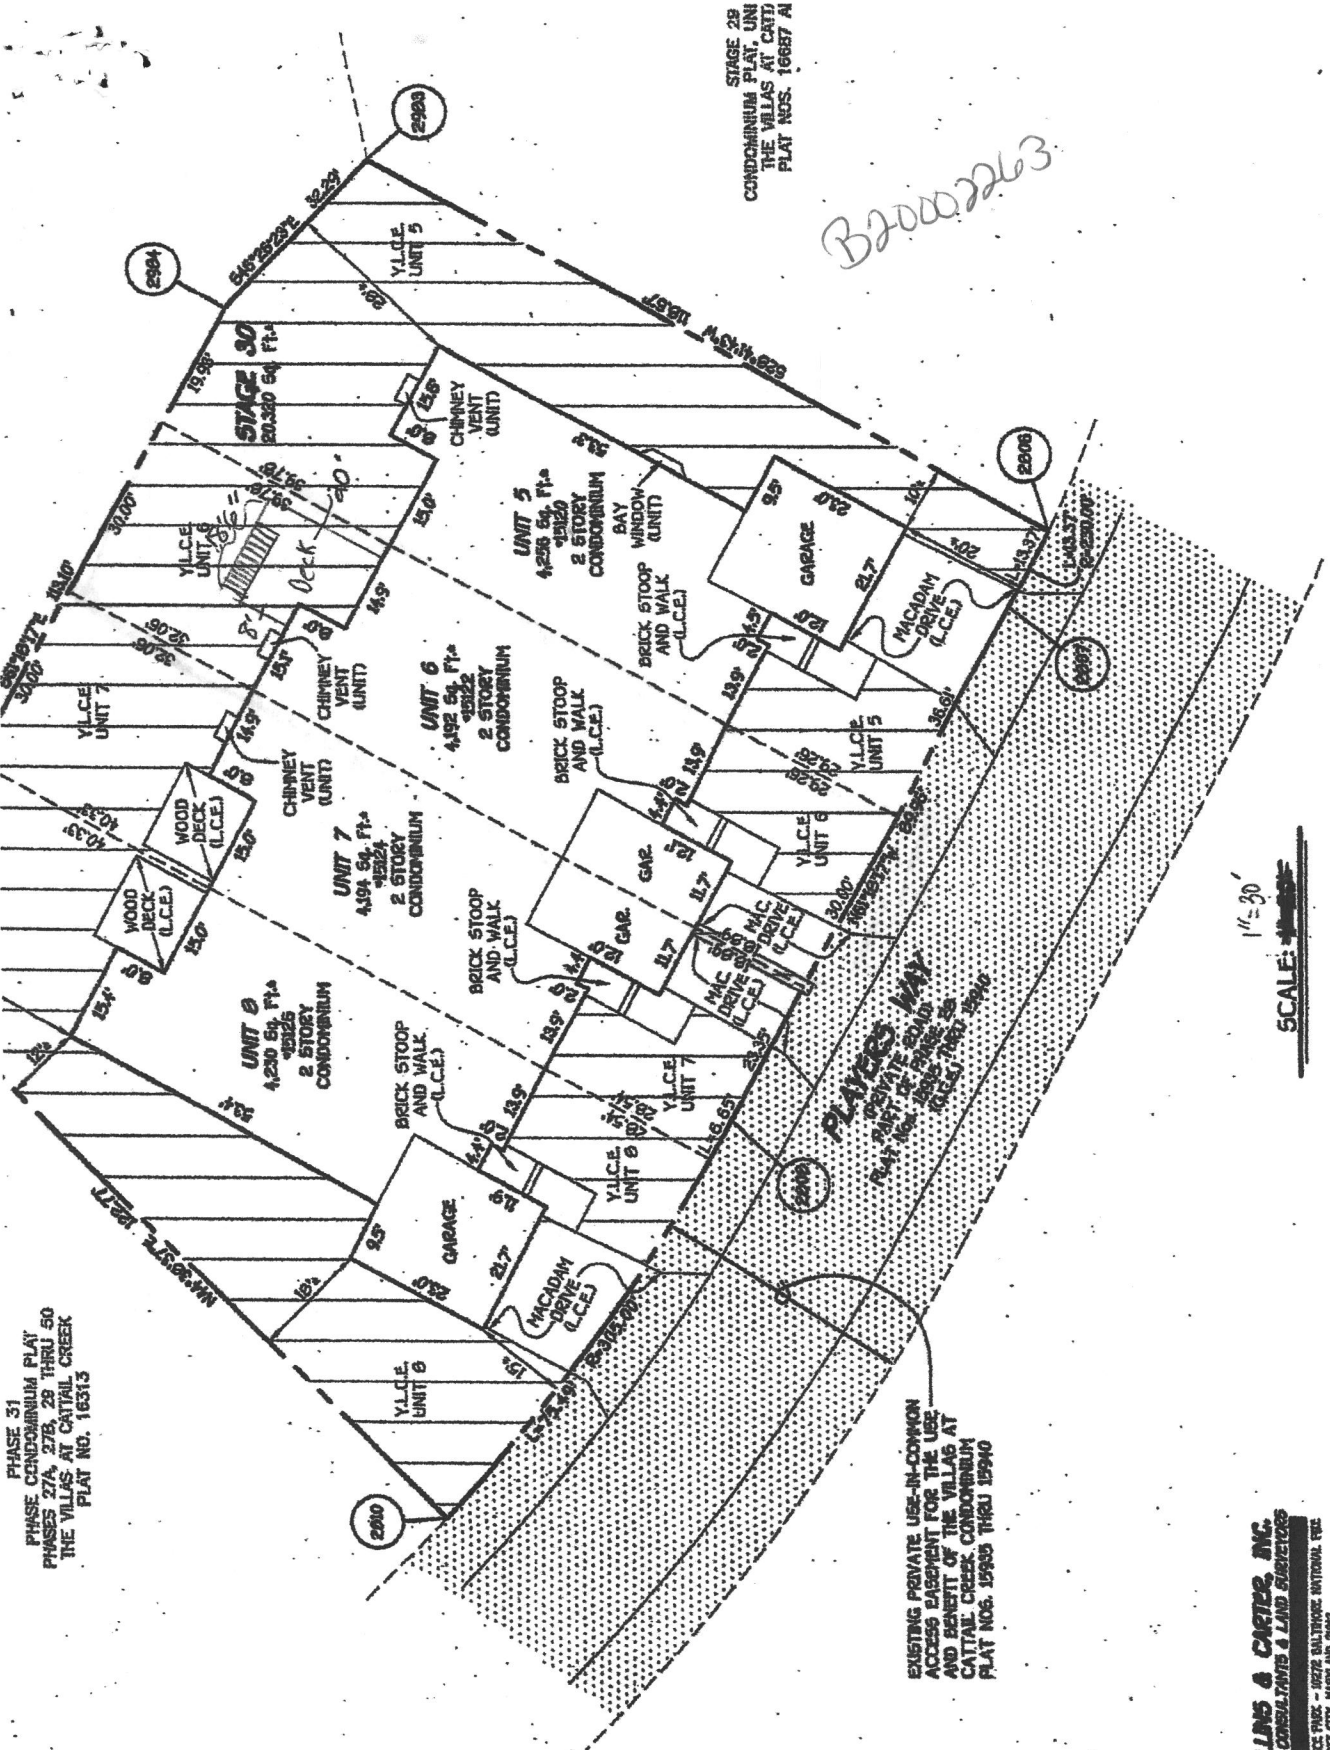

STAGE 29
 CONDOMINIUM PLAN, UNIT
 THE VILLAGES AT CATALINA
 PLAT NOS. 16687 A1

B2002263

1" = 30'
 SCALE: ~~AS SHOWN~~

EXISTING PRIVATE USE-IN-COMMON
 ACCESS EASEMENT FOR THE USE
 AND BENEFIT OF THE VILLAGES AT
 CATALINA CREEK CONDOMINIUM
 PLAT NOS. 15965 THRU 15990

FISHER, COLLINS & CARTER, INC.
 CIVIL ENGINEERING CONSULTANTS & LAND SURVEYORS
 CENTENNIAL SQUARE OFFICE PARK - 16275 BALTIMORE NATIONAL EYE
 ELLSWORTH CITY, MARYLAND 21115
 (410) 481-2225

Oswald, Hank

From: Justin Dunkleberger <JDunk@archadeck.net>
Sent: Tuesday, August 4, 2020 11:06 AM
To: Oswald, Hank
Subject: Video of Sewer and water lines for 15122 Players Way Unit 6 Glenwood
Attachments: Ulrich video 2.eml

[Note: This email originated from outside of the organization. Please only click on links or attachments if you know the sender.]

Attached is a video showing the lines in front of the home with the trunk lines run along the street and shut off valves in the driveway and yard. This is email 1 of 2

Please confirm receipt of this email and if this is adequate.

They do not have any drawings showing this, but the homeowner has mentioned they are the last person on the street to get a deck, so many others have had to answer this question with the same answer previously.

Justin
Archadeck