

Menu Save Reset Cancel Help

Record Detail * (This section is required.)

Permit Type	Permit Number	Opened Date
Building/Residential/Misc/Tanks	B20004071	11/20/2020
Description of Work		
SFD/INSTALL (1) 1000 GALLON PROPANE TANK		

[check spelling](#)

Address * (This section is required.)

Search Reset Clear Get Parcel & Owner

Street #	Street Name	Street Type	
1611	OLD ANNAPOLIS	RD	
Unit Type	Unit #	X Coordinate	Y Coordinate
-Select-		-77.106	39.32705
City	State	Zip Code	Primary
WOODBINE	MD	21797	Yes

Approved
11/30/20
DKP & EH Accel
RHS

Parcel * (This section is required.)

Search Reset Clear Get Address & Owner

GIS ID *	Parcel	Parcel Area	Land Value	Improved Value	Exemption Value	Plan Area
1103890	353	3.24	196800	196800	0	RURAL
Legal Description						
LOT 1 3.2437 A.[]1611 OLD ANNAPOLIS RD[]VU PROP						

[check spelling](#)

Block	Lot	Census Tract	Council Dist	Inspection Dist	Supervisor Dist	Map #	DAP Zone
	1	604001	5				
Plan Area	State Tax Id	Subdivision Name					
	1404597876	Vu Property					
Section	Area	Tax Map					
		7					
Grid	Zoning District	ADC Map					
7-15	RC-DEO	4691-C8					
SDP No.	Final Plan No.	WP File No.					
	ECP-14-008						
Record Plat No.	WS Contract No.	FDP No.	Primary				
23308			Yes				
Owner Occupied	Year Built	Historic District					
<input type="radio"/> Yes <input checked="" type="radio"/> No		<input type="radio"/> Yes <input checked="" type="radio"/> No					
Historic District Registry No.	Stat Area	Flood Plain					
	4-05	<input type="radio"/> Yes <input checked="" type="radio"/> No					
Building No							

Owner * (This section is required.)

Search Reset Clear

Name *

Amanda Brong		
Address Line 1		
10755 FOLKESTONE WAY		
Address Line 2		
Address Line 3		
Mail City	Mail State	Mail Zip Code
Woodstock	MD <input type="checkbox"/>	21163
Phone	Primary	
240-215-7952	Yes <input checked="" type="checkbox"/>	
E-mail		
ESWARTZ@GMAIL.COM		
Cell Number	Fax Number	

Professionals (This section is not required.)

Search Reset Clear

License # *	Business Name		
20100079809	AERO ENERGY		
License Type *	First Name	Middle Name	Last Name
Propane Gs <input checked="" type="checkbox"/>	3ICHARD	THOMAS	JARCY
Primary	Address Line 1		
Yes <input checked="" type="checkbox"/>	230 LINCOLN WAY EAST		
Address Line 2			
City		State	ZIP Code
NEW OXFORD		PA	17350-0000
Phone 1	Phone 2	Fax	
2406744592		3016620709	
E-mail			
RJARCJ@AEROENERGY.COM			

Applicant (This section is not required.)

Search As Owner As Lic. Prof As Contact

Type *	First Name	MI	Last Name
Applicant <input checked="" type="checkbox"/>	steve		dannenfeldt
Relationship	Full Name		
-Select- <input checked="" type="checkbox"/>	steve dannenfeldt		
Primary	Organization Name		
Yes <input checked="" type="checkbox"/>	Aero Energy		
Street Address			
230 lincoln way East			
Address Line 2			
City		State	Zip Code
New Oxford		PA <input checked="" type="checkbox"/>	17350
Phone	Cell	Fax	
717-577-5923			
E-mail *			
sdannenfeldt@aeroenergy.com			

Addtl Info

Est Construction Cost *	Housing Units *	Number of Buildings *	Public Owned
3500	0	0	No
Construction Type			
--Select--			

TANK INFORMATION

RESIDENTIAL TANK INFORMATION

Capital Project-No Fee *	Capital Project Number	Fee Exempt *	Roadside Tree Project Permit *	Roadside Tree Permit #
<input type="radio"/> Yes <input checked="" type="radio"/> No		<input type="radio"/> Yes <input checked="" type="radio"/> No	<input type="radio"/> Yes <input checked="" type="radio"/> No	
Existing Use	Number of Tanks Installed *	Number of Tanks Removed *		
SFD	1	0		
Water Supply	Sewage Disposal	Expiration Date	Relocate Existing Tank *	
Private	Private	5/29/2021	0	

PAYMENT INFORMATION

Check 1	Payee 1	Check 2	Payee 2	SAP Doc No	SAP Entered

Submit Cancel

THE ENGINEER HAS REVIEWED THIS PLAN AND HAS FOUND IT TO BE IN ACCORDANCE WITH THE REQUIREMENTS OF THE PUBLIC HEALTH DEPARTMENT AND THE BOARD OF HEALTH.


THIS PLAN IS SUBJECT TO THE APPROVAL OF THE BOARD OF HEALTH.

THE BOARD OF HEALTH HAS THE RIGHT TO REQUIRE ANY CHANGES TO THIS PLAN AT ANY TIME.

THIS PLAN IS SUBJECT TO THE APPROVAL OF THE BOARD OF HEALTH.

DS
DB

Designed by
Amanda Brown
594-U3A8481A82C

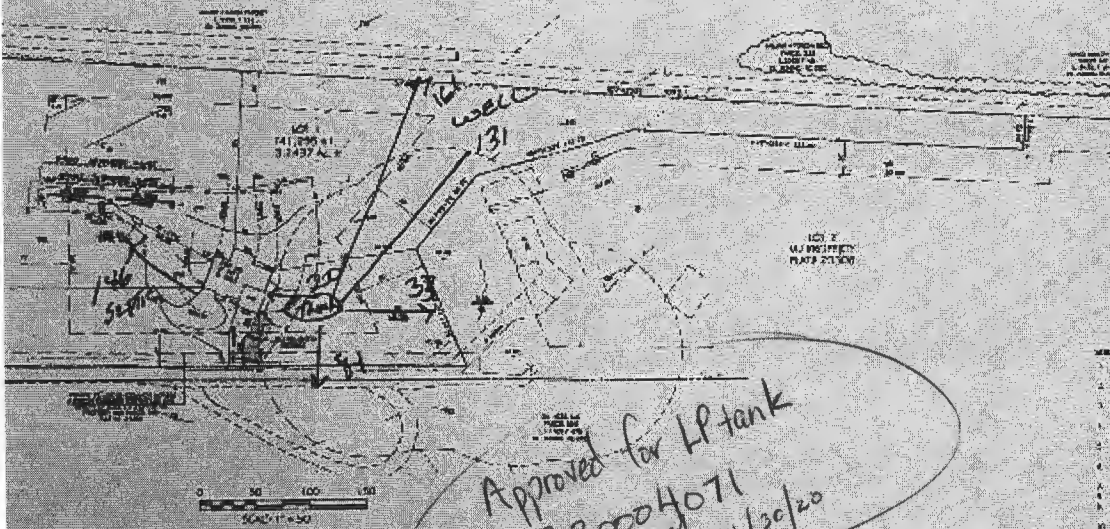


Approved for LP tank
B20004071
K/H 11/30/20

- REVISIONS TO SPECIFICATIONS
1. CHANGE ALL DIMENSIONS TO MATCH APPROVED AND REVISED PLANS AND SPECIFICATIONS. (1 POINT)
 2. CHANGE ALL DIMENSIONS TO MATCH APPROVED AND REVISED PLANS AND SPECIFICATIONS. (1 POINT)
 3. CHANGE ALL DIMENSIONS TO MATCH APPROVED AND REVISED PLANS AND SPECIFICATIONS. (1 POINT)
 4. CHANGE ALL DIMENSIONS TO MATCH APPROVED AND REVISED PLANS AND SPECIFICATIONS. (1 POINT)
 5. CHANGE ALL DIMENSIONS TO MATCH APPROVED AND REVISED PLANS AND SPECIFICATIONS. (1 POINT)
 6. CHANGE ALL DIMENSIONS TO MATCH APPROVED AND REVISED PLANS AND SPECIFICATIONS. (1 POINT)
 7. CHANGE ALL DIMENSIONS TO MATCH APPROVED AND REVISED PLANS AND SPECIFICATIONS. (1 POINT)
 8. CHANGE ALL DIMENSIONS TO MATCH APPROVED AND REVISED PLANS AND SPECIFICATIONS. (1 POINT)
 9. CHANGE ALL DIMENSIONS TO MATCH APPROVED AND REVISED PLANS AND SPECIFICATIONS. (1 POINT)
 10. CHANGE ALL DIMENSIONS TO MATCH APPROVED AND REVISED PLANS AND SPECIFICATIONS. (1 POINT)

1611 Old Annapolis Road
LOT 1
WOODRIDGE MD 21797

Garage Right

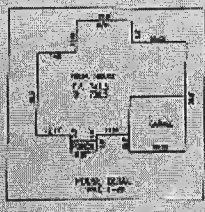


OWNER / DEVELOPER
BACH DAN WU
1000 BACH WU
20215 SANDRICK DR.
MONTICELLO VILLAGE, VA 22060
201-431-3888

PROF. PLAN AND SETBACK CONTROL PLAN
LOT 1 OLD ANNAPOLES ROAD
LOT 1
WU PROPERTY
PLAN No. 21578

YANMAR ASSOCIATES, INC.
LANDSCAPE ARCHITECTS PLANNERS
1000 BACH WU
MONTICELLO VILLAGE, VA 22060
703-555-2000

TANK TO HOUSE 20'
TANK TO WELL 131
TANK TO SEPTIC TANK 146'

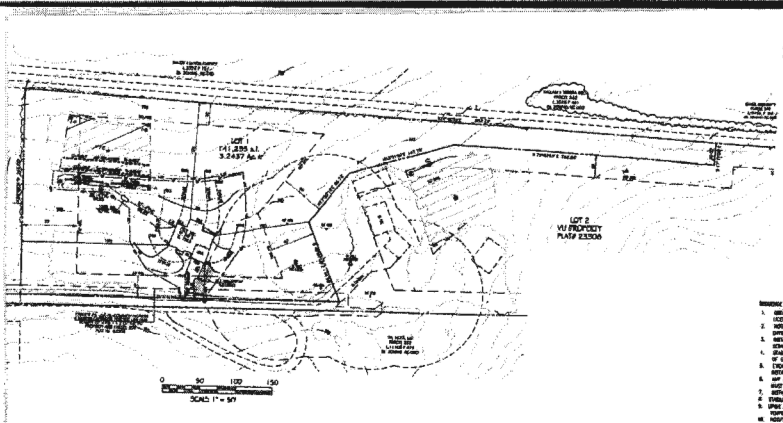


- 1. ALL DIMENSIONS SHALL BE AS SHOWN UNLESS OTHERWISE NOTED.
- 2. ALL DIMENSIONS SHALL BE TO THE CENTERLINE OF THE ROAD UNLESS OTHERWISE NOTED.
- 3. ALL DIMENSIONS SHALL BE TO THE CENTERLINE OF THE ROAD UNLESS OTHERWISE NOTED.
- 4. ALL DIMENSIONS SHALL BE TO THE CENTERLINE OF THE ROAD UNLESS OTHERWISE NOTED.
- 5. ALL DIMENSIONS SHALL BE TO THE CENTERLINE OF THE ROAD UNLESS OTHERWISE NOTED.

DB

Designed by:
Amanda Brown
 52462348491A480

- REVISIONS TO CONSTRUCTION
1. REVISION 01: REVISIONS TO THE PLAN, APPROVED BY THE LOCAL AUTHORITY AND THE LOCAL COUNCIL.
 2. REVISION 02: REVISIONS TO THE PLAN, APPROVED BY THE LOCAL AUTHORITY AND THE LOCAL COUNCIL.
 3. REVISION 03: REVISIONS TO THE PLAN, APPROVED BY THE LOCAL AUTHORITY AND THE LOCAL COUNCIL.
 4. REVISION 04: REVISIONS TO THE PLAN, APPROVED BY THE LOCAL AUTHORITY AND THE LOCAL COUNCIL.
 5. REVISION 05: REVISIONS TO THE PLAN, APPROVED BY THE LOCAL AUTHORITY AND THE LOCAL COUNCIL.
 6. REVISION 06: REVISIONS TO THE PLAN, APPROVED BY THE LOCAL AUTHORITY AND THE LOCAL COUNCIL.
 7. REVISION 07: REVISIONS TO THE PLAN, APPROVED BY THE LOCAL AUTHORITY AND THE LOCAL COUNCIL.
 8. REVISION 08: REVISIONS TO THE PLAN, APPROVED BY THE LOCAL AUTHORITY AND THE LOCAL COUNCIL.
 9. REVISION 09: REVISIONS TO THE PLAN, APPROVED BY THE LOCAL AUTHORITY AND THE LOCAL COUNCIL.
 10. REVISION 10: REVISIONS TO THE PLAN, APPROVED BY THE LOCAL AUTHORITY AND THE LOCAL COUNCIL.

Garage Right

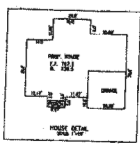

OWNER / DEVELOPER:
 VU PROPERTY
 10000 VU ROAD
 WINDSOR, ONTARIO
 L9A 4R1

DESIGNED BY:
 AMANDA BROWN
 52462348491A480

DATE: 10/10/2010

PROJECT: VU PROPERTY PLANS E2300

SCALE: 1" = 50'

PLANNING DEPARTMENT
 10000 VU ROAD
 WINDSOR, ONTARIO
 L9A 4R1

PLAT PLAN AND SEEDING CONTROL PLAN
 LOT 1 (141,259 SQ FT) AND LOT 2 (VU PROPERTY PLANS E2300)

VU PROPERTY
 PLANS E2300

VANMEER ASSOCIATES INC.
 10000 VU ROAD
 WINDSOR, ONTARIO
 L9A 4R1