

Approved 11/17/2020 - H.O.

Menu Save Reset Cancel Help

Record Detail \* (This section is required.)

Permit Type	Permit Number	Opened Date
Building/Residential/Misc/Porch	B20003979	11/13/2020
Description of Work		
SFD/BUILD APPROX. 22' X 47' DECK W/14'X16' SCREENED IN PORCH W/STEPS		

check spelling

Address \* (This section is required.)

Search Reset Clear Get Parcel & Owner

Street #	Street Name	Street Type	
4260	BUCKSKIN WOOD	DR	
Unit Type	Unit #	X Coordinate	Y Coordinate
--Select--		-76.97507	39.25626
City	State	Zip Code	Primary
ELLCOTT CITY	MD	21042	Yes

Parcel \* (This section is required.)

Search Reset Clear Get Address & Owner

GIS ID *	Parcel	Parcel Area	Land Value	Improved Value	Exemption Value	Plan Area
890633	77	1.01	300100	860100	560000	RURAL
Legal Description						
IMPSLOT 26 1.012 A[ 4260 BUCKSKIN WOOD DR[ ]BUCKSKIN RIDGE						

check spelling

Block	Lot	Census Tract	Council Dist	Inspection Dist	Supervisor Dist	Map #	DAP Zone
	26	605101	5				
Plan Area	State Tax Id	Subdivision Name					
	1405436664						
Section	Area	Tax Map					
		22					
Grid	Zoning District	ADC Map					
22-21	RR-DEO	4813-D10					
SDP No.	Final Plan No.	WP File No.					
	F-01-191						
Record Plat No.	WS Contract No.	FDP No.					
15522							
Owner Occupied	Year Built	Historic District					
<input type="radio"/> Yes <input type="radio"/> No	2008	<input type="radio"/> Yes <input checked="" type="radio"/> No					
Historic District Registry No.	Stat Area	Flood Plain					
	5-02A	<input type="radio"/> Yes <input checked="" type="radio"/> No					
Building No							

**Owner** \* (This section is required.)

Search      Reset      Clear

**Name** \*

KAGZI AYAZ G		
Address Line 1		
4260 BUCKSKIN WOOD DR		
Address Line 2		
Address Line 3		
Mail City	Mail State	Mail Zip Code
ELLCOTT CITY	MD	21042
Phone	Primary	
413-627-2640	Yes	
E-mail		
Cell Number	Fax Number	

**Professionals** (This section is not required.)

Search      Reset      Clear

License # *	Business Name		
08010020247	PRO BUILT CONSTRUCTION		
License Type *	First Name	Middle Name	Last Name
MHIC Ind	EDWARD		PACYLOWSKI
Primary	Address Line 1		
Yes	13330 CLARKSVILLE PIKE		
	Address Line 2		
	City	State	ZIP Code
	HIGHLAND	MD	207779701
	Phone 1	Phone 2	Fax
	3018540821		3018549632
	E-mail		
	OFFICE@PROBUILTCONSTRUCTION.COM		

**Applicant** (This section is not required.)

Search      As Owner      As Lic. Prof      As Contact

Type *	First Name	MI	Last Name
Applicant	EDWARD		PACYLOWSKI
Relationship	Full Name		
Applicant	EDWARD PACYLOWSKI		
Primary	Organization Name		
Yes	PRO BUILT CONSTRUCTION		
	Street Address		
	13330 CLARKSVILLE PIKE		
	Address Line 2		
	City	State	Zip Code
	HIGHLAND	MD	207779701
	Phone	Cell	Fax
	3018540821		3018549632
	E-mail *		

OFFICE@PROBUILTCONSTRUCTION.COM

Addtl Info

Est Construction Cost *	Housing Units *	Number of Buildings *	Public Owned
60000	0	0	No
Construction Type			
434 - Additions, Alterations and Conversions - Residential			

PORCH INFORMATION


PORCH INFORMATION

Capital Project-No Fee *	Capital Project Number	Fee Exempt *	Roadside Tree Project Permit *	Roadside Tree Project Permit #
<input type="radio"/> Yes <input checked="" type="radio"/> No		<input type="radio"/> Yes <input checked="" type="radio"/> No	<input type="radio"/> Yes <input checked="" type="radio"/> No	
Existing Use *	Type of Porch *	Type of Porch Foundation *	Total Square Footage *	
SFD	Screened Porch	New Deck	224 SQFT	
Water Supply	Sewage Disposal	Expiration Date		
Private	Private	5/15/2021		


PAYMENT INFORMATION

Check 1	Payee 1	Check 2	Payee 2	SAP Doc No	SAP Entered

Submit Cancel

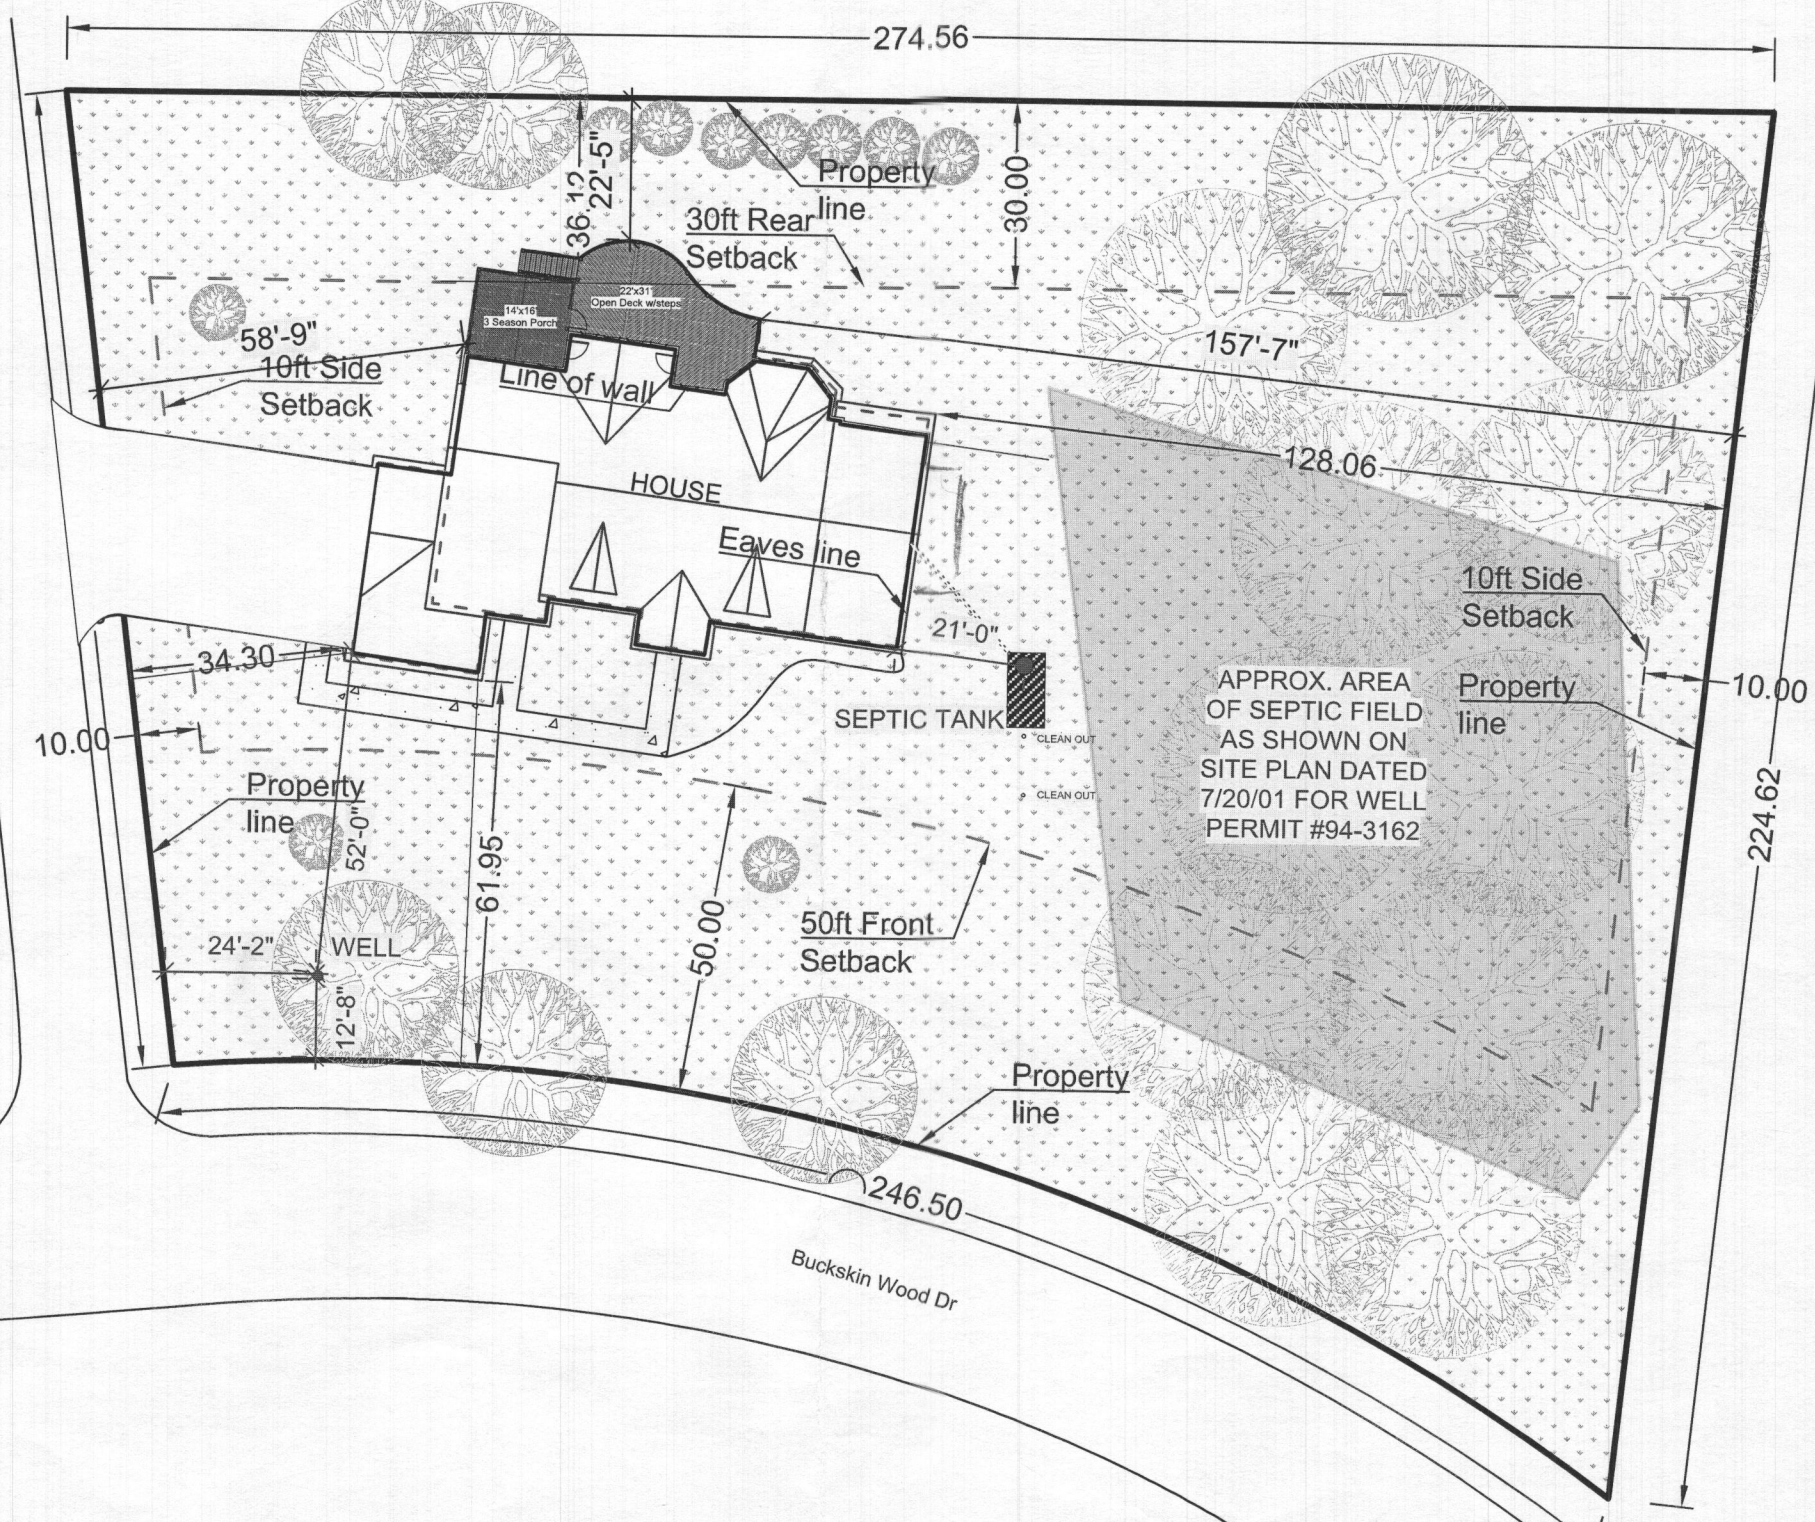

← SDA is it quite accurate, but close. (H.O)

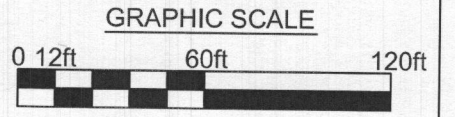

Address: 4260 Buckskin Wood Dr  
Ellicott City, MD 21042  
Scale 1"=30'