

Menu Save Reset Cancel Help

Record Detail (This section is required.)

Permit Type	Permit Number	Opened Date
Building/Residential/Misc/Tanks	B21000120	01/15/2021
Description of Work		
SFD/ INSTALL (1) 1000GAL UNDERGROUND PROPANE TANK		

check spelling

Address (This section is required.)

Search Reset Clear Get Parcel & Owner

Street #	Street Name	Street Type	
12217	MAYAPPLE	DR	
Unit Type	Unit #	X Coordinate	Y Coordinate
--Select--		-76.93669	39.34192
City	State	Zip Code	Primary
MARRIOTTSVILLE	MD	21104	Yes

Approved 1/20/21
ML

Parcel (This section is required.)

Search Reset Clear Get Address & Owner

GIS ID *	Parcel	Parcel Area	Land Value	Improved Value	Exemption Value	Plan Area
11059569	66	0	0	0	0	RURAL
Legal Description						

check spelling

Block	Lot	Census Tract	Council Dist	Inspection Dist	Supervisor Dist	Map #	DAP Zone
	26	603000	5				
Plan Area	State Tax Id	Subdivision Name					
		Walker Meadows					
Section	Area	Tax Map					
		9					
Grid	Zoning District	ADC Map					
9-6	RR-DEO	4694-A6					
SDP No.	Final Plan No.	WP File No.					
	ECP-15-078						
Record Plat No.	WS Contract No.	FDP No.					
24974-2497							
Owner Occupied	Year Built	Historic District					
<input type="radio"/> Yes <input type="radio"/> No		<input type="radio"/> Yes <input checked="" type="radio"/> No					
Historic District Registry No.	Stat Area	Flood Plain					
	3-01	<input type="radio"/> Yes <input checked="" type="radio"/> No					
Building No							

Owner * (This section is required.)

Search Reset Clear

Name *
 ESC WALKER MEADOWS

Address Line 1
 1355 BEVERLY RD #240

Address Line 2

Address Line 3

Mail City	Mail State	Mail Zip Code
MCLEAN	VA	22101

Phone **Primary**

443-545-4393	Yes
--------------	-----

E-mail

Cell Number	Fax Number
_____	_____

Professionals (This section is not required.)

Search Reset Clear

License # *	Business Name		
20100081215	J E FEAGA AND SON EXCAVATING INC		
License Type *	First Name	Middle Name	Last Name
Propane Gs	DENNIS		FEAGA
Primary	Address Line 1		
Yes	1560 A-D CATON CENTER DR		
	Address Line 2		
	1625 HENRYTON RD		
	City	State	ZIP Code
	BALTIMORE	MD	21227
	Phone 1	Phone 2	Fax
	4104425623		4104425623
	E-mail		

Applicant (This section is not required.)

Search As Owner As Lic. Prof As Contact

Type *	First Name	MI	Last Name
Applicant	MICHELLE		CLANCY
Relationship	Full Name		
Applicant	MICHELLE CLANCY		
Primary	Organization Name		
Yes	APPLIED & APPROVED PERMITS LLC		
	Street Address		
	P.O. BOX 310		
	Address Line 2		

	City	State	Zip Code
	PERRY HALL	MD	21128
	Phone	Cell	Fax
	443-340-1229		
	E-mail *		
	MICHELLE@APPLIEDANDAPPROVED.COM		

Addtl Info

Est Construction Cost *	Housing Units *	Number of Buildings *	Public Owned
3000	0	0	No
Construction Type			
-Select-			

TANK INFORMATION



RESIDENTIAL TANK INFORMATION

Capital Project-No Fee *	Capital Project Number	Fee Exempt *	Roadside Tree Project Permit *	Roadside Tree Permit #
<input type="radio"/> Yes <input checked="" type="radio"/> No		<input type="radio"/> Yes <input checked="" type="radio"/> No	<input type="radio"/> Yes <input checked="" type="radio"/> No	
Existing Use	Number of Tanks Installed *	Number of Tanks Removed *		
SFD	1	0		
Water Supply	Sewage Disposal	Expiration Date	Relocate Existing Tank *	
Private	Private	7/14/2021	0	

PAYMENT INFORMATION

Check 1	Payee 1	Check 2	Payee 2	SAP Doc No	SAP Entered

Submit Cancel

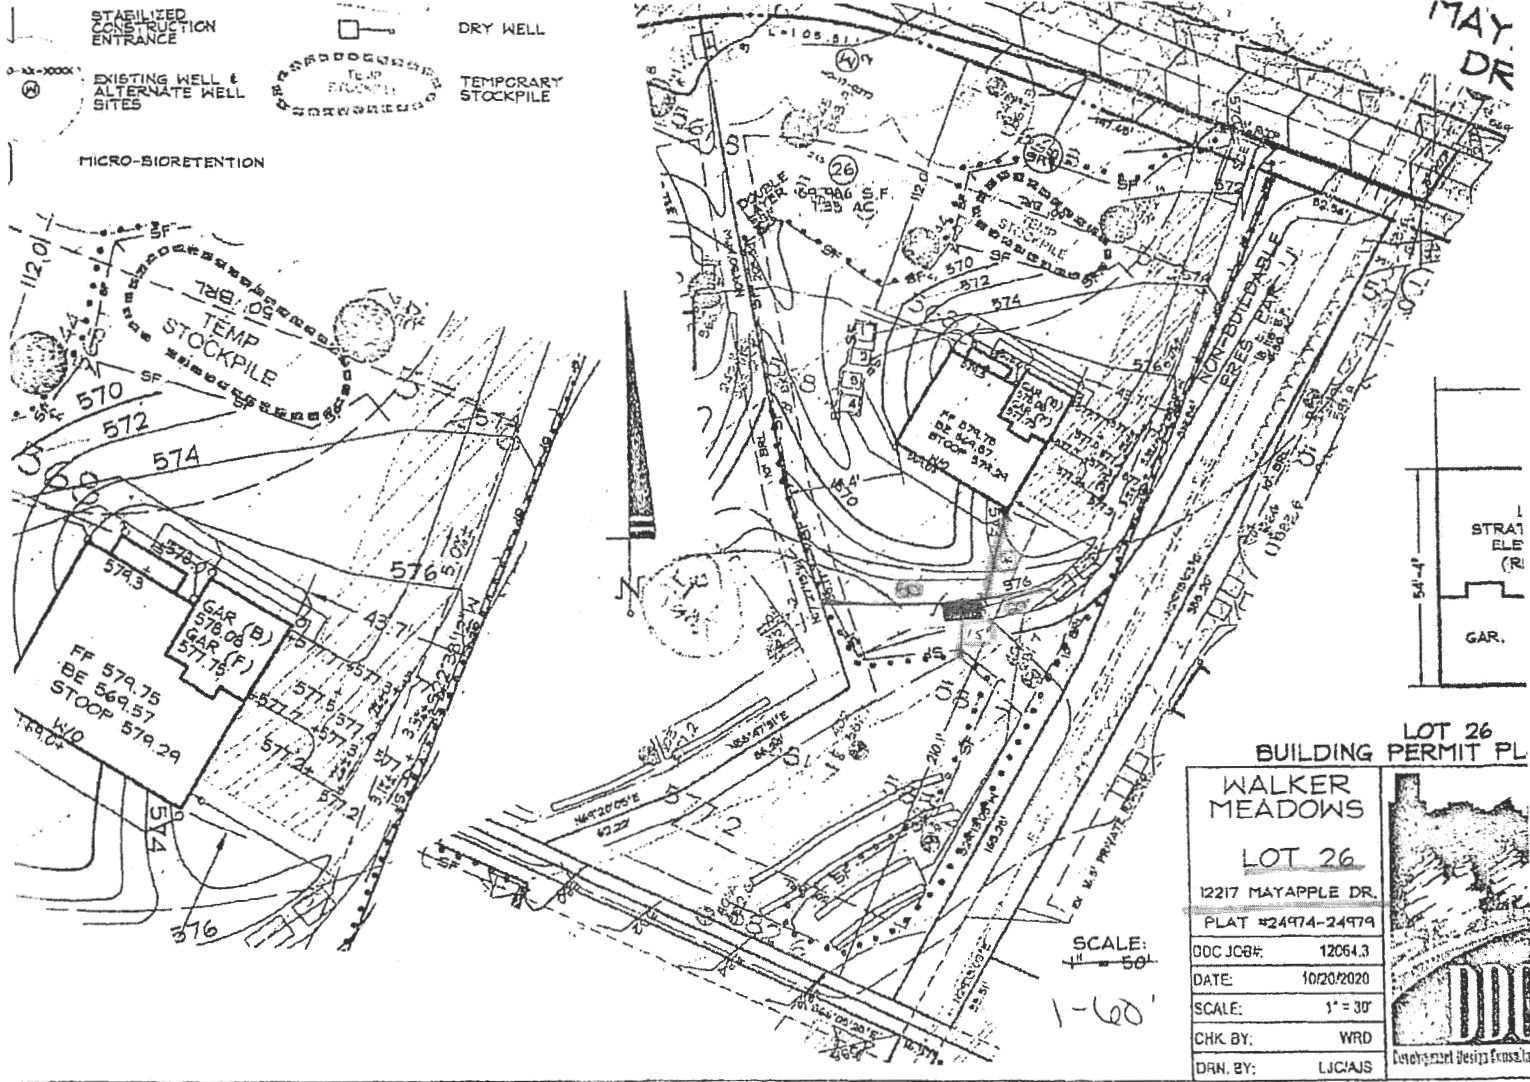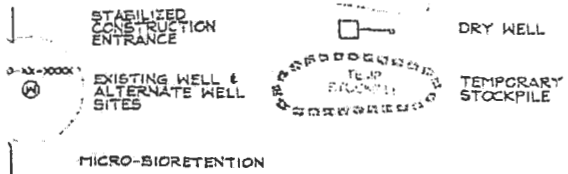

LOT 26 BUILDING PERMIT PL	
WALKER MEADOWS	
LOT 26	
12217 MAYAPPLE DR.	
PLAT #24974-24979	
DOC JOB#:	12064.3
DATE:	10/20/2020
SCALE:	1" = 30'
CHK. BY:	WRD
DRN. BY:	LJCAJS



Approved for LP tank
B21000120 AK 1/20/21