

**COMPLETE THIS FORM WHEN DROPPING OFF ANY  
CORRESPONDENCE AND/OR PLANS TO THE HOWARD COUNTY  
DEPARTMENT OF INSPECTIONS, LICENSES AND PERMITS COUNTER:**

Date: \_\_\_\_\_ *9/22/20 Approved, Ext  
work will steps to grade  
-4.0*

To: \_\_\_\_\_  
(Reviewer/Requestor's Name) (Division)

From: \_\_\_\_\_  
(Your Name, Company Name) *710-977-1328*  
(Phone Number)

Subject: Project name \_\_\_\_\_  
Project site address \_\_\_\_\_  
Permit # \_\_\_\_\_ SDP # \_\_\_\_\_  
Other information pertinent to this project \_\_\_\_\_

✓ Please check the attachments below that you are submitting with this transmittal:

- Letter of response to address plan review comment letter
- Revised plans and/or revised details: When submitting for a complete re-review, **duplicate sets shall be submitted.**
- Letter Summarizing Changes
- Energy conservation calculations
- Copies of \_\_\_\_\_ (be specific).  
 Health Department Request     DPZ/ DED Request     Applicant's Request
- Two sets of single-family model plans to be placed on permanent file: Model Name/ # *F.C. 2020*
- Other \_\_\_\_\_

**Contact Person Information: (Required)**

Please Print Name \_\_\_\_\_ Telephone No: *410-977-1328*

E-Mail Address: *hrbuilder@comcast.net*

**PLEASE ASSURE ALL DOCUMENTS AND/OR REVISIONS ARE APPROPRIATELY SIGNED AND SEALED. IF NECESSARY, BY A LICENSED ARCHITECT OR ENGINEER. PLEASE BE ADVISED THAT INSUFFICIENT INFORMATION MAY RESULT IN THE DELAY OF REVIEW BY THE PLANS EXAMINER. THE DEPARTMENT OF INSPECTIONS, LICENSES AND PERMITS WILL CONTACT YOU IF THERE IS A PROBLEM. IN ADDITION, ONCE THE BUILDING PERMIT IS APPROVED BY THE PLAN REVIEW DIVISION AND ALL OTHER REQUIRED SIGNATORY AGENCIES, AND THE BUILDING PERMIT IS READY FOR ISSUANCE, THE PERMIT DIVISION WILL NOTIFY THE APPROPRIATE CONTACT PERSON FOR PERMIT PICK UP. ALL PERMIT STATUS INQUIRIES SHALL BE DIRECTED TO THE PERMIT DIVISION AT 410-313-2455 OPTION #4 OR BY VISITING THE PLAN REVIEW DIVISION AT 410-313-2436. PLEASE ALLOW A MINIMUM OF FIVE (5) WORKING DAYS FOR ANY PLAN SUBMITTALS TO BE REVIEWED. THANK YOU.**

Received by \_\_\_\_\_




B 20000691

REVISED

Date: 9/15/20

Comments: 257368-9 B20000691

Survey of property known as #3322 Brantly Road, also known as Lot #4 Block "A" as shown on Plat of "BRANTLY" Section One and recorded among the Land Records of Howard County on Plat C.M.P. #3608.

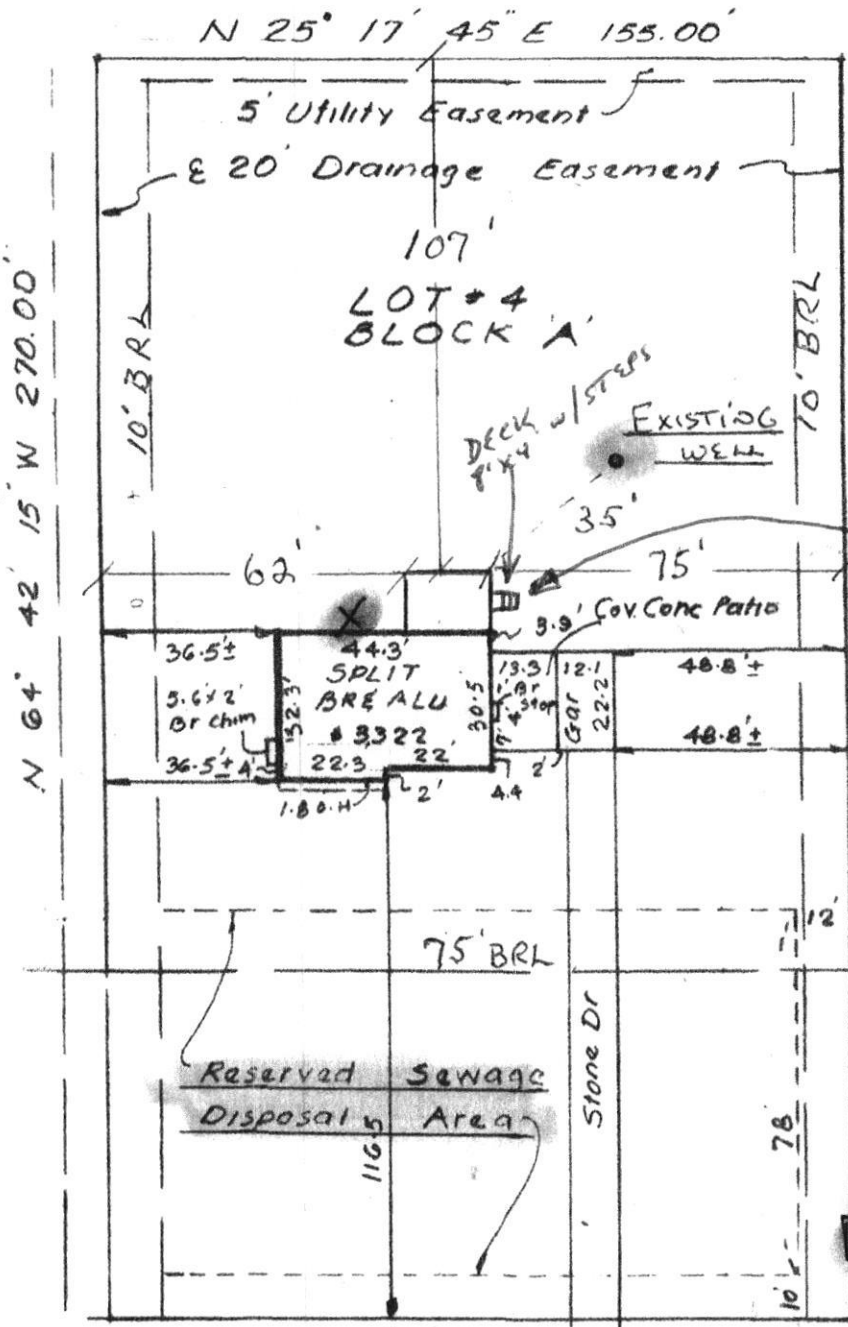

fence  
6' or higher  
20' off side line  
R-40  
20' in from side line

DECK  
4- CONCRETE FOOTINGS  
PRESSURE TREATED MATERIAL  
PER HOME OWNER  
BOLTED TO NEW LIVING RM  
8'x4' w/ STEPS



David E. Wilder  
TRANSFORMER

482.01' To The North West Side  
Of Buntwoods Road.

THIS PLAT IS NOT INTENDED FOR THE USE  
IN THE ESTABLISHMENT OF PROPERTY LINES

BRANTLY ROAD  
50' RIW 20' Mac  
3322 BRANTLY Rd.

WE HAVE SURVEYED THE LOT SHOWN ON  
THIS PLAT AND THE IMPROVEMENTS  
ARE LOCATED AS SHOWN.

**DON LYNCH ASSOC. INC.**  
**PENTHOUSE UNIT 1706**  
**28 ALLEGHENY AVE.**  
**TOWSON MD. 21204**

LUCAS  
RESIDENCE

3322 BRANTLY Rd  
GREENWOOD, MD. 21738

REAR YARD


DECK + STEPS + RAILS

PERMIT # B 20000691

PRESSURE TREATED

- 10- 2x8 JOIST 12" OC
- 6- 4x4 POST (6)
- 14- 2x6 DECKING 8'
- 6- 2x4 + 2x2 RAILS
- 34- 2x2 BALUSTRES
- CONCRETE FOOTINGS
- LAPPED TO HOUSE

NEW LIVING  
Room  
OVER CRAWL SPACE

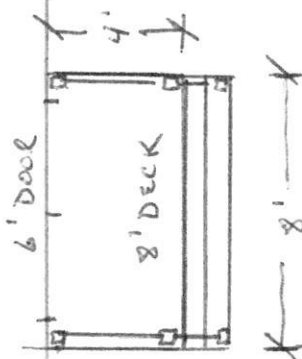

DR.

Kit

EXISTING  
AREA

DOOR

EXISTING  
AREA  
BREEZEWAY

EXISTING  
1-CAR  
GARAGE

BR

