

0-1873

SECRET NO. FOR USE ONLY

STATE OF MARYLAND DEPARTMENT OF WATER RESOURCES STATE OFFICE BLDG., ANNAPOLIS, MARYLAND 21401

THIS FORM MUST BE COMPLETED IN 60 DAYS AFTER THE COMPLETION OF THE WELL

FILL IN THIS PORTION COMPLETE COUNTY NUMBER A 14926

WELL NUMBER IS TO BE PUNCHED ON ALL CARDS

WELL COMPLETION REPORT

DATE WELL COMPLETED

Feb 20 73

DEPTH OF WELL

220

PERMIT NO. FROM PERMIT TO DRILL BY

MD-75-0739

DRILLER IDENTIFICATION NO.

OWNER LAST NAME

STREET OR RFD

POST OFFICE

Warfield Est. 4A Sec 1

WELL LOG

STATE THE KIND OF FORMATIONS PENETRATED, THEIR COLOR, DEPTH, THICKNESS AND IF WATER BEARING

DESCRIPTION SHEETS FROM TO CHECK IF WATER BEARING

WELL DESCRIPTION

GROUTING RECORD

WELL HAS BEEN GROUTED (CIRCLE APPROPRIATE BOX)

TYPE OF GROUTING MATERIAL (CIRCLE BOX) CEMENT CM BESTOITE CLAY BC

NO. OF BAGS NO. OF BOUNDS

GALLONS OF WATER DEPTH OF GROUT SEAL (TO NEAREST FOOT)

FROM 0 FT. TO 32 FT. (ENTER IF FROM SURFACE)

CASING RECORD

INSERT APPROPRIATE CODE BELOW STEEL CONCRETE PLASTIC OTHER

MAIN CASING TYPE NOMINAL DIAMETER TOP (INCH) TOTAL DEPTH OF MAIN CASING (NEAREST FOOT)

OTHER CASING (IF USED)

DIAMETER (INCH) DEPTH (FEET) FROM TO

SCREEN RECORD

INSERT APPROPRIATE CODE BELOW STEEL BRASS OR MONTE OPEN HOLE PLASTIC OTHER

DEPTH (NEAREST WHOLE FOOT)

Table with columns for depth intervals (1-30 feet) and rows for screen type (C 2).

DIAMETER OF SCREEN (NEAREST INCH)

SPRIVEL PACK

IF WELL DRILLED WAS A FLOORING WELL (CIRCLE BOX)

DRILLER USE ONLY (NOT TO BE FILLED IN BY DRILLER)

TELESCOPE LOG OTHER DATA AVAILABLE

C 3

LAND SURVEY

PUMPING TEST

HOURS PUMPED (TO NEAREST HOUR)

PUMPING RATE (GALLONS PER MINUTE TO NEAREST GALLON)

METHOD USED TO MEASURE PUMPING RATE

WATER LEVEL (DISTANCE FROM LAND SURVEY BENCHMARK)

FEET 30

RUNNING

TYPE OF PUMP USED (CIRCLE APPROPRIATE BOX FOR PUMPING TEST)

A AIR P PISTON T TURBINE C CENTRIFUGAL R ROTARY O OTHER J JET B SUBMERSIBLE

PUMP INSTALLED

TYPE OF PUMP (WRITE APPROPRIATE LETTER IN BOX - SEE ABOVE: A, C, J, P, R, T, O)

DRILLER WILL INSTALL PUMP (CIRCLE APPROPRIATE BOX)

CAPACITY:

GALLONS PER MINUTE (TO NEAREST GALLON)

PUMP HORSE POWER

PUMP COLUMN LENGTH (NEAREST FOOT)

CASING HEIGHT (CIRCLE APPROPRIATE BOX AND ENTER CASING HEIGHT)

ABOVE BELOW LAND SURVEY BENCHMARK

LOCATION OF WELL ON LOT

SHOW PERMANENT STRUCTURES SUCH AS SEPTIC TANKS, AND/OR OTHER LAND MARKS INDICATE NOT LESS THAN THE DISTANCE (MEASUREMENTS TO WELL)

2-23-73 44 case 39' open 9 logs cement of owner

CIRCLE APPROPRIATE BOXES


IF THIS WELL IS ABANDONED AND SEALED WHEN THIS REPORT IS MADE

IF ELECTRIC LOG OBTAINED

IF THIS WELL CONVERTED TO PRODUCTION WELL

IF THIS REPORT HAS BEEN COMPILED WITH ALL INFORMATION ON THE ABOVE CAPTIONED PERMIT AND THAT INFORMATION CONTAINED HEREIN IS TRUE, ACCURATE, AND COMPLETE TO THE BEST OF MY KNOWLEDGE, INFORMATION AND BELIEF

DATE

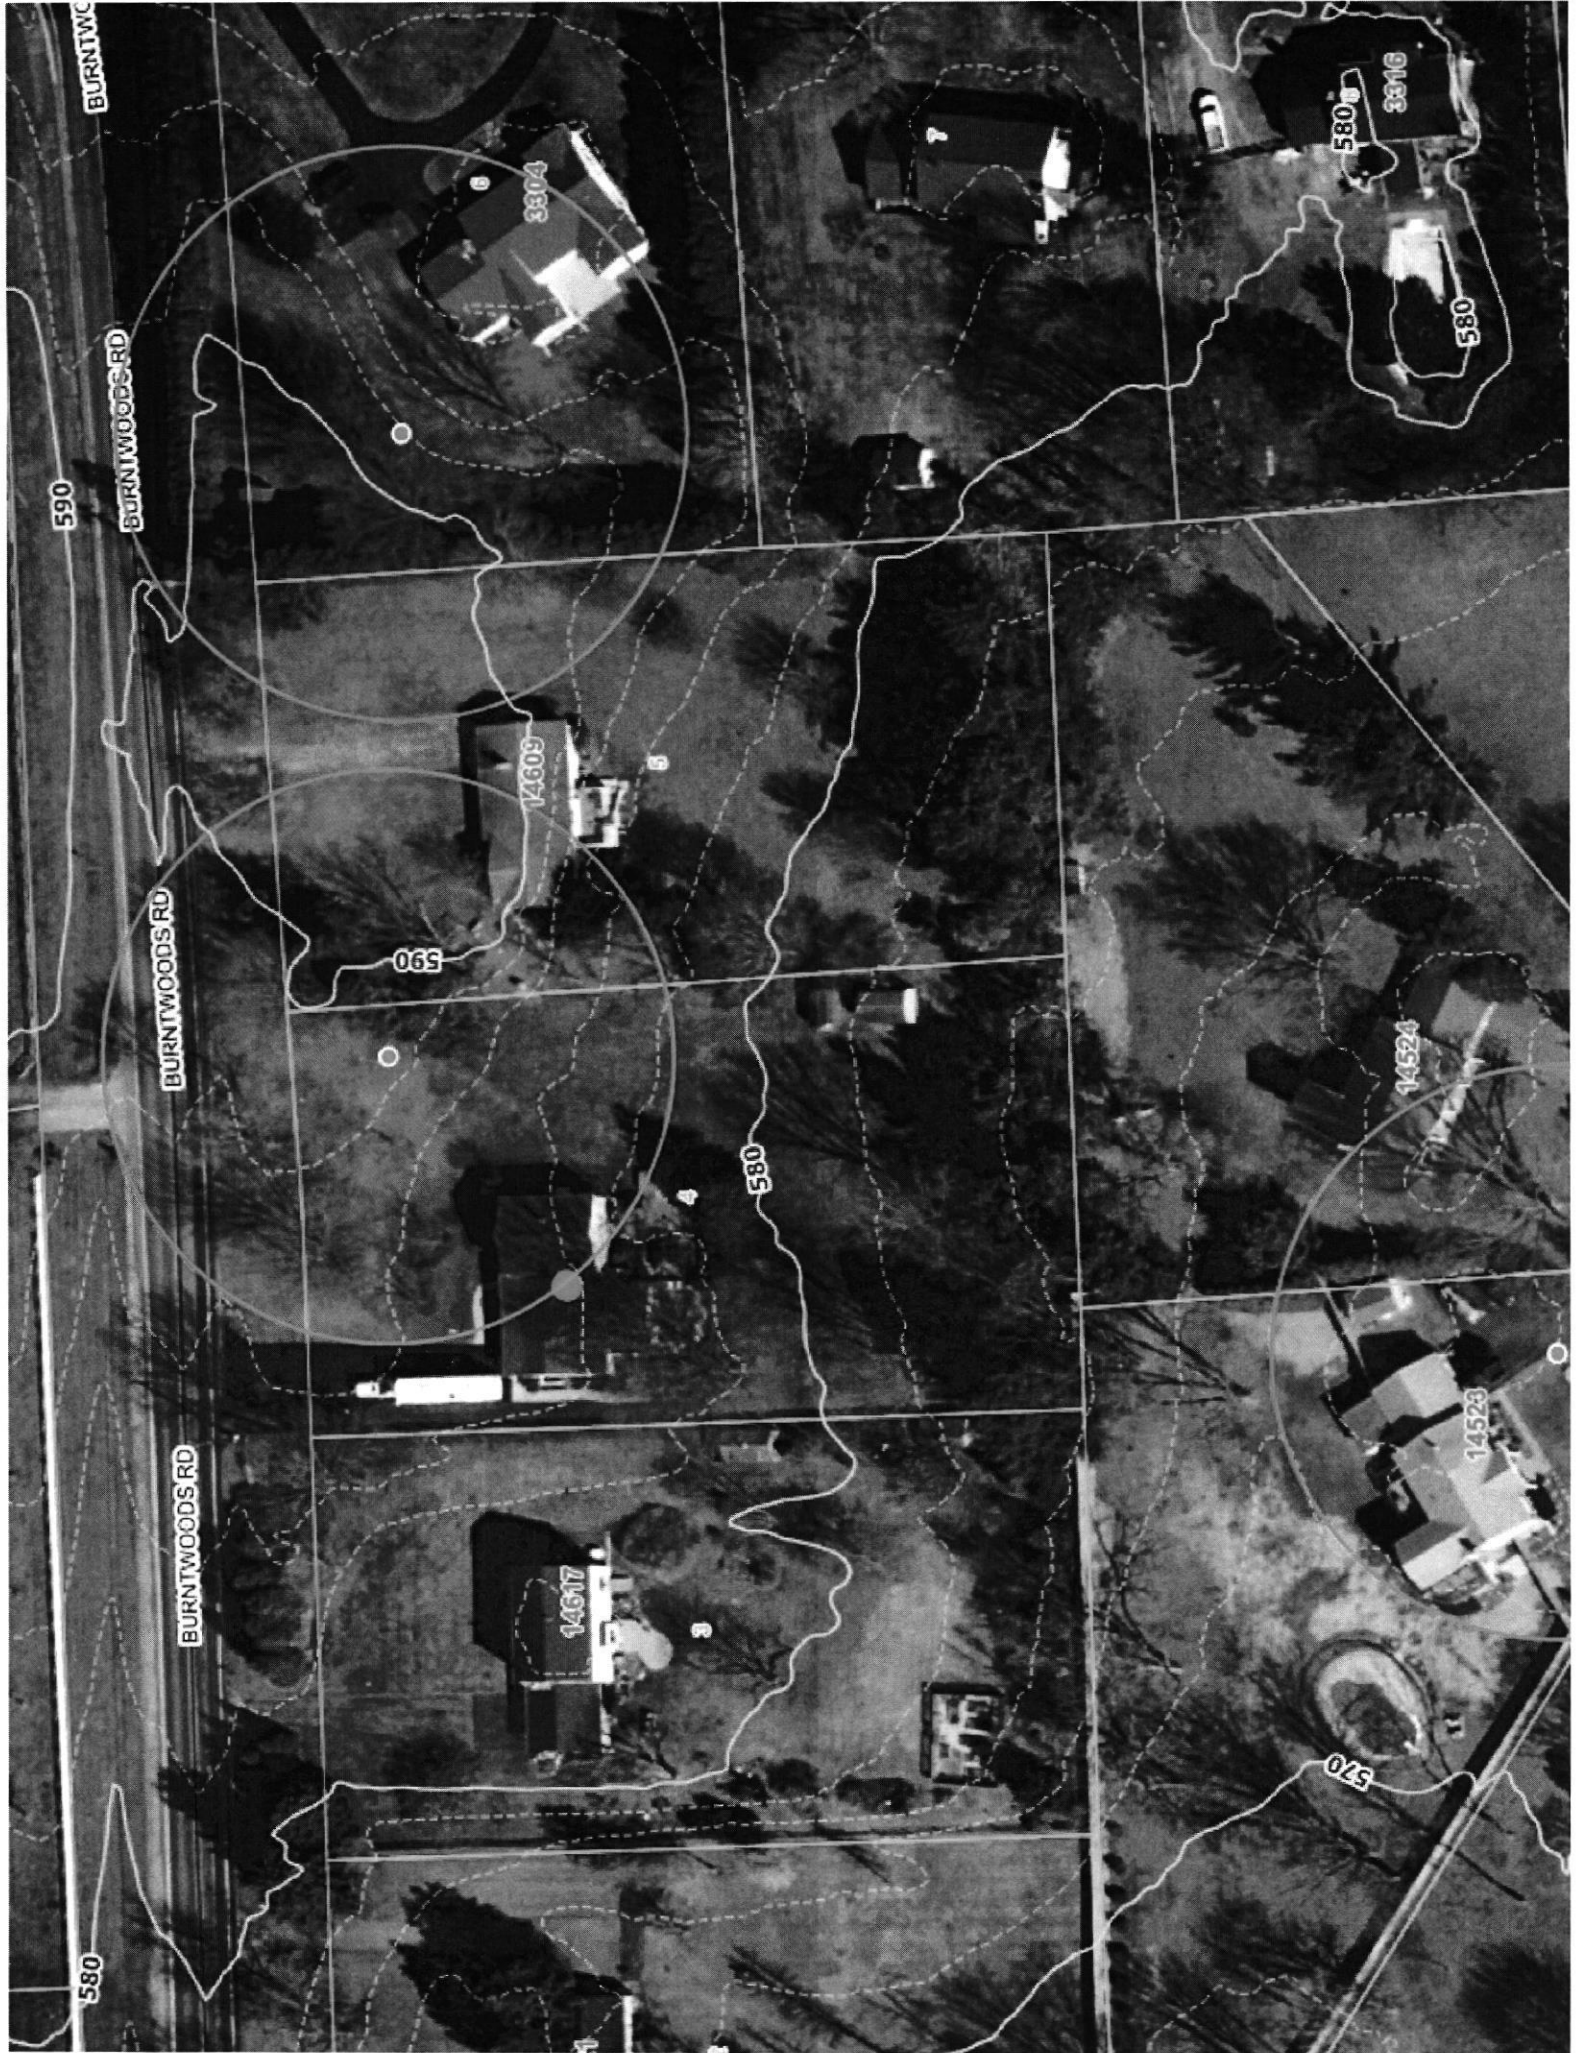

BURNTWOODS RD

590

BURNTWOODS RD

BURNTWOODS RD

BURNTWOODS RD

580

3304

14609

14617

580

3316

580

590

580

14524

14523

570