

APPLICATION

A 37380

SEWAGE DISPOSAL TESTING

P _____

STATE OF MARYLAND - DEPARTMENT OF HEALTH AND MENTAL HYGIENE

HOWARD COUNTY HEALTH DEPARTMENT
ENVIRONMENTAL HEALTH SERVICES
P O BOX 476, ELLICOTT CITY, MARYLAND 21043
TELEPHONE: 465-5000, EXT. 356

DISTRICT 5
DATE 7-14-86

ATTEMPT TO
FOURTH DIVIDE
LOT 9
NOT SUCCESSFUL.

TO THE COUNTY HEALTH OFFICER
ELLICOTT CITY, MARYLAND

I HEREBY APPLY FOR THE NECESSARY TEST IN ORDER TO CONSTRUCT (OR RECONSTRUCT) A SEWAGE DISPOSAL SYSTEM.

PROPERTY OWNER S. Turner Nichols & James S. Nichols

ADDRESS 13270 Tradelphian Mill Road PHONE 531-2585
Clarksville

PROPERTY LOCATION:

SUBDIVISION Dunfermlin LOT NO. 10

ROAD AND DESCRIPTION Free Sample, flag stem lot - off New Street from Ten Oaks Road (Macadam)

SIZE OF LOT 3 AC TYPE BLDG. _____ NUMBER OF BEDROOMS _____

IF NOT SINGLE RESIDENCE DESCRIBE _____

THE SYSTEM INSTALLED UNDER THIS APPLICATION IS ACCEPTABLE ONLY UNTIL PUBLIC FACILITIES BECOME AVAILABLE.

SIGNATURE OF APPLICANT James S. Nichols

APPROVED BY _____ FOR _____ DATE _____
(KIND OF SYSTEM)

REJECTED BY _____ FOR _____ DATE _____
(KIND OF SYSTEM)

HOLD PENDING FURTHER TESTS _____ DATE _____


REASONS FOR REJECTION OR HOLDING 4-5-89 wet season retest. Unsatisfactory soils and shallow depth to ground water. Recommend rejection JEN

THIS IS NOT A PERMIT

A 37380

(A)

0-4 Rd-br
 si cl lm
 4-10 Tan mica
 sa si lm,
 < 40%
 saprolite
 Water at
 7.0 ft
 10 Bottom

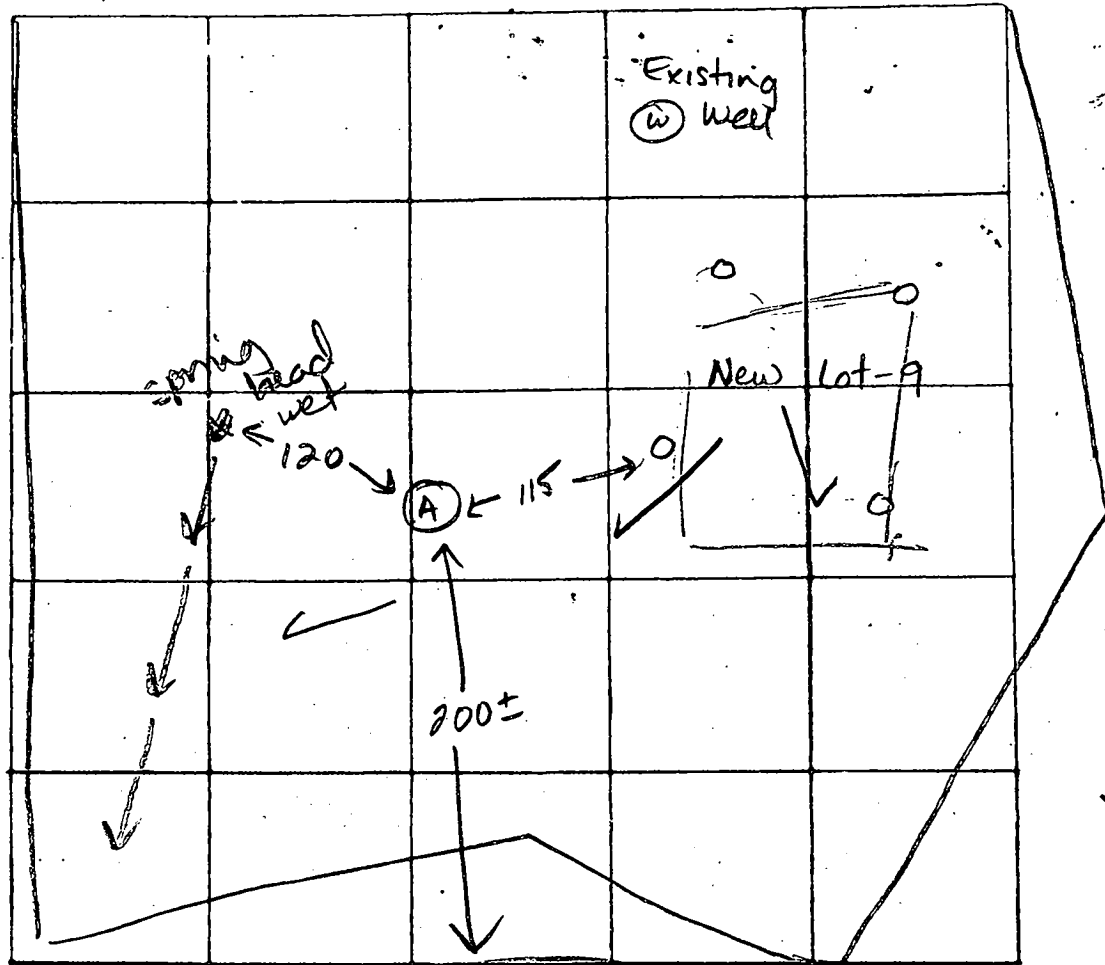

INDICATE NORTH - NAME ADJOINING ROADWAY AS BASE LINE

DATE	TEST NO.	DEPTH	PRE-WET		TEST - 1" DROP		TIME
			START	STOP	START	STOP	
4-5-89	A	10.0	V (water at 7.0ft.)				Failed

REMARKS Hole had water at 7.0ft.

TYPE OF SOIL 0-4' Rd-br si cl lm, 4'-10' Tan micaceous sa si lm, < 40% saprolite

TESTED BY Jane E. Nadeau

ALSO PRESENT: Jack Flock
 Owner

APPLICATION

A 37379

SEWAGE DISPOSAL TESTING

P _____

STATE OF MARYLAND - DEPARTMENT OF HEALTH AND MENTAL HYGIENE

DISTRICT 5

HOWARD COUNTY HEALTH DEPARTMENT
ENVIRONMENTAL HEALTH SERVICES
P. O. BOX 476, ELLICOTT CITY, MARYLAND 21043
TELEPHONE: 465-5000, EXT. 356

DATE 7-14-86

TO: THE COUNTY HEALTH OFFICER
ELLICOTT CITY, MARYLAND

I, HEREBY, APPLY FOR THE NECESSARY TEST IN ORDER TO CONSTRUCT (OR RECONSTRUCT) A SEWAGE DISPOSAL SYSTEM.

PROPERTY OWNER S. Turner Nichols & James S Nichols

ADDRESS 13270 Tradelphia Mill Road PHONE 531-2505
Clarksville

PROPERTY LOCATION:

SUBDIVISION Dunfardin LOT NO. 9.

ROAD AND DESCRIPTION Free Simple, flag stem lot
off new street from Ten Oaks Road (massdam)

SIZE OF LOT 3 AC TYPE BLDG. _____ NUMBER OF BEDROOMS _____

IF NOT SINGLE RESIDENCE DESCRIBE _____

THE SYSTEM INSTALLED UNDER THIS APPLICATION IS ACCEPTABLE ONLY UNTIL PUBLIC FACILITIES BECOME AVAILABLE.

SIGNATURE OF APPLICANT James S. Nichols

APPROVED BY _____ FOR _____ DATE _____
(KIND OF SYSTEM)


REJECTED BY _____ FOR _____ DATE _____
(KIND OF SYSTEM)

HOLD PENDING FURTHER TESTS _____ DATE _____

REASONS FOR REJECTION OR HOLDING 8-28-86 PERC SATISFACTORY; HOLD FOR SUBDIVISION PLAT -

LOT 9 & 10 TO BE COMBINED S. Held

THIS IS NOT A PERMIT

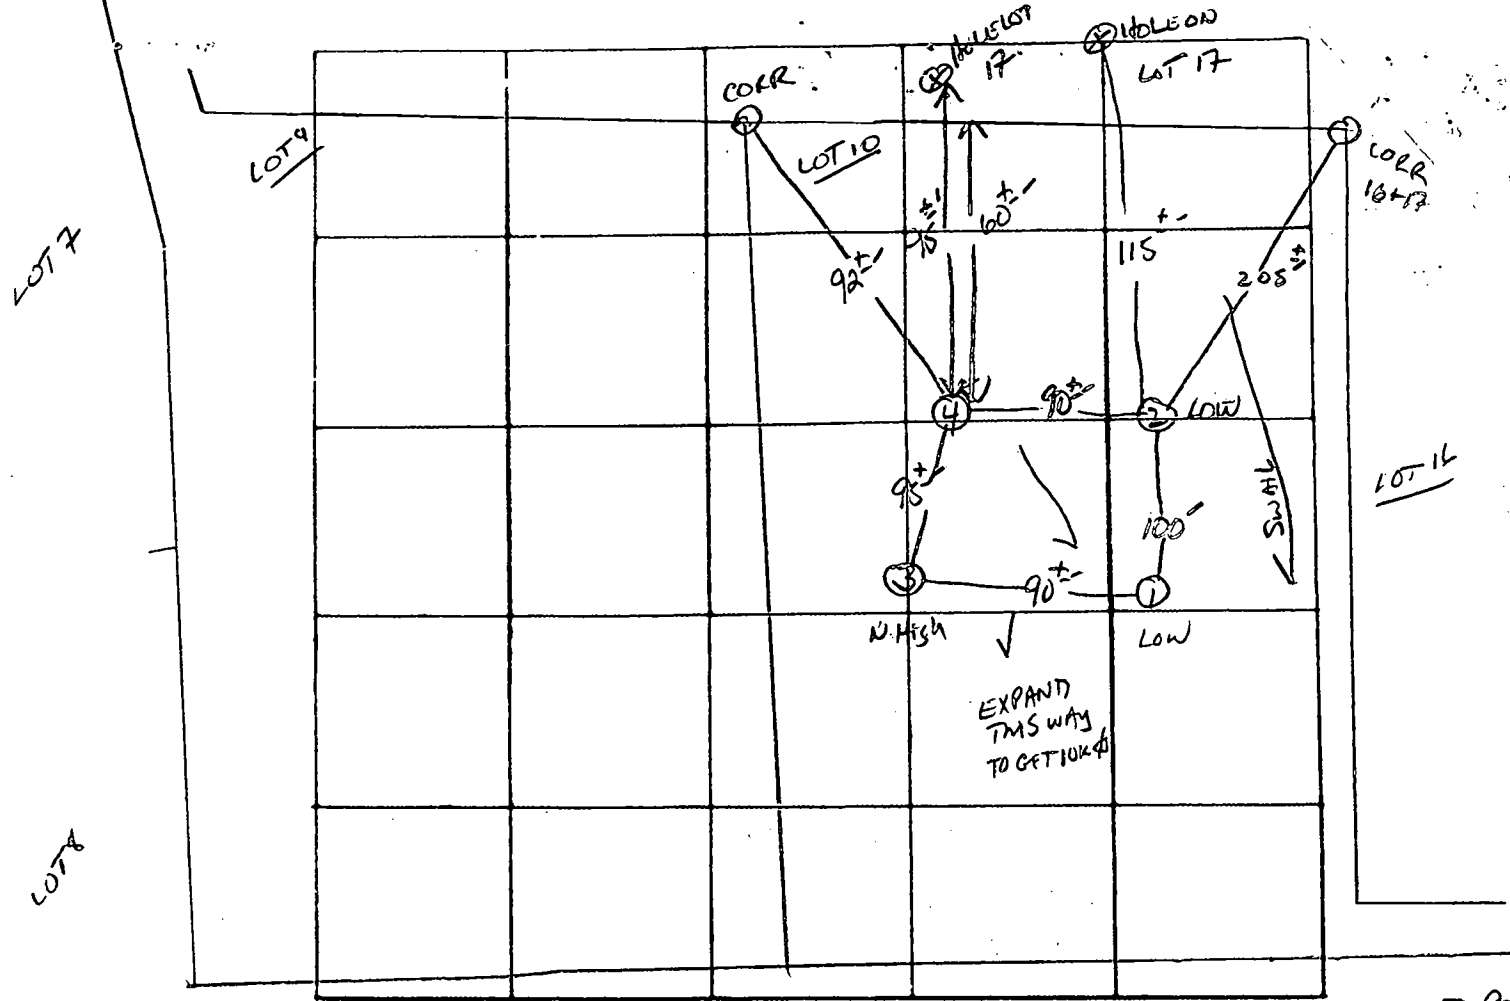

INDICATE NORTH. - NAME ADJOINING ROADWAY AS BASE LINE

①
 12"
 AP
 Yellow BK.
 Silty loam
 9-12% CLAY
 10% FRASS
 3"
 Yellow BK
 Highly micaceous
 Silty loam
 10-15%
 FRASMENTS
 Pink clasts
 14"

DATE	TEST NO.	DEPTH	PRE-WET		TEST - 1" DROP		TIME
			START	STOP	START	STOP	
8/28/60	1 S ✓	3" 14"	1:34	1:38	1:38	1:57	19 min
	2 S ✓	3.5" 13"	1:37	1:38	1:38	1:42	4 min
	3 S ✓	12.5"	SAME AS #1				
	4 S M	4" 8.5"	1:55	1:56	1:56	1:58	2 min
	4 V	13"	UNIFORM soil below		3"		1 min

7 PERC
 7 min
 INLET
 3 1/2
 BOTTOM
 8"
 187 ± BR

REMARKS HOLES ON LOT 10 FOR COMBINED LOT 9 + 10
 TYPE OF SOIL Glenelg
 TESTED BY S. Abel ALSO PRESENT: J. Fyock + Co.