


lot 10

AP

23
Brown L
1/2
orangeish yellow brown sl
2 1/2
15% rock
light grey sl
1/2
redish sl / rocky
5 1/2
light yel. brown sl
50% rock
11'

22
Brown L
2'
light brown yellow brown sl
3 1/2
orange brown sl
15% rock
light brown micaceous sl
8 1/2
saproolite / quartz 10%
sl
12'

24
Brown L
1/2
light brown L
1/2
orange brown sl
6
grey orangeish brown sl
9'
yellow brown ls
13'

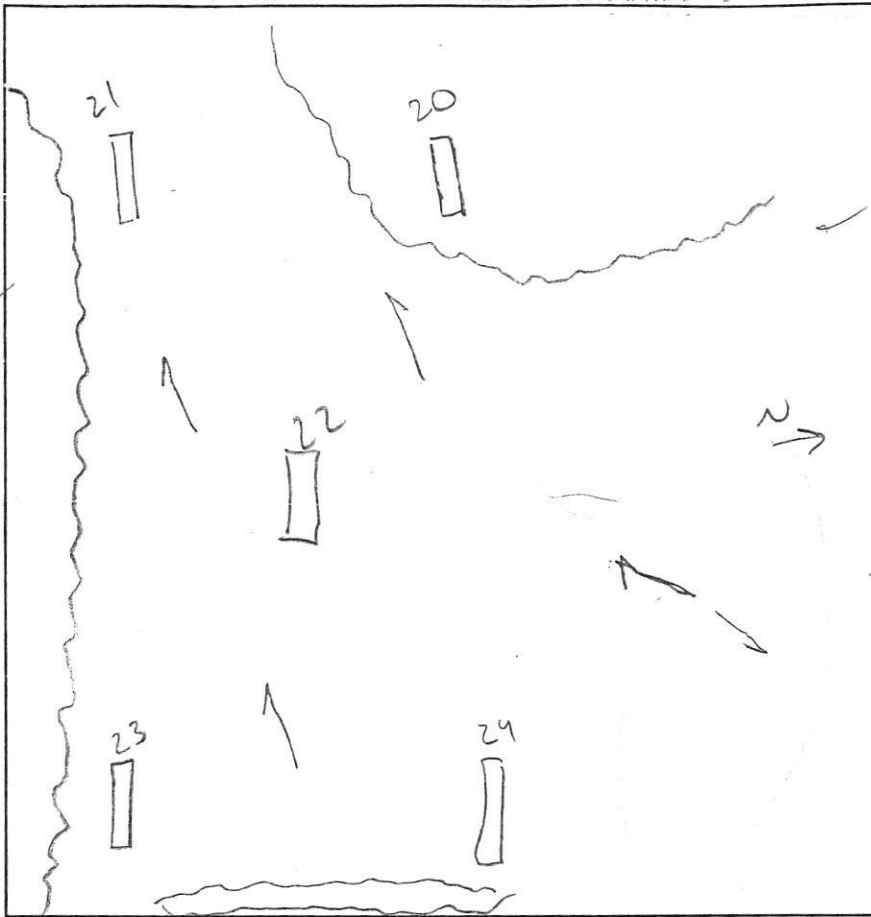

21
Brown l
1/2
orange brown sil
4 1/2
grey/brown sl
5% saproolite quartz
13'

20
Brown l.
1/2
brown sil
2 1/2
orange brown loam
5 1/2
grey brown sl
micaceous
50% rock & saproolite
12'

DATE	TEST #	DEPTH	START	BREAK 1" DROP	STOP 2" DROP	TIME OF 2ND INCH	P/F/H
9/1/04	23	5' / 11'	11:40	11:44	11:49	5 min	P
9/1/04	22	12'	- Visual -				P
9/1/04	24	5' / 13'	12:16 / 12:20	12:17 / 12:22	12:18 / 12:25	3 min	P
9/1/04	21	5 1/2' / 13'	12:42	12:46	12:50	4 min	P
9/1/04	20	5 1/2' / 12'	1:05	1:07	1:10	3 min	P

REMARKS _____
 SANITARIAN _____ BACKHOE _____ OTHERS _____
 TEST HOLES USED IN SDA _____ AVG. PERC TIME _____ SQ. FT/BR _____
 TRENCH WIDTH _____ INLET DEPTH _____ MAX. BOT DEPTH _____ EFFECTIVE S/W _____

