

C 1 07850

SEQUENCE NO. (MDE USE ONLY)

STATE OF MARYLAND WELL COMPLETION REPORT

THIS REPORT MUST BE SUBMITTED AFTER WELL IS COMPLETED. 10/17/00 OK BB

COUNTY NUMBER A45650

DATE RECEIVED MM DD YY

DATE WELL COMPLETED 08 17 00

DEPTH OF WELL 22 265 (TO NEAREST FOOT)

WELL DRILLED OFF INTENDED LOT PERMIT NO. FROM "PERMIT TO DRILL WELL" HO - 94 - 2761

OWNER Grodin Michael Steve Gissel
STREET OR RFD Route 94
SUBDIVISION Grodin Property SECTION TOWN Woodbine LOT 4

WELL LOG table with columns: DESCRIPTION, FEET (FROM, TO), check if water bearing. Rows include Top Soil, Brown Shale, Brown Slate, Blue Slate, etc.

GROUTING RECORD form including: WELL HAS BEEN GROUTED (Y), TYPE OF GROUTING MATERIAL (CM, BC), NO. OF BAGS (8), NO. OF POUNDS (800), DEPTH OF GROUT SEAL (30).

CASING RECORD form including: casing types insert (PL), MAIN CASING TYPE (PL), Nominal diameter (6), Total depth of main casing (40).

OTHER CASING (if used) form with columns for diameter and depth.

SCREEN RECORD form including: screen type or open hole (HO), SCREEN RECORD (ST, BR, HO, PL, OT).

PUMPING TEST form including: HOURS PUMPED (3), PUMPING RATE (6), METHOD USED TO MEASURE PUMPING RATE (Bucket), WATER LEVEL (45), TYPE OF PUMP USED (S).

NUMBER OF UNSUCCESSFUL WELLS: 0

WELL HYDROFRACTURED (Y), CIRCLE APPROPRIATE LETTER (A, E, P).

I HEREBY CERTIFY THAT THIS WELL HAS BEEN CONSTRUCTED IN ACCORDANCE WITH COMAR 28.04.04 "WELL CONSTRUCTION" AND IN CONFORMANCE WITH ALL CONDITIONS STATED IN THE ABOVE CAPTIONED PERMIT...

DRILLERS LIC. NO. MS D 1113, DRILLERS SIGNATURE (MUST MATCH SIGNATURE ON APPLICATION)


LIC. NO. D, SITE SUPERVISOR (sign. of driller or journeyman responsible for sitework if different from permittee)

DEPTH (nearest ft.) table with columns for casing depth and screen depth.

GRAVEL PACK IF WELL DRILLED WAS FLOWING WELL INSERT F IN BOX 68

MDE USE ONLY (NOT TO BE FILLED IN BY DRILLER) form including TELESCOPE CASING, LOG INDICATOR, OTHER DATA.

PUMP INSTALLED form including: DRILLER INSTALLED PUMP (NO), TYPE OF PUMP INSTALLED (S), CAPACITY: GALLONS PER MINUTE (31), PUMP HORSE POWER (37), PUMP COLUMN LENGTH (41), CASING HEIGHT (2).

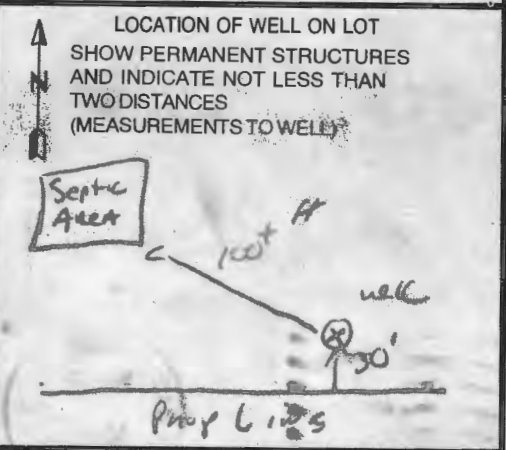

B 1 18660

SEQUENCE NO. (MDE USE ONLY)

STATE OF MARYLAND PERMIT TO DRILL WELL W54157 please print or type

STATE PERMIT NUMBER

HO-94-2761 fill in this form completely

Date Received (APA) 7/28/2000

OWNER INFORMATION

8 15 36 57 70 72 76 GRODIN MICHAEL 15710 New Hampshire Ave Silver Springs MD 20905

LOCATION OF WELL


8 21 23 42 44 46 48 50 52 71 HOWARD GRODIN PROP FLORENCE

DRILLER INFORMATION

76 81 M S D 117 RALPH MAYNS well DRILLING 17024 Hanly Rd Mt Airy MD

1 2 8 9 10 100

MD Rt 94 34 37 38 39 100

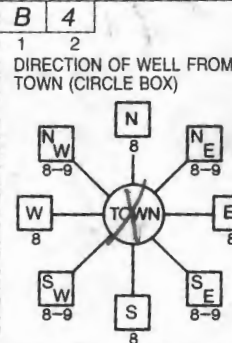

WELL INFORMATION

5 12 14 20 APPROX. PUMPING RATE (GAL. PER MIN.) 500 AVERAGE DAILY QUANTITY NEEDED (GAL. PER DAY)

USE FOR WATER (CIRCLE APPROPRIATE BOX)

- DOMESTIC POTABLE SUPPLY & RESIDENTIAL IRRIGATION FARMING (LIVESTOCK WATERING & AGRICULTURAL IRRIGATION) INDUSTRIAL, COMMERCIAL, DEWATERING PUBLIC WATER SUPPLY WELL TEST, OBSERVATION, MONITORING GEO-THERMAL

NOT TO BE FILLED IN BY DRILLER HEALTH DEPARTMENT APPROVAL

HOWARD A45650 COUNTY NAME COUNTY NO. STATE SIGNATURE INSERT S DATE ISSUED 7-31-2000 Brian Baker 7-31-00

APPROXIMATE DEPTH OF WELL 150 FEET

APPROXIMATE DIAMETER OF WELL 6 NEAREST INCH

METHOD OF DRILLING (circle one)

BORED (or Augered) JETTED Jetted & DRIVEN AIR-ROTary AIR-Percussion ROTARY (Hydraulic Rotary) CABLE REVERSE-ROTary Drive-POINT

REPLACEMENT OR DEEPEMED WELLS (CIRCLE APPROPRIATE BOX)

- THIS WELL WILL NOT REPLACE AN EXISTING WELL THIS WELL WILL REPLACE A WELL THAT WILL BE ABANDONED AND SEALED THIS WELL WILL REPLACE A WELL THAT WILL BE USED AS A STANDBY-CONTACT LOCAL APPROVING AUTHORITY FOR POLICY ON STANDBY WELLS THIS WELL WILL DEEPEM AN EXISTING WELL

SHOW MAJOR FEATURES OF BOX & LOCATE WELL WITH AN X


- SOURCES OF DRILLING WATER 1. well 2. 3.

WRITE THE BOX NUMBER FROM THE MAP HERE

72067 54036

8/11/00 8:00 No Insp. BB

DRAW A SKETCH BELOW SHOWING LOCATION OF WELL IN RELATION TO NEARBY TOWNS AND ROADS AND GIVE DISTANCE FROM WELL TO NEAREST ROAD JUNCTION

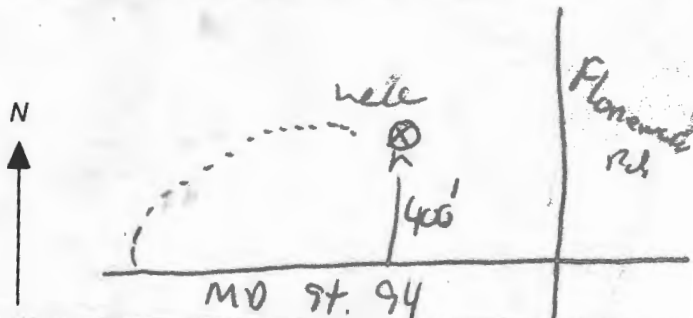


Not to be filled in by driller (MDE OR COUNTY USE ONLY)

APPROP. PERMIT NUMBER 54 63 PERMIT No. HO-94-2761

SPECIAL CONDITIONS 301-384-4846

FIRST
 10/11/00 WELL FOR GRODIN
 ML DRILLED ON TREE FARM
 NEXT DOOR OWNED BY
 STEVE CISSEL

Y EASEMENT.

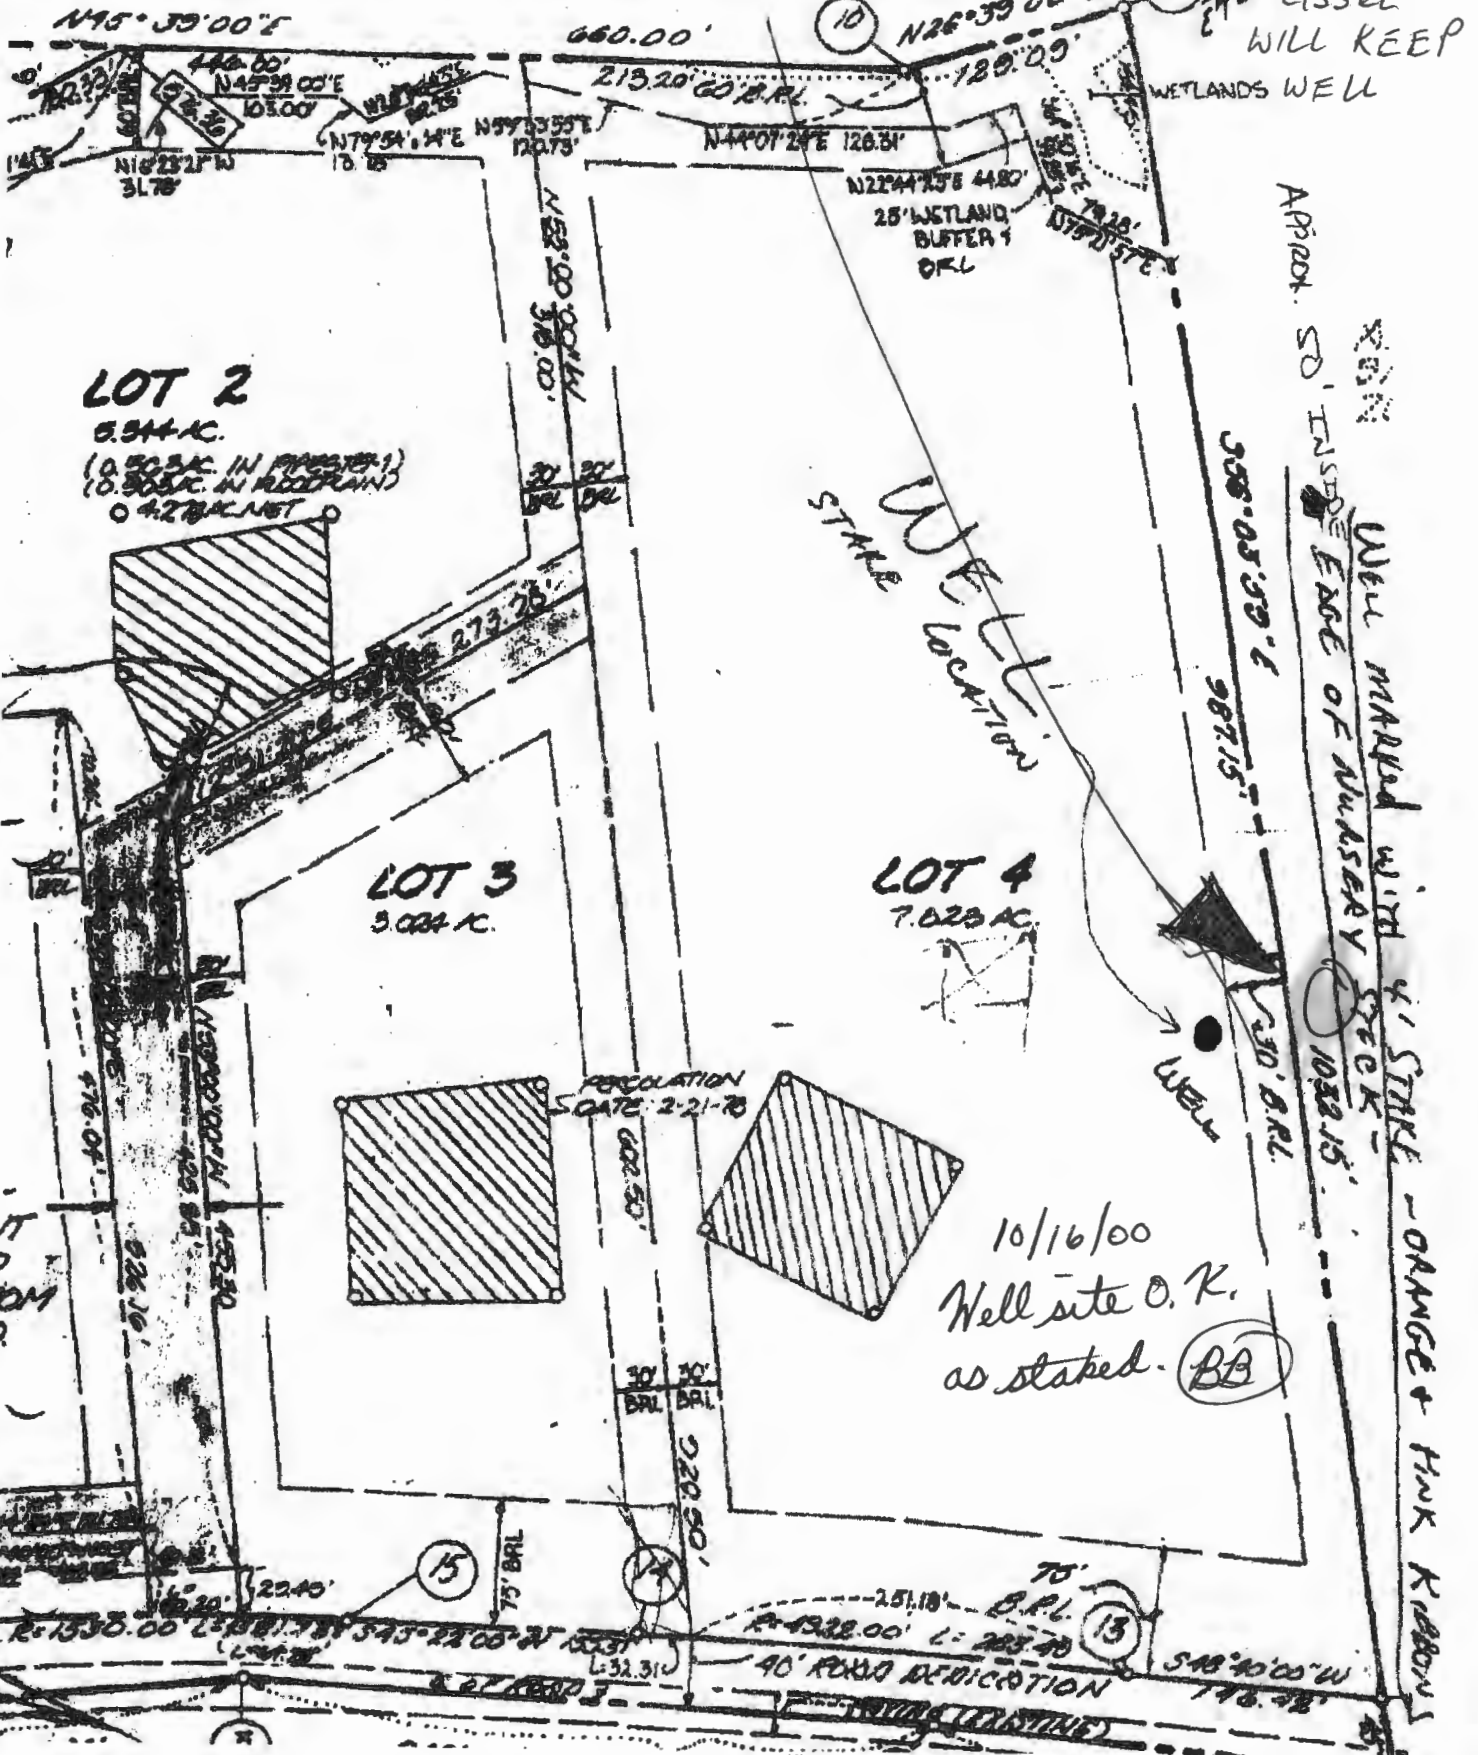

CISSEL
 WILL KEEP
 WETLANDS WELL

LOT 2
 0.544 AC.
 (0.503 AC. IN PARCELS 1)
 (0.503 AC. IN REDEVELOPMENT)
 0.427 AC. NET

LOT 3
 3.004 AC.

LOT 4
 7.023 AC.

WE
 LOCATION
 STAKE

10/16/00
 Well site O.K.
 as staked. (BB)

APPROX. 50' INSIDE
 EDGE OF NURSERY
 1032.15'
 987.15'
 358.05' 33' E
 130' B.P.L.
 75' B.P.L.
 40' ROAD DEDICATION
 176.78'

MD RT 94