
WATER WELL ABANDONMENT-SEALING REPORT FORM

SUBMIT COPIES OF COMPLETED FORM TO:

- * COUNTY ENVIRONMENTAL AGENCY (contact MDE, WMA if address needed)
- * WELL OWNER
- * MDE, WATER MANAGEMENT ADMINISTRATION, WELL PROGRAM

APPROVED
10/16/2009
to

DATE WELL ABANDONED: 11-22-14 (month/day/year)

* PERMIT NUMBER OF ABANDONED WELL (if any) _____

* PERMIT NUMBER OF REPLACEMENT WELL: _____


* PERSON ABANDONING WELL: George Easterday WELL DRILLER'S LICENSE NUMBER: 040

CIRCLE: MWD / MSD / MGD

* OWNER'S NAME: Permir A Construction

SITE LOCATION MAP

* WELL LOCATION: Howard
COUNTY: _____
NEAREST TOWN: COLUMBIA
TAX MAP: _____ BLOCK _____ PARCEL _____
SUBDIVISION: _____
SECTION: _____ LOT: _____
STREET ADDRESS: 9201 OLD GUILFORD RD

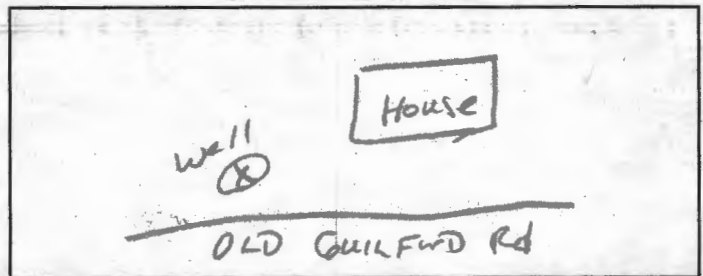

LATITUDE 3 9.165956

LONGITUDE 7 6.842707

LOG OF SEALING MATERIAL

MATERIAL	FEET	
	FROM	TO
<u>CEMENT</u>	<u>12</u>	

VOLUME OF MATERIAL USED

1 1/2 Yds concrete

* TYPE OF WELL BEING ABANDONED:
 DRILLED JETTED
 BORED HAND DUG
 OTHER (specify) _____

* USE CODE:
 DOMESTIC MUNICIPAL/PUBLIC
 IRRIGATION INDUSTRIAL
 TEST/OBSERVATION GEOTHERMAL

* TYPE OF CASING:
 STEEL PLASTIC
 CONCRETE OTHER (specify)
STONES

SIZE OF CASING: 36 INCHES IN DIAMETER

DEPTH OF WELL: 12 FEET DEEP

WAS ANY CASING REMOVED? YES NO
If yes, length removed, in feet: _____

WAS CASING RIPPED OR PERFORATED? YES NO

George F. Easterday 040
SIGNATURE-MASTER WELL DRILLER OR SUPERVISING SANITARIAN LICENSE#

MWD / MSD / MGS

CIRCLE ONE

DATE

COUNTY



Pursuant to § 10-624 of the State Govt. Article of the Maryland Code, personal info requested on this form is used in processing this form pursuant to COMAR 26.04.04. Failure to provide the info may result in this form not being processed. You have the right to inspect, amend, or correct this form. The Maryland Department of the Environment is subject to the Maryland Public Information Act. This form may be made available on the Internet via MDE's website and is subject to inspection or copying, in whole or in part, by the public and other governmental agencies, if not protected by federal or State Law.

Fogle's Septic Clean Inc.

Fogle's Portable Toilets • Fogle's Well Drilling LLC • Fogle's Excavating, LLC



January 20, 2017

Howard Co Dept of Environmental Health
8930 Stanford Blvd
Columbia, Md 21045

To Whom it may concern,

On January 20th 2017 Fogle's Septic Clean Inc, has abandoned the septic tank located at 9201 Guilford Rd in Columbia for Permira construction. There was no drywell. If you have any questions please call me at the office 410-795-5670.

Sincerely,

A handwritten signature in cursive script that reads "Dale Fogle".

Dale Fogle
Fogle's Septic Clean, Inc.

Real Property Data Search (w1)

Search Result for HOWARD COUNTY

View Map		View GroundRent Redemption			View GroundRent Registration				
Tax Exempt: None		Special Tax Recapture: None							
Exempt Class: None									
Account Identifier:		District - 06 Account Number - 412734							
Owner Information									
Owner Name:		9201 GUILFORD PROPERTIES LLC			Use:		COMMERCIAL		
Mailing Address:		2711 MOORES VALLEY DR BALTIMORE MD 21209-			Principal Residence:		NO		
					Deed Reference:		/16990/ 00043		
Location & Structure Information									
Premises Address:		9201 OLD GUILFORD RD COLUMBIA 21046-0000			Legal Description:		2.647 A. 9201 OLD GUILFORD RD COLUMBIA		
Map:	Grid:	Parcel:	Neighborhood:	Subdivision:	Section:	Block:	Lot:	Assessment Year:	Plat No:
0042	0015	0028	20000.14	0000				2020	Plat Ref:
Special Tax Areas: None					Town:		None		
					Ad Valorem:		104		
					Tax Class:		None		
Primary Structure Built		Above Grade Living Area		Finished Basement Area		Property Land Area		County Use	
						2.6470 AC			
Stories	Basement	Type	Exterior	Quality	Full/Half Bath	Garage	Last Notice of Major Improvements		
			/						
Value Information									
		Base Value		Value		Phase-in Assessments			
				As of		As of		As of	
				01/01/2017		07/01/2019		07/01/2020	
Land:		1,149,900		1,149,900					
Improvements		0		0					
Total:		1,149,900		1,149,900		1,149,900			
Preferential Land:		0							
Transfer Information									
Seller: LUCKADO LUNSFORD H L/E				Date: 07/20/2016		Price: \$1,212,500			
Type: ARMS LENGTH VACANT				Deed1: /16990/ 00043		Deed2:			
Seller: LUCKADO LUNSFORD H				Date: 03/10/2010		Price: \$261,000			
Type: NON-ARMS LENGTH OTHER				Deed1: /12349/ 00421		Deed2:			
Seller: LUCKADO LUNSFORD H				Date: 10/22/2009		Price: \$0			
Type: NON-ARMS LENGTH OTHER				Deed1: /12110/ 00500		Deed2:			
Exemption Information									
Partial Exempt Assessments:		Class		07/01/2019		07/01/2020			
County:		000		0.00					
State:		000		0.00					
Municipal:		000		0.00		0.00			
Tax Exempt: None		Special Tax Recapture: None							
Exempt Class: None									
Homestead Application Information									
Homestead Application Status: No Application									
Homeowners' Tax Credit Application Information									

Homeowners' Tax Credit Application Status: No Application**Date:**

1. This screen allows you to search the Real Property database and display property records.
2. Click **here** for a glossary of terms.
3. Deleted accounts can only be selected by Property Account Identifier.
4. The following pages are for information purpose only. The data is not to be used for legal reports or documents. While we have confidence in the accuracy of these records, the Department makes no warranties, expressed or implied, regarding the information.