

WATER WELL ABANDONMENT-SEALING REPORT FORM

SUBMIT COPIES OF COMPLETED FORM TO:

- * COUNTY ENVIRONMENTAL AGENCY (contact MDE, WMA if address needed)
- * WELL OWNER
- * MDE, WATER MANAGEMENT ADMINISTRATION, WELL PROGRAM

APPROVED
 03/12/2021

DATE WELL ABANDONED: 2-16-21 (month/day/year)


* PERMIT NUMBER OF ABANDONED WELL (if any) none

* PERMIT NUMBER OF REPLACEMENT WELL: _____

* PERSON ABANDONING WELL: Larry Mayne WELL DRILLER'S LICENSE NUMBER: M5D027

* OWNER'S NAME: Mark Moody CIRCLE: MWD / MSD / MGD

* WELL LOCATION:
 COUNTY: Howard
 NEAREST TOWN: Ayleeville Md 21784
 TAX MAP _____ BLOCK _____ PARCEL _____
 SUBDIVISION: _____
 SECTION: _____ LOT: _____
 STREET ADDRESS: 820 Driver Rd.

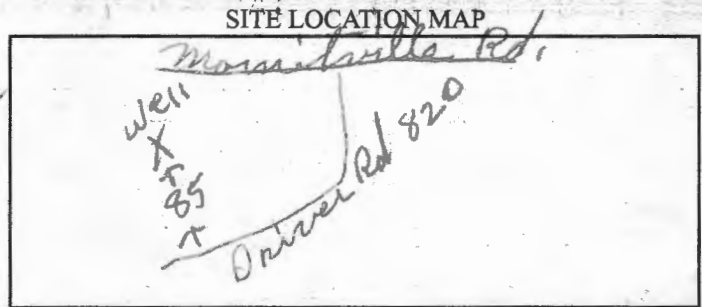

LATITUDE 3 9.34840
 LONGITUDE 7 6.89590

LOG OF SEALING MATERIAL

MATERIAL	FEET	
	FROM	TO
<u>Cement</u>	<u>3</u>	<u>40</u>
VOLUME OF MATERIAL USED		
<u>16 Bags Cement</u>		

* TYPE OF WELL BEING ABANDONED: PIT WELL
 DRILLED JETTED IN FRONT
 BORED HAND DUG OF HOUSE
 OTHER (specify): _____

* USE CODE:
 DOMESTIC MUNICIPAL/PUBLIC
 IRRIGATION INDUSTRIAL
 TEST/OBSERVATION GEOTHERMAL

* TYPE OF CASING:
 STEEL PLASTIC
 CONCRETE OTHER (specify) _____

SIZE OF CASING: 6 INCHES IN DIAMETER

DEPTH OF WELL: 40 FEET DEEP

WAS ANY CASING REMOVED? YES NO
 If yes, length removed, in feet: Well casing 3 ft underground
 WAS CASING RIPPED OR PERFORATED? YES NO

SIGNATURE-MASTER WELL DRILLER OR SUPERVISING SANITARIAN Larry Mayne LICENSE# M5D027 CIRCLE ONE MWD / MSD / MGS DATE 2-16-21

COUNTY

Pursuant to § 10-624 of the State Govt. Article of the Maryland Code, personal info requested on this form is used in processing this form pursuant to COMAR 26.04.04. Failure to provide the info may result in this form not being processed. You have the right to inspect, amend, or correct this form. The Maryland Department of the Environment is subject to the Maryland Public Information Act. This form may be made available on the Internet via MDE's website and is subject to inspection or copying, in whole or in part, by the public and other governmental agencies, if not protected by federal or State Law.

9/16
 SALL
 PORTLAND
 TYPE 4/II