

SITE INSPECTION SHEET

OWNER: GOEL, ASHITA PHONE #: _____

ADDRESS: 14545 EDGEWOODS WAY CONTRACTOR: FOGLES SEPTIC CLEAN


GLENELG MD 21737 WELL TAG #: _____

SUBDIVISION: EDGEWOOD FARM LOT: 25 COUNTY #: (XIII)
PHASE II LSS

PROPOSAL: _____

SINK TIE IN TO SEPTIC LINE TO TANK.

LOCATION DIAGRAM

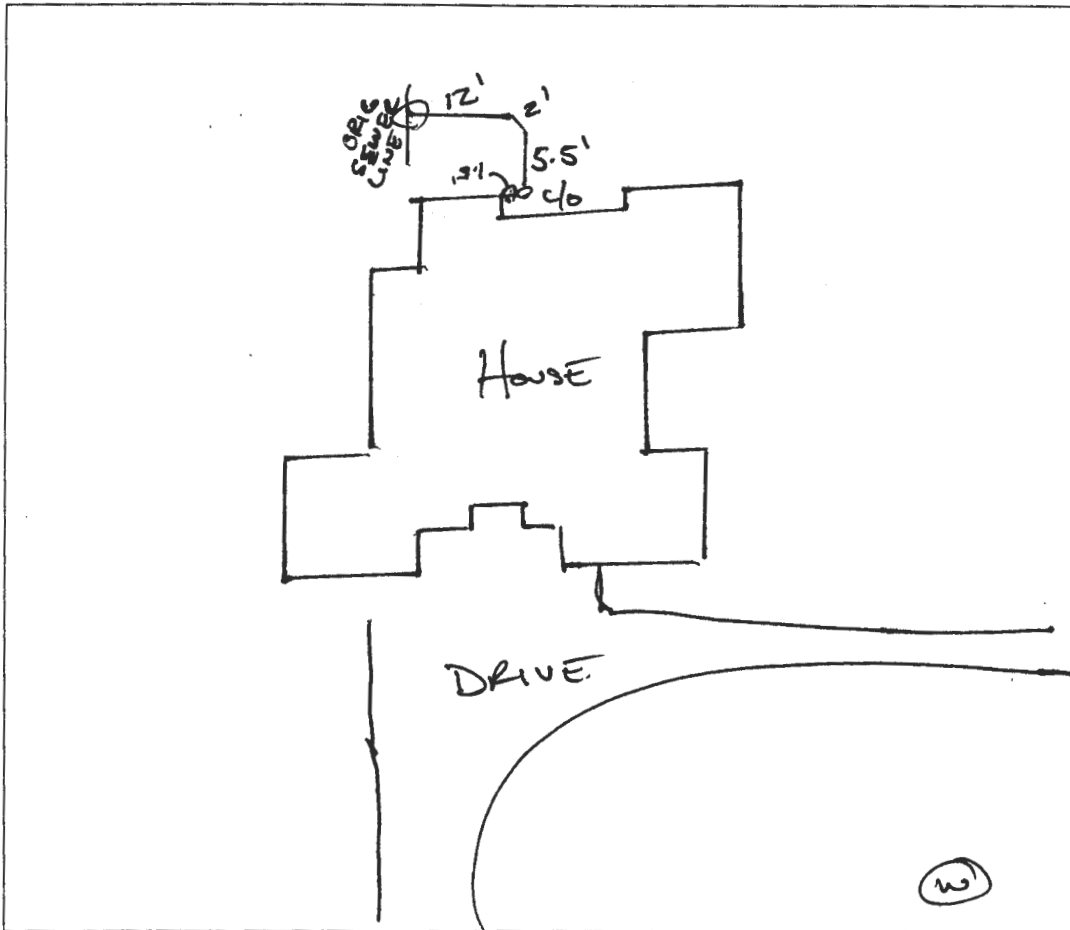

COMMENTS: ACCEPTABLE

DATE: 03/12/2021 INSPECTOR: _____

[Handwritten signature]