



# Building Permit Application

Howard County Maryland  
Department of Inspections, Licenses and Permits  
3430 Court House Drive  
Permits: 410-313-2455  
www.howardcountymd.gov

Date Received: \_\_\_\_\_

Permit No.: B18003548

OK / AKH 10/15/18

Building Address: 17124 CARROLL MILL CT  
 City: ELICOTT CITY State: MD Zip Code: 21042  
 Suite/Apt. # \_\_\_\_\_ SDP/WP/BA #: \_\_\_\_\_  
 Subdivision: \_\_\_\_\_  
 Lot: \_\_\_\_\_ Tax Map: \_\_\_\_\_ Parcel: \_\_\_\_\_

Existing Use: SFH  
 Proposed Use: SFH w/ Porch and Addition  
 Estimated Construction Cost: \$ 175000  
 Description of Work: Construct 37'8" x 14' Addition w/ full basement and partial 2nd floor and 38' x 12 deck w/ stairs

Occupant/Tenant Name: \_\_\_\_\_  
 Was tenant space previously occupied?  Yes  No  
 Contact Name: MARK REDMAN - MARK CONSTRUCTION  
 Address: PO BOX 383  
 City: ELICOTT CITY State: MD Zip Code: 21059  
 Phone: 301 776 1136 Fax: \_\_\_\_\_  
 Email: mark@markconstruction.com

Property Owner's Name: JUSTIN F KUSZMA  
 Address: 17124 CARROLL MILL CT  
 City: ELICOTT CITY State: MD Zip Code: 21042  
 Phone: \_\_\_\_\_ Fax: \_\_\_\_\_  
 Email: \_\_\_\_\_

Applicant's Name & Mailing Address, (If other than stated herein)  
 Applicant's Name: MARK CONSTRUCTION  
 Address: PO BOX 383  
 City: ELICOTT CITY State: MD Zip Code: 21059  
 Phone: 301 776 1136 Fax: \_\_\_\_\_  
 Email: mark@markconstruction.com

Contractor Company: MARK CONSTRUCTION  
 Contact Person: MARK REDMAN  
 Address: PO BOX 383  
 City: ELICOTT CITY State: MD Zip Code: 21059  
 License No.: 33363  
 Phone: 301 776 1136 Fax: \_\_\_\_\_  
 Email: mark@markconstruction.com

Engineer/Architect Company: \_\_\_\_\_  
 Responsible Design Prof.: \_\_\_\_\_  
 Address: \_\_\_\_\_  
 City: \_\_\_\_\_ State: \_\_\_\_\_ Zip Code: \_\_\_\_\_  
 Phone: \_\_\_\_\_ Fax: \_\_\_\_\_  
 Email: \_\_\_\_\_

Commercial Building Characteristics	Residential Building Characteristics	
Height:	<input checked="" type="checkbox"/> SF Dwelling <input type="checkbox"/> SF Townhouse	
No. of stories:	Depth Width	
Gross area, sq. ft./floor:	1st floor: <u>14'</u>	<u>39'4"</u>
Area of construction (sq. ft.):	2nd floor: <u>17'</u>	<u>12'7"</u>
Use group:	Basement:	
	<input checked="" type="checkbox"/> Finished Basement	
	<input type="checkbox"/> Unfinished Basement	
	<input type="checkbox"/> Crawl Space	
	<input type="checkbox"/> Slab on Grade	
	No. of Bedrooms:	
	<u>Multi-family Dwelling</u>	
	No. of efficiency units:	
	No. of 1 BR units:	
	No. of 2 BR units:	
	No. of 3 BR units:	
	Other Structure:	
	Dimensions:	
	Footings:	
	Roof:	
	<input type="checkbox"/> State Certified Modular	
	<input type="checkbox"/> Manufactured Home	
<b>Construction type:</b>		
<input type="checkbox"/> Reinforced Concrete		
<input type="checkbox"/> Structural Steel		
<input type="checkbox"/> Masonry		
<input type="checkbox"/> Wood Frame		
<input type="checkbox"/> State Certified Modular		
<b>Roadside Tree Project Permit</b>		
<input type="checkbox"/> Yes <input checked="" type="checkbox"/> No		
<b>Roadside Tree Project Permit #</b>		

Utilities	
Electric:	<input checked="" type="checkbox"/> Yes <input type="checkbox"/> No
Gas:	<input type="checkbox"/> Yes <input checked="" type="checkbox"/> No
Water Supply	
<input type="checkbox"/> Public	
<input checked="" type="checkbox"/> Private	
Sewage Disposal	
<input type="checkbox"/> Public	
<input checked="" type="checkbox"/> Private	
Heating System	
<input checked="" type="checkbox"/> Electric <input type="checkbox"/> Oil	
<input type="checkbox"/> Natural Gas <input type="checkbox"/> Propane Gas	
<input type="checkbox"/> Other:	
Sprinkler System:	
<input type="checkbox"/> Yes <input checked="" type="checkbox"/> No	
Grading Permit Number:	
Building Shell Permit Number:	

THE UNDERSIGNED HEREBY CERTIFIES AND AGREES AS FOLLOWS: (1) THAT HE/SHE IS AUTHORIZED TO MAKE THIS APPLICATION; (2) THAT THE INFORMATION IS CORRECT; (3) THAT HE/SHE WILL COMPLY WITH ALL REGULATIONS OF HOWARD COUNTY WHICH ARE APPLICABLE THERETO; (4) THAT HE/SHE WILL PERFORM NO WORK ON THE ABOVE REFERENCED PROPERTY NOT SPECIFICALLY DESCRIBED IN THIS APPLICATION; (5) THAT HE/SHE GRANTS COUNTY OFFICIALS THE RIGHT TO ENTER ONTO THIS PROPERTY FOR THE PURPOSE OF INSPECTING THE WORK PERMITTED AND POSTING NOTICES.

Applicant's Signature: Mark Redman  
 Email Address: mark@markconstruction.com  
 Title/Company: MARK CONSTRUCTION

Print Name: Mark Redman  
 Date: 10/12/18

Checks Payable to: DIRECTOR OF FINANCE OF HOWARD COUNTY  
\*\*PLEASE WRITE NEATLY & LEGIBLY\*\*  
-FOR OFFICE USE ONLY-

AGENCY	DATE	SIGNATURE OF APPROVAL
State Highways		
Building Officials		
PSZA ( Zoning )		
PSZA ( Engineering )		
Health	<u>10/31/2018</u>	<u>Mark Redman</u>

Is Sediment Control approval required for issuance?  Yes  No  
 CONTINGENCY CONSTRUCTION START

DPZ SETBACK INFORMATION	
Front:	
Rear:	
Side:	
Side St.:	
All minimum setbacks met?	<input type="checkbox"/> Yes <input type="checkbox"/> No
Is Entrance Permit Required?	<input type="checkbox"/> Yes <input type="checkbox"/> No
Historic District?	<input type="checkbox"/> Yes <input type="checkbox"/> No
Lot Coverage for New Town Zone:	
SDP/Red-line approval date:	

Filing Fee	\$	<u>25.00</u>
Permit Fee	\$	
Tech Fee	\$	
Excise Tax	\$	
PSFS	\$	
Guaranty Fund	\$	
Add'l per Fee	\$	
Total Fees	\$	
Sub- Total Paid	\$	
Balance Due	\$	
Check	#	<u>1274</u>

Approved B18003548  
R/E 10/31/2018

Dear Sir/Madame,

Enclosed is a proposal for a new septic tank, new tank location and to relocate the dry well to accommodate the new tank/location. This is to be part of construction of an addition on the back of the house at 12124 Carroll Mill Ct, Ellicott City, MD 21042. The addition will add 1 bedroom and 1 bath to make this a 5 bedroom and 3.5 bath house. The house square footage will increase from about 3000 ft<sup>2</sup> to 4300 ft<sup>2</sup>.

The following documents are enclosed in this file starting on the indicated pages:

1. Existing Septic Field on Lot Survey (1/2" = 13')	2
2. Proposed Septic Field on Lot Survey (1/2" = 13')	3
3. Scan of Lot Survey	4
4. Current As-Built Septic Documents on file with Howard County	5
5. Construction Drawings	15

A couple of initial thoughts:

- It would be great to be able to work with the fence in place (given the footing for each post is in concrete in the ground and this will be extremely difficult to repair). I imagine that it might be possible to offset the dry well to the left by a few feet to accommodate this. The line to the septic can be shifted to the right to meet the 5-ft-to-deck setback if needed.
- The current septic tank is 1250 gallons. My understanding with the new size of this house is that we will require a 2000 gallon tank. Based on our soil (Manor, from Ho. Co. Soil Survey) it is unclear if we will need to expand the field. Will a new soil percolation test be required?

Best Regards,


Justin Earp

410-531-1092

[Justin.earp@gmail.com](mailto:Justin.earp@gmail.com)

12124 Carroll Mill Ct.

Ellicott City, MD 21042

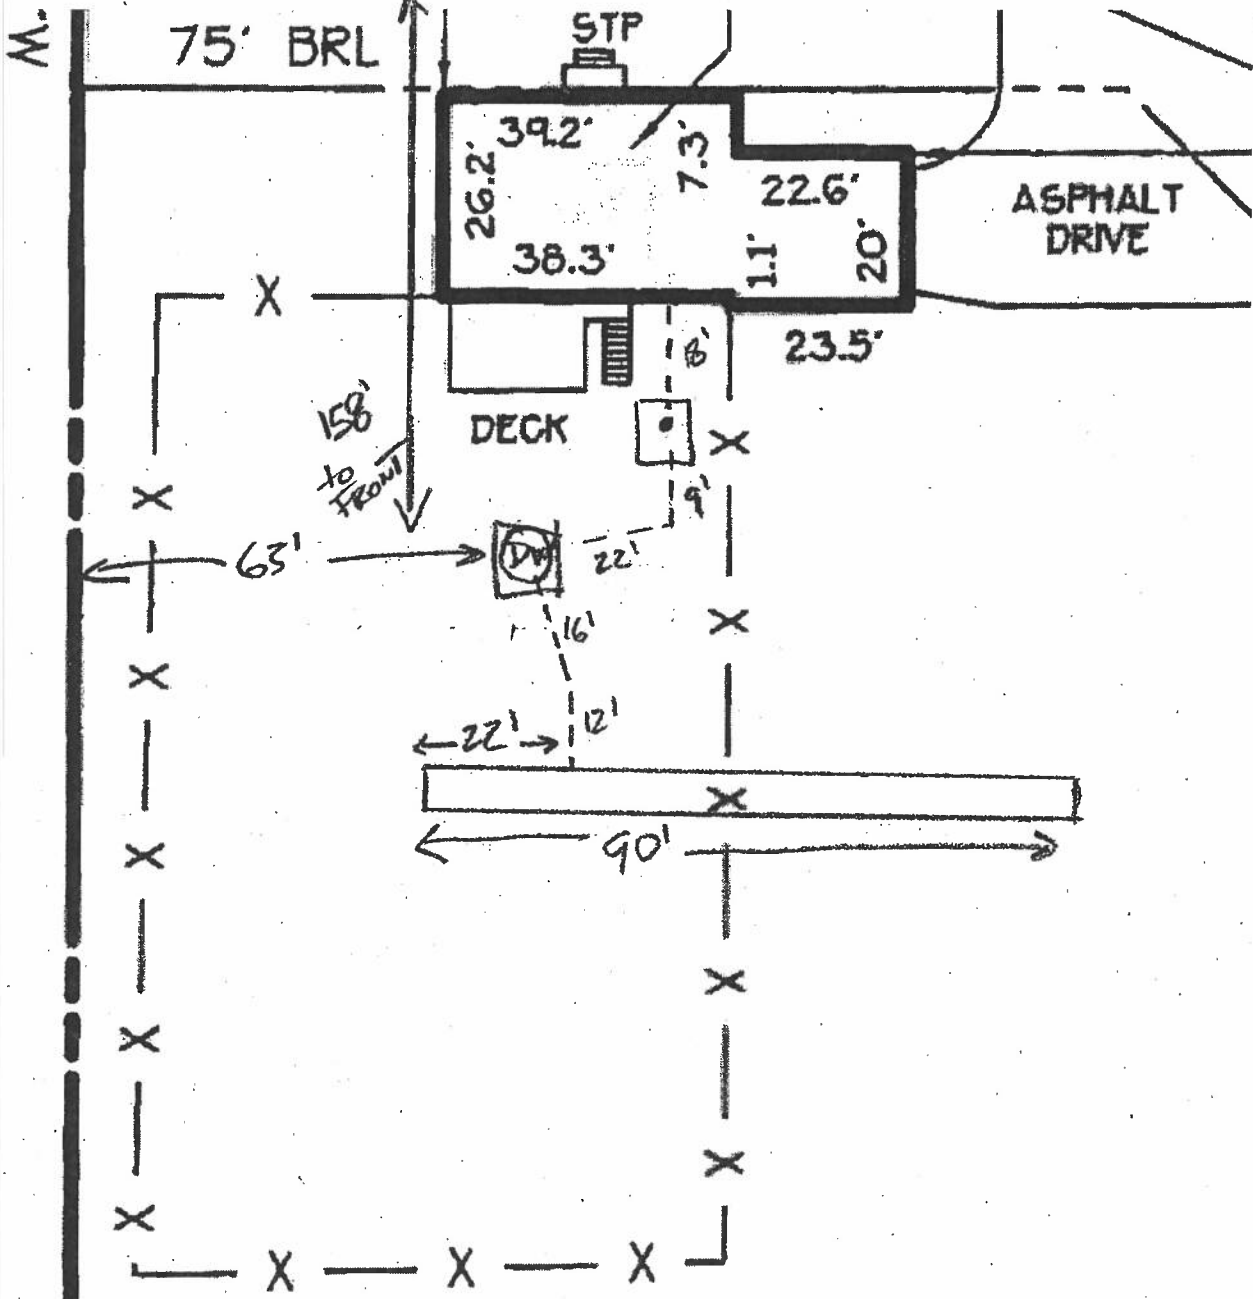

EXISTING

- 4 BEDROOM
- NO GARBAGE GRINDER
- 2.5 BATH



5' UTILITY EASEMENT

561'40"04"W

170.00'



Real Property Data Search ( w2 )


Search Result for HOWARD COUNTY

View Map		View GroundRent Redemption			View GroundRent Registration				
<b>Account Identifier:</b>		<b>District - 03 Account Number - 286746</b>							
Owner Information									
<b>Owner Name:</b>		EARP JUSTIN CRAIG EARP KIRSTEN DEXTER T/E			<b>Use:</b>		RESIDENTIAL		
<b>Mailing Address:</b>		12124 CARROLL MILL CT ELLICOTT CITY MD 21042-1308			<b>Principal Residence:</b>		YES		
					<b>Deed Reference:</b>		/12394/ 00023		
Location & Structure Information									
<b>Premises Address:</b>		12124 CARROLL MILL CT ELLICOTT CITY 21042-1308			<b>Legal Description:</b>		LOT 63 BL E S 3 12124 CARROLL MILL CT WOODMARK		
<b>Map:</b>	<b>Grid:</b>	<b>Parcel:</b>	<b>Sub District:</b>	<b>Subdivision:</b>	<b>Section:</b>	<b>Block:</b>	<b>Lot:</b>	<b>Assessment Year:</b>	<b>Plat No:</b>
0023	0007	0089		0000			63	2016	Plat Ref:
<b>Special Tax Areas:</b>				<b>Town:</b>		NONE			
				<b>Ad Valorem:</b>		100			
				<b>Tax Class:</b>					
<b>Primary Structure Built</b>		<b>Above Grade Living Area</b>		<b>Finished Basement Area</b>		<b>Property Land Area</b>		<b>County Use</b>	
1970		2,028 SF		941 SF		1,2600 AC			
<b>Stories</b>	<b>Basement</b>	<b>Type</b>	<b>Exterior</b>	<b>Full/Half Bath</b>	<b>Garage</b>	<b>Last Major Renovation</b>			
2	YES	STANDARD UNIT	FRAME	2 full/ 1 half	1 Attached				
Value Information									
		<b>Base Value</b>	<b>Value</b>		<b>Phase-in Assessments</b>				
			As of		As of		As of		
			01/01/2016		07/01/2017		07/01/2018		
<b>Land:</b>		236,800	236,800						
<b>Improvements</b>		238,700	254,000						
<b>Total:</b>		475,500	490,800		485,700		490,800		
<b>Preferential Land:</b>		0					0		
Transfer Information									
<b>Seller:</b> MYERS JAMES			<b>Date:</b> 04/06/2010			<b>Price:</b> \$585,000			
<b>Type:</b> ARMS LENGTH IMPROVED			<b>Deed1:</b> /12394/ 00023			<b>Deed2:</b>			
<b>Seller:</b> MYERS JAMES EMMIT			<b>Date:</b> 02/01/2007			<b>Price:</b> \$0			
<b>Type:</b> NON-ARMS LENGTH OTHER			<b>Deed1:</b> /10502/ 00646			<b>Deed2:</b>			
<b>Seller:</b> HARMAN RICHARD T & WF			<b>Date:</b> 11/20/1987			<b>Price:</b> \$230,000			
<b>Type:</b> ARMS LENGTH IMPROVED			<b>Deed1:</b> /01751/ 00648			<b>Deed2:</b>			
Exemption Information									
<b>Partial Exempt Assessments:</b>		<b>Class</b>			07/01/2017		07/01/2018		
<b>County:</b>		000			0.00				
<b>State:</b>		000			0.00				
<b>Municipal:</b>		000			0.00 0.00		0.00 0.00		
<b>Tax Exempt:</b>			<b>Special Tax Recapture:</b>						
<b>Exempt Class:</b>			NONE						
Homestead Application Information									
<b>Homestead Application Status:</b> Approved 02/08/2011									
Homeowners' Tax Credit Application Information									
<b>Homeowners' Tax Credit Application Status:</b> No Application					<b>Date:</b>				

- Perc Cert
- Upgrade
- Well tested






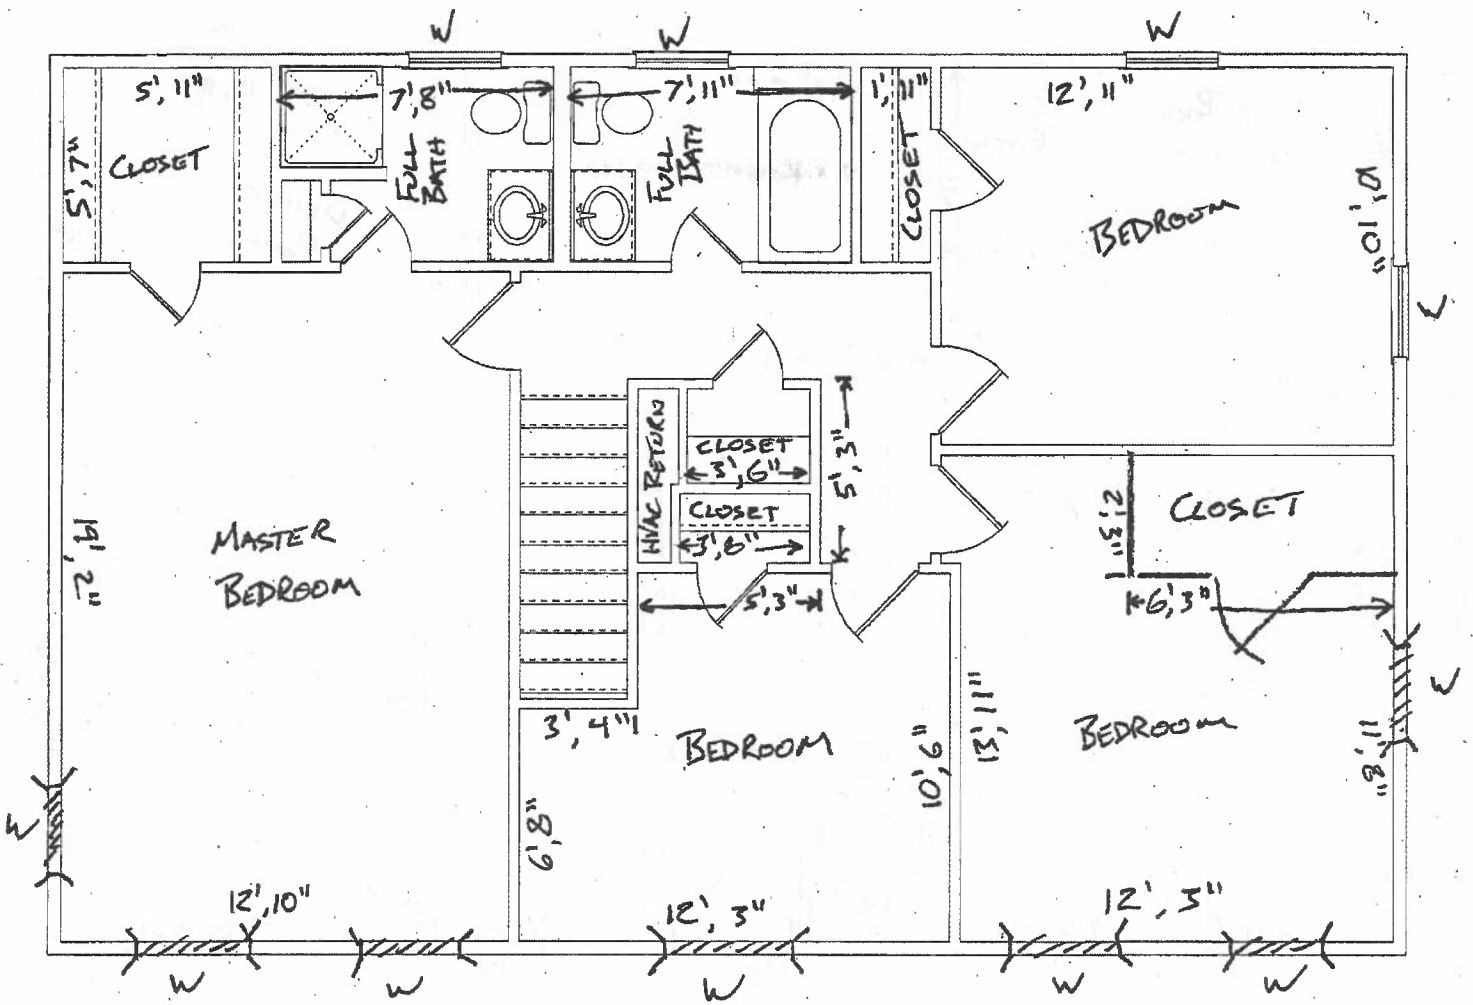

HDR

2ND FLOOR


Existing

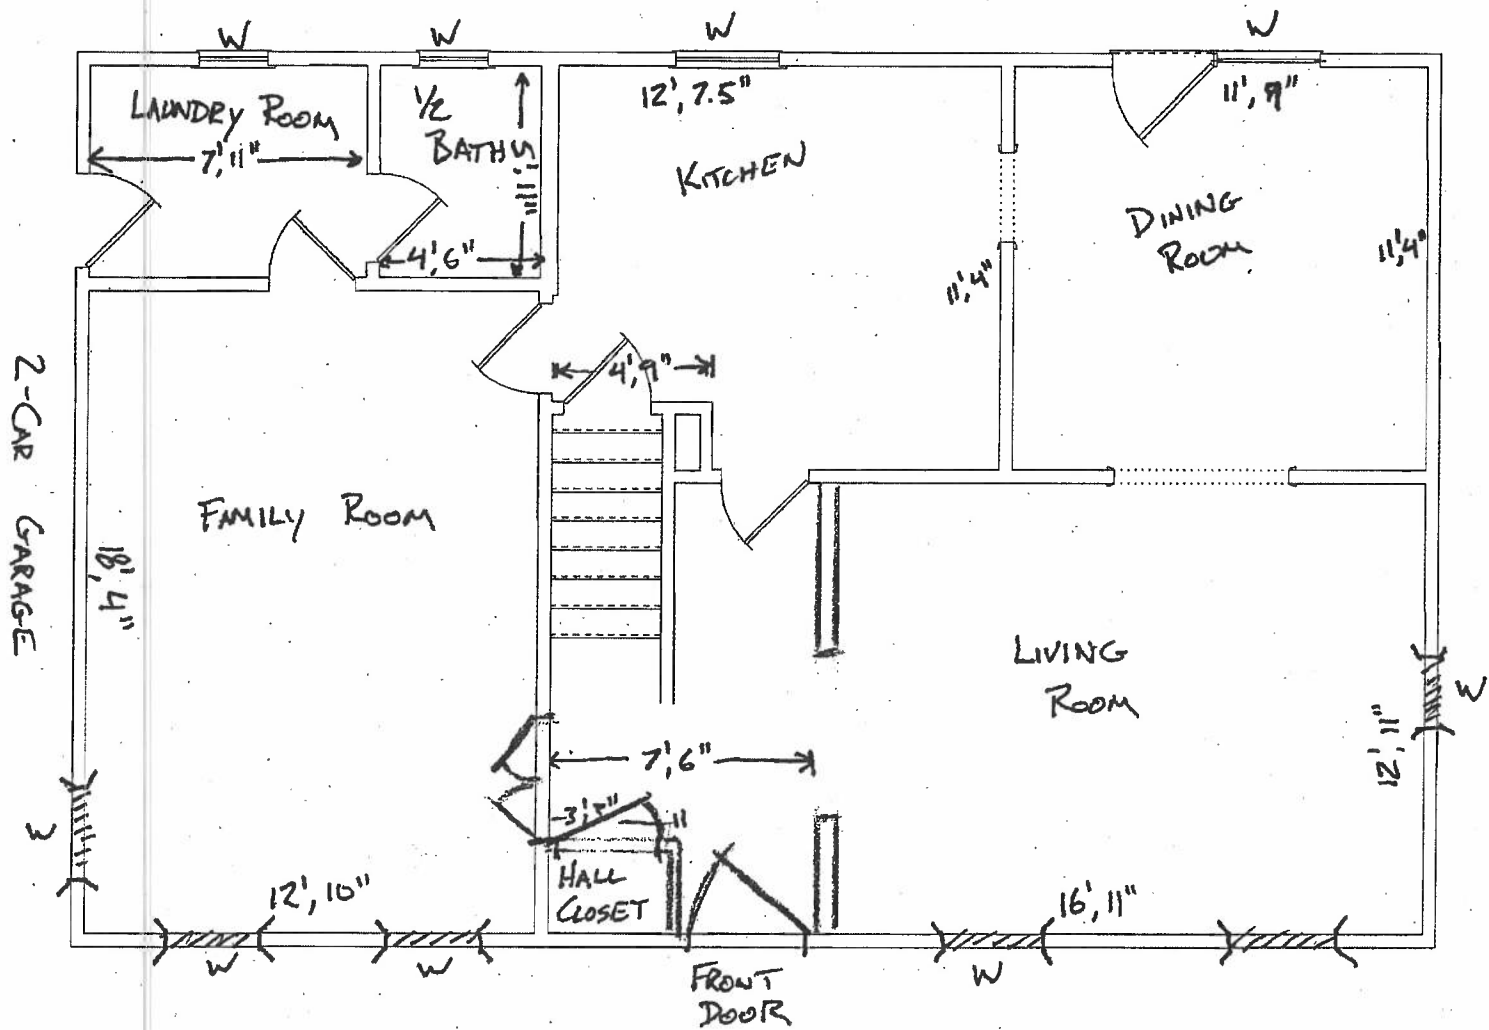

1ST FLOOR


Existing OBR



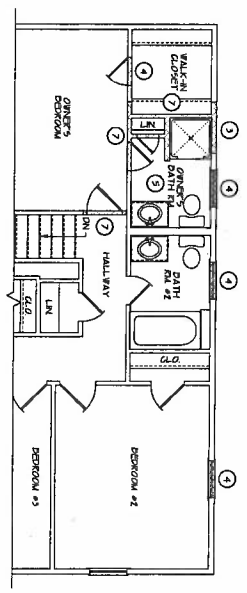


EXISTING SECOND LEVEL FLOOR PLAN - DEMO


- 1 REMOVE WINDOW, CUT NEW DOOR OPENING
- 2 REMOVE PREPARED TREATED DECK
- 3 REMOVE REARING WALL, INSTALL NEW DECK AS NOTED
- 4 REMOVE RADIATOR AND/OR WINDOW, FRAME AND FINISH
- 5 REMOVE LAUNDRY ROOM AND PLUMBING PARTITIONS
- 6 REMOVE KITCHEN CABINETS IN LOWER LEVEL
- 7 REMOVE WALL, REMOVE AND/OR DOOR
- 8 REMOVE HANG CASK, NEW CASSED OPENING
- 9 REPLACE EXISTING WITH EXISTING WINDOW

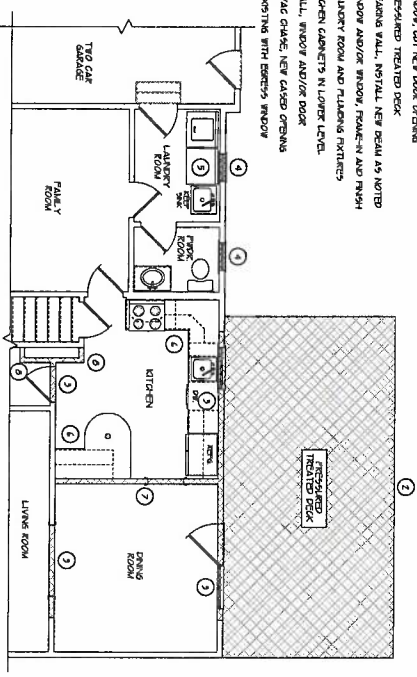


EXISTING FIRST LEVEL FLOOR PLAN - DEMO

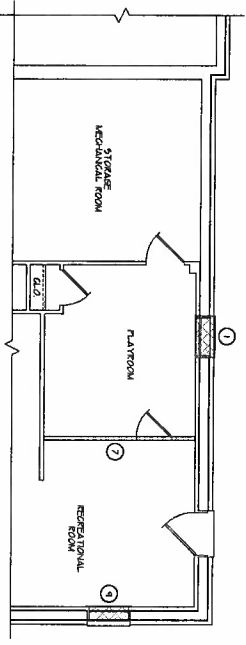


EXISTING LOWER LEVEL FLOOR PLAN - DEMO

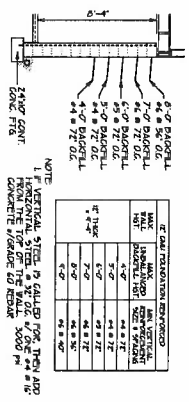

- 1 R-19 EPS INSULATION
- 2 R-19 EPS INSULATION
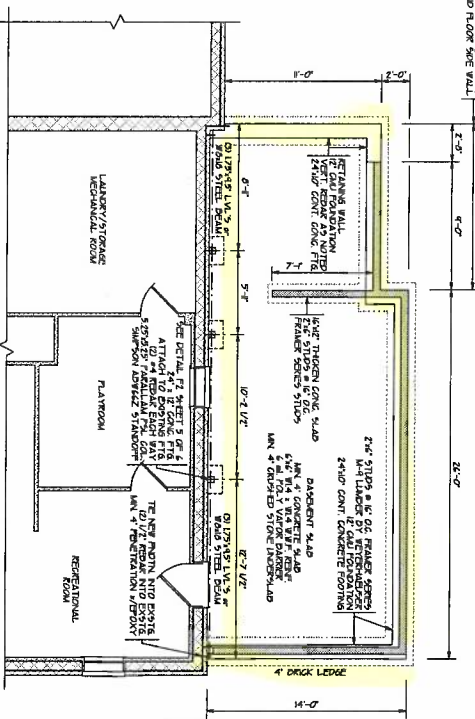

FOUNDATION PLAN

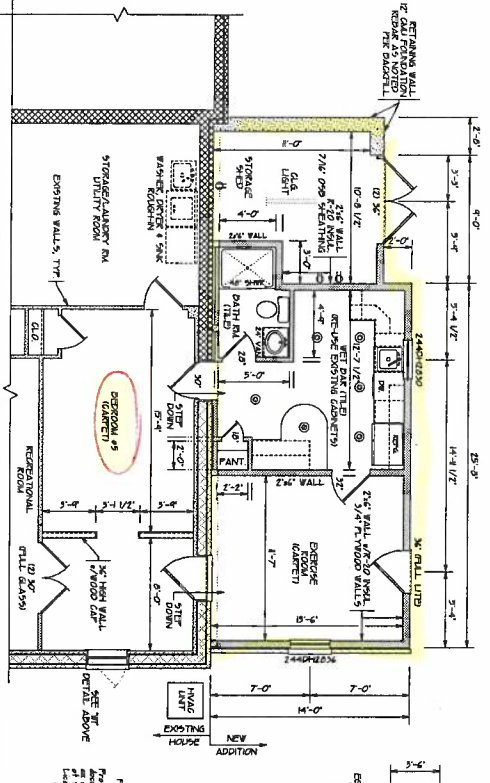

LOWER LEVEL FLOOR PLAN

SCALE 1/4" = 1'-0"


SHEET NO. 1 of 6

Authorization/Limitations for Use of Plans  
 This set of drawings, including all specifications and notes, is the property of Creative Outlooks, LLC. A copy of these drawings may be made for the use of construction. It is understood and agreed that these drawings are not to be copied, reproduced or otherwise used without the written permission of Creative Outlooks, LLC.  
 Copyright Creative Outlooks, LLC.  
 All rights reserved 2010

CREATIVE OUTLOOKS, LLC  
 PHILIP F. GILKILLAZA  
 CUSTOM HOME PLANNERS & DESIGN  
 HOUSE ADDITION/REMODELING DESIGN  
 COMPLETE CONSTRUCTION PLANS  
 PHONE: 410-946-1022 P6CREATE@GMAIL.NET


EXISTING FLOOR PLANS & FOUNDATION & LOWER PLAN  
 PROJECT FOR: KIRSTEN & JUSTIN EARP  
 1212 CARROLL MILL CT.  
 ELLICOTT CITY, MARYLAND 21042  
 DATE: FEB. 1, 2010  
 SCALE: 1/4" = 1'-0"  
 DRAWN BY: P. F. GILKILLAZA

Adding Bedroom

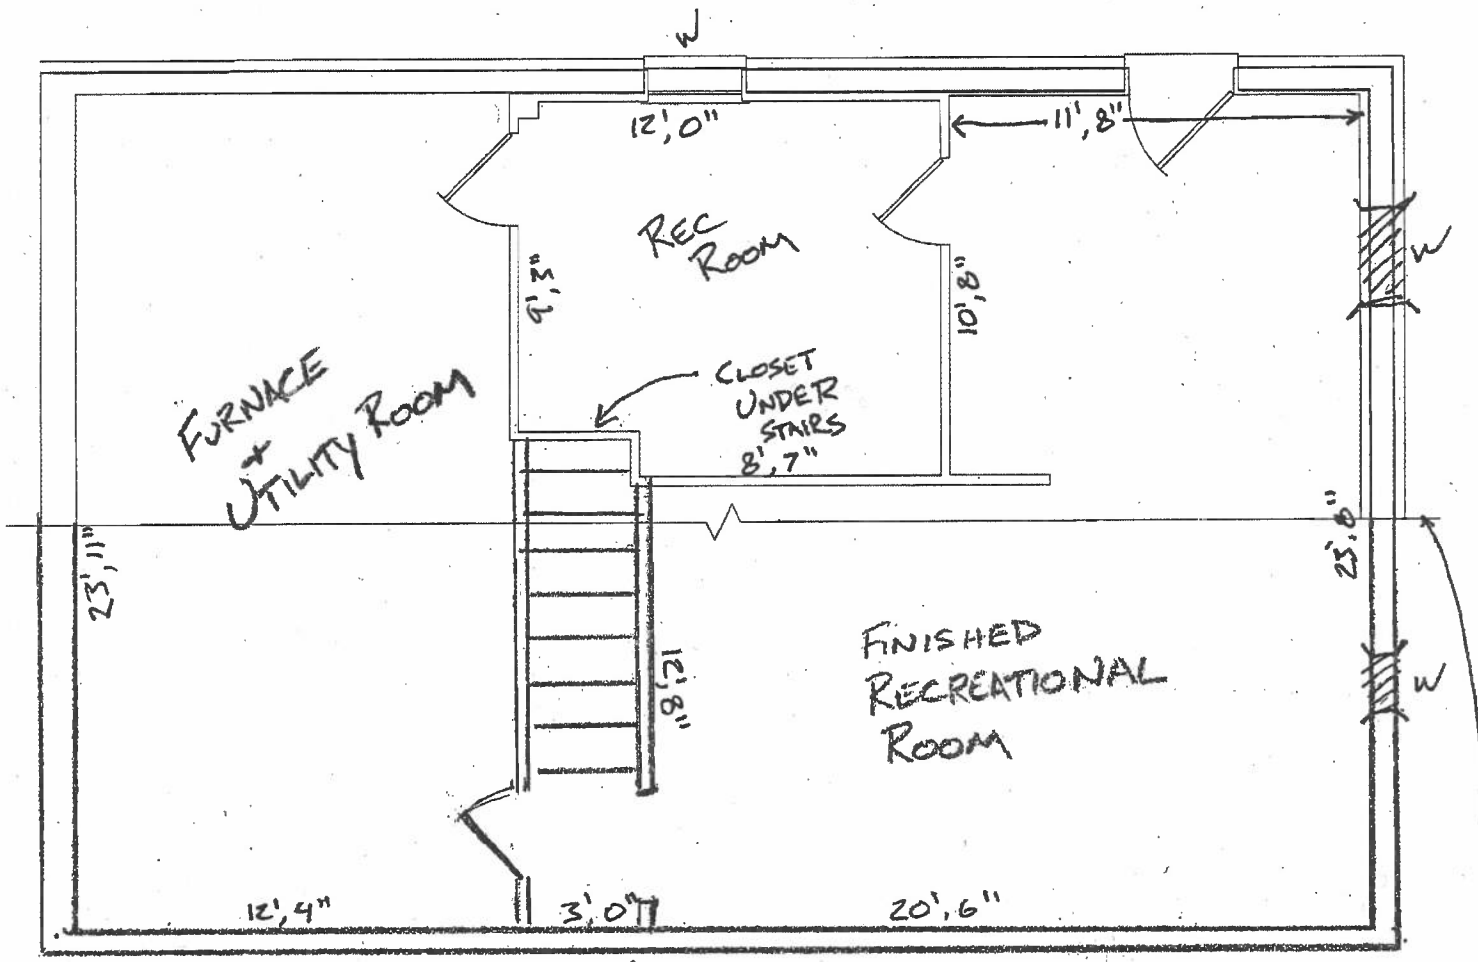

BASEMENT

IGNORE THIS LINE

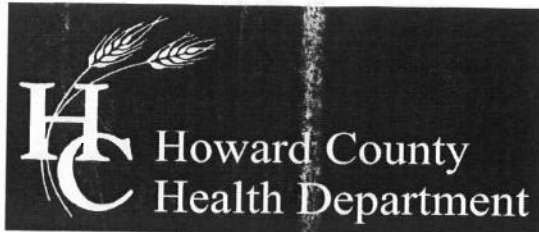

## Bureau of Environmental Health

8930 Stanford Boulevard, Columbia, MD 21045

Main: 410-313-2640 | Fax: 410-313-2648

TDD 410-313-2323 | Toll Free 1-866-313-6300

[www.hchealth.org](http://www.hchealth.org)

Facebook: [www.facebook.com/hocohealth](http://www.facebook.com/hocohealth)

Twitter: [HowardCoHealthDep](https://twitter.com/HowardCoHealthDep)

Maura J. Rossnan, M.D., Health Officer

### MEMORANDUM

TO: Justin Earp  
12124 Carroll Mill Ct.  
Ellicott City, MD 21042

FROM: Robert Freemon *RF*  
Well & Septic Program

RE: Woodmark, Lot 63 BL E S 3  
12124 Carroll Mill Ct.  
Ellicott City, MD 21042  
"Future Building Permit"

DATE: 3/5/18

After review of the property file in conjunction with your proposed future building permit here are my comments. Before this future building permit could be approved you would be required to have a percolation certification plan signed by the Health Department designating a sewage disposal area (SDA) on the property and a septic system adequate enough to handle the proposed 5 bedroom house. According to our records this property does not have a percolation certification plan signed by the Health Department nor is the existing septic system adequate for a 5 bedroom house. Health Department approval of a percolation certification plan and the installation of an upgraded septic system would be required prior to building permit approval.

**Percolation Certification Plan:** Before the Health Dept. can certify a percolation plan perc testing must be performed. Prior to testing the Health Dept. must receive a filled out perc application, the fee of \$506 (payable to the Director of Finance) and a perc test plan. The fee for the perc permit would cover Health's testing, plan review and certification. You would need to hire a septic contractor or a friend with a backhoe who can dig several holes 12-14ft deep. As for the test plan you will want to hire a civil engineer if you are not familiar with our process or engineer work in general. Once the Health Dept. has received all three (application, fee, test plan) and we are satisfied with the test plan we will schedule a date for perc testing. Based on the test results a Percolation Certification Plan may be finalized and a septic system specification sheet may be created.

**Septic Plan:** Using the septic specifications given and the number of bedrooms being proposed the engineer will come up with a septic plan. This septic plan must show three systems, an initial and two replacements fitting inside of the newly designated SDA. If the engineer cannot fit 3 systems the Health Dept. may consider allowing an initial and one replacement which would

require Best Available Technology (BAT). Once the Health Dept. has approved of a septic plan the septic system will need to be installed and receive a final inspection approval prior to approval of the building permit.

## Freemon, Robert

---

**From:** Freemon, Robert  
**Sent:** Monday, July 30, 2018 1:16 PM  
**To:** 'Justin Earp'; Kirsten Earp  
**Subject:** RE: Plans required before building permit

Hi Justin,

Before the Health Dept. can sign off on the building permit here is what's required.

- A Septic Plan Designed for 5 bedrooms, approved by the Health Dept.
- The abandonment of the existing septic system (Documentation Sent to Health Dept.)
- The installation of the approved septic system.

Before the septic system is installed the septic contractor will need to come to the Health Dept. to pick up a septic permit (\$396). During this time the engineer/surveyor will need to stake out the proposed system on the property. The septic contractor will then need to call the Health Dept. to schedule a layout inspection. Once the inspection is approved installation of the proposed septic system can begin. At different stages of the installation (Tank Install, Trench Install) the contractor will need to call for inspections prior to covering up the work. The system will then receive a final inspection prior to Health signing off on the building permit.

Just so you know you can submit the building permit application for the addition prior to the above being completed so other Depts. can have their review. The Health Dept. just won't sign off on it until the work has been completed. If this is of interest to you I would discuss this with the Dept. of Inspections Licenses and Permits (DILP) prior to doing so. They will be able to tell you what you should keep in mind if this is what you would like to do. If you have any other questions let me know.

*Robert "Spencer" Freemon*

*Howard County Health Department*

*8930 Stanford Blvd. Columbia, MD 21045*

*Bureau of Environmental Health*

*Well and Septic Program*

*Phone: 410-313-6357*

*Email: [rfreemon@howardcountymd.gov](mailto:rfreemon@howardcountymd.gov)*

*Website: <https://www.howardcountymd.gov/Departments/Health/Environmental-Health/Well-and-Septic>*

**From:** Justin Earp [<mailto:justin.earp@gmail.com>]  
**Sent:** Friday, July 27, 2018 3:16 PM  
**To:** Freemon, Robert; Kirsten Earp  
**Subject:** Plans required before building permit

Hi Robert,

Can you outline for me the plans and aspects of the septic installation that you will require before I can submit a building permit request?

That is once the septic design plan is approved can we move to install the system?

Thanks,  
Justin

**Freemon, Robert**

---

**From:** Freemon, Robert  
**Sent:** Friday, July 20, 2018 2:00 PM  
**To:** 'Justin Earp'  
**Cc:** Shanaberger & Lane  
**Subject:** 12124 Carroll Mill Rd.  
**Attachments:** Specs.pdf; Septic Design Req.pdf; Well & Septic SETBACKS.PDF

Hi,

I just wanted to let you know the Perc Cert has been approved by the Health Dept. Now I need a septic design plan for the proposed 5 bedroom house. If you need anything or have any questions don't hesitate to ask. You may come by the Health Dept. anytime between 8:30 and 4:00 to pick up a copy of the signed perc cert.

**Robert "Spencer" Freemon**  
**Howard County Health Department**  
**8930 Stanford Blvd. Columbia, MD 21045**  
**Bureau of Environmental Health**  
**Well and Septic Program**  
**Phone: 410-313-6357**  
**Email: [rfreemon@howardcountymd.gov](mailto:rfreemon@howardcountymd.gov)**  
**Website: <https://www.howardcountymd.gov/Departments/Health/Environmental-Health/Well-and-Septic>**