

APPLICATION

FOR PERCOLATION TESTING AND SITE EVALUATION

TEST DATE(S) _____ TEST TIME _____

AP 523834

AGENCY REVIEW: _____

DATE 12/20/05

DO NOT WRITE ABOVE THIS LINE

I HEREBY APPLY FOR THE NECESSARY TESTING/EVALUATION PRIOR TO ISSUANCE OF SEWAGE DISPOSAL SYSTEM PERMIT(S) TO:

CHECK AS NEEDED:

- CONSTRUCT NEW SEPTIC SYSTEM(S)
- REPAIR/ADD TO AN EXISTING SEPTIC SYSTEM
- REPLACE AN EXISTING SEPTIC SYSTEM

CHECK AS NEEDED:

- NEW STRUCTURE(S)
- ADDITION TO AN EXISTING STRUCTURE
- REPLACE AN EXISTING STRUCTURE

CHECK ONE:

- CREATE NEW LOT(S)
- BUILD ON AN EXISTING LOT IN A SUBDIVISION
- BUILD ON AN EXISTING PARCEL OF RECORD

IS THE PROPERTY WITHIN 2500' OF ANY RESERVOIR?

- YES
- NO

THE TYPE OF STRUCTURE IS:

- RESIDENTIAL WITH _____ PROPOSED BEDROOMS IN THE COMPLETED STRUCTURE (NOTE *UNKNOWN* IF APPROPRIATE)
- COMMERCIAL (PROVIDE DETAIL OF NUMBERS AND TYPES OF EMPLOYEES/ CUSTOMERS ON ACCOMPANYING PLAN)
- INSTITUTIONAL/GOVERNMENT (PROVIDE DETAIL OF NUMBERS AND TYPES OF EMPLOYEES/USERS ON ACCOMPANYING PLAN)

PROPERTY OWNER(S) Quartz Hill, LLC - John Congedo

DAYTIME PHONE (410) 880-3006 CELL (443) 463-2717 FAX (301) 604-3143

MAILING ADDRESS 885 Rt 97 (Hoods Mill Rd.) Cooksville MD 21723
STREET CITY/TOWN STATE ZIP

APPLICANT Quartz Hill, Section 2

DAYTIME PHONE (410) 880-3006 CELL (443) 463-2717 FAX (301) 604-3143

MAILING ADDRESS 885 Rt 97 (Hoods Mill Rd.) Cooksville MD 21723
STREET CITY/TOWN STATE ZIP

APPLICANT'S ROLE: DEVELOPER BUILDER BUYER RELATIVE/FRIEND REALTOR CONSULTANT

PROPERTY LOCATION
SUBDIVISION/PROPERTY NAME Northwest corner of Rt 97 & Rt 99 LOT NO. 62

PROPERTY ADDRESS Behind Parcel 33, 2 of 4
STREET TOWN/POST OFFICE

TAX MAP PAGE(S) 8 GRID _____ PARCEL(S) _____ PROPOSED LOT SIZE _____

AS APPLICANT, I UNDERSTAND THE FOLLOWING: THE SYSTEM INSTALLED SUBSEQUENT TO THIS APPLICATION IS ACCEPTABLE ONLY UNTIL PUBLIC SEWERAGE IS AVAILABLE. THIS APPLICATION IS COMPLETE WHEN ALL APPLICABLE FEES AND A SUITABLE SITE PLAN HAVE BEEN RECEIVED. I ACCEPT THE RESPONSIBILITY FOR COMPLIANCE WITH ALL M.O.S.H.A. AND "MISS UTILITY" REQUIREMENTS. APPROVAL IS BASED UPON SATISFACTORY REVIEW OF A PERC CERTIFICATION PLAN.

TEST RESULTS WILL BE MAILED TO APPLICANT.

John Congedo
SIGNATURE OF APPLICANT

A/P

3 1/2'
 grey bin
 SIL
 sbk cap
 pebbles 40%
 yhrn
 L-SL
 2' west
 rock pocket
 10-15%
 12' Bottom

(72)

See #77
 grey bin
 SIL / packets
 EL
 3 1/2'

1.5' SL
 yhrn
 w.c.s.g
 Rock < 10%

15' Bottom

(73)

Strong
 silt
 4'

5'
 yhrn
 SL
 w.c.s.g

Bottom 12'


DATE	TEST #	DEPTH	START	BREAK 1" DROP	STOP 2" DROP	TIME OF 2nd INCH	P/F/H
2/22/2017	#77	4' 2"	12:44	12:46	12:49	3+	P
	#72	Visual	Pass				P
	Tested on animal soil's side (W) #73	6' 5'	12:51	12:52	12:56	4+	P

REMARKS Shared System Holes
 SANITARIAN Kace BACKHOE Hotfields OTHERS _____
 TEST HOLES USED IN SDA _____ AVG. PERC TIME _____ SQ. FT/BR _____
 TRENCH WIDTH _____ INLET DEPTH _____ MAX. BOT DEPTH _____ EFFECTIVE SW _____

A/P
 72
 ny brn sil
 5'
 Lamm - sil
 w/ org; brn flocks
 8'
 No sil structure (w/ - in) on N wall keep pocket
 12' Bottom

(85)
 org. str g. org. S.L./sil
 Compact L. w/ pockets of SL
 12' Bottom

W/ 82
 W/ 82
 Brn
 ny Lamm sil w/ clay skins
 SBK
 N. EAST WALL strong org CL
 62' 7 1/2'
 SLOAM ON E. WALL ONLY
 12' Bottom

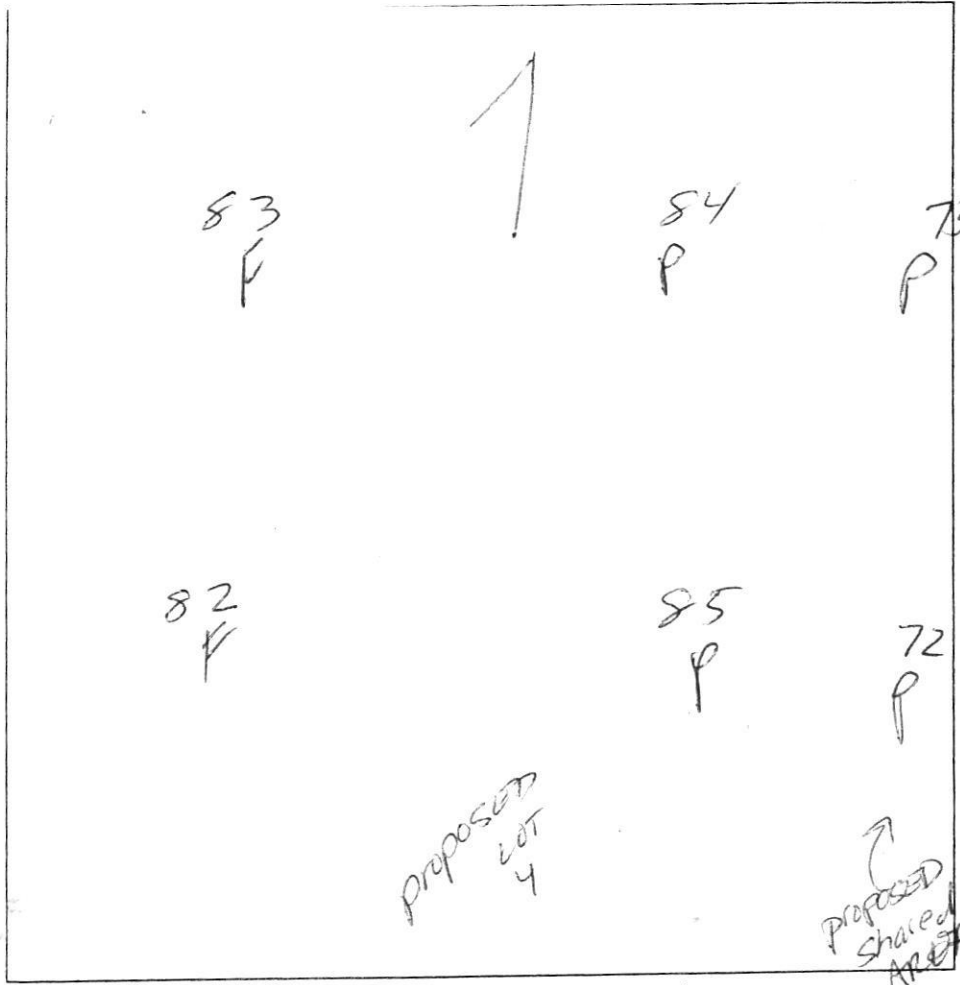

3' brn w/ rbrn CL
 3'
 Str brn CL
 1 1/2'
 7' Mudge SL
 Sil pockets
 12' Bottom
 84 / 73
 Strong org sil
 4'
 ybrn SL w/ s.g.
 12' Bottom

DATE	TEST #	DEPTH	START	BREAK 1" DROP	STOP 2" DROP	TIME OF 2nd INCH	P/F/H
2/22/00	72	SEE NOTES ON ITOL #73					P
	85	6' 9"	1:00	1:02	1:05	3'	P
	82	Visual SEE #3		1:52	TOO SLOW		F
	83	7'	1:11	1:15	1:20		F
	(84)	Work on sil disposal SEE #73 soil profiles					F
							P

REMARKS _____
 SANITARIAN Karu Noonan BACKHOE Hoffelds OTHERS _____
 TEST HOLES USED IN SDA _____ AVG. PERC TIME _____ SQ. FT/BR _____
 TRENCH WIDTH _____ INLET DEPTH _____ MAX. BOT DEPTH _____ EFFECTIVE S/W _____

Parcel 'A'

Proposed ~~LOT 4~~ Parcel 'A'

AP 523834

N

(321)
 Str brn
 hvy L
 sbk
 CLAY
 Bridges
 3'
 Str org brn
 SiCL
 Overall
 chert
 frags 15-20%
 7' ?
 Loam /
 SL
 w.c.s.g
 BOTTOM 12'

322

325 should
 hold
 see
 next
 page

321

320

High elev.

(322)
 Rx lens
 4 brn.
 brn
 West wall
 SiCL
 hvy L
 3'
 org brn
 SiCL
 w/ stone 10%
 Cobbles 10-15%
 6'
 Lt brn
 brn
 org brn
 SL-L
 saproducte 15%
 5'
 BOTTOM 13'

DATE	TEST #	DEPTH	START	BREAK 1" DROP	STOP 2" DROP	TIME OF 2ND INCH	PIF/H
4-18-00	321	7'	9:55	10:04	10:19	14'	P
	322	7'	10:23	10:31	10:42	11'	P
	320	5 1/2'	10:25	10:28	10:32	(4)	P

(320)
 org brn,
 brn
 Loam
 5' abrupt
 Lt brn
 brn
 SL
 (v.f. gr)
 wk sapr.
 10%
 BOTTOM 12'

REMARKS Holes dug per stake
 SANITARIAN Race BACKHOE Hot fields OTHERS Angedo
 TEST HOLES USED IN SDA _____ AVG. PERC TIME _____ SQ. FT/BR _____
 TRENCH WIDTH _____ INLET DEPTH 4 MAX. BOT DEPTH 8 EFFECTIVE SW 1'

AP 523834

Proposed LOT 4 6

N

321
 Str brn
 hvy L
 sbk
 CLAY
 Bridges 3'
 Str org brn
 SiCL
 Overall
 chert
 frags 15-20%
 7' ?
 Loam /
 SL
 w.c.s.g
 BOTTOM 12'

322

325 should
 hole
 see
 next
 page

321

320

High elev.

322
 Rx lens
 4 brn.
 brn
 west
 wall
 SiCL
 hvy L
 3'
 org brn
 SiCL
 w/ stone 10%
 Cobbles 10-15%
 6'
 Lt brn
 brn
 org brn
 SL-L
 Sapr. 15%
 BOTTOM 13'

320
 org brn,
 brn
 Loam 5' abrupt
 Lt brn
 brn
 SL
 (v.f. gr)
 wk Sapr.
 10%
 BOTTOM 12'

DATE	TEST #	DEPTH	START	BREAK 1" DROP	STOP 2" DROP	TIME OF 2ND INCH	P/F/H
4-18-06	321	7'	9:55	10:04	10:19	14'	P
	322	7'	10:23	10:31	10:42	11'	P
	320	5 1/2'	10:25	10:28	10:32	4'	P

REMARKS Holes dug per stake
 SANITARIAN Race BACKHOE Hot fields OTHERS Angedo
 TEST HOLES USED IN SDA _____ AVG. PERC TIME _____ SQ. FT/BR _____
 TRENCH WIDTH _____ INLET DEPTH 4 MAX. BOT DEPTH 8 EFFECTIVE SW 1'

Follow-up Percs

Lot 6


A/P

4.1
 fails
 excessive
 rx starts
 @ 3 1/2'
 refusal
 @ 5'

4.2
 org brn
 SL/L

10' chart
 mag 2 330'
 Bottom

2.3
 org brn
 brn
 hvy L
 Robbins
 1-1 1/4"
 Hbrn brn
 SL
 Sphelite
 10-15%
 BOTTOM 14'

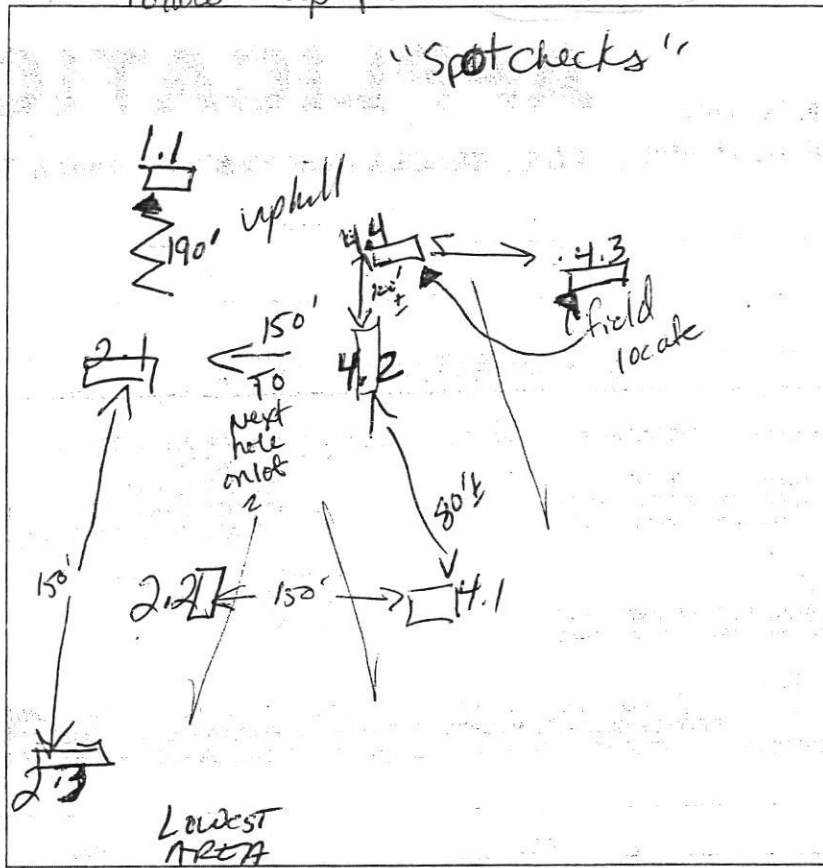

2.2
 N wall
 org brn
 str brn
 hvy L few stones
 (Swall - 3pt sil
 w/L packets
 to 4')
 5 1/2'
 brn, w/c org brn
 LS-S
 12' BOTTOM


2.1
 Str brn
 sil
 5'
 Hbrn
 SL
 Rock < 10%
 14' BOTTOM

1.1
 org brn
 SL
 slab
 6'
 LS with
 flintstone
 sil packets
 230%
 10'
 Hbrn
 sil/L
 compact
 12' BOTTOM

DATE	TEST #	DEPTH	START	BREAK 1" DROP	STOP 2" DROP	TIME OF 2ND INCH	P/F/H
7-3-06	4.2	4 1/2'	9:31	9:34	9:37	4	P
	2.3	5'3"	10:31	10:35	10:40	5	P
	2.2	5 1/2'	10:46	10:50	10:55	5	P
	2.1	Visual	definite A -> B horz change		ESTS		P
	1.1	12'	10 gallons 11:17/11:28		11:42	14 min	P
	4.4	fails	excessive rx in sand > 50%				F
		12'	- 10 gallons 30 sec.				
	4.3	Visual	sil/L @ 3' down		trace rx		P

REMARKS: Holes dug per stake except 4.3 & 4.4
 SANITARIAN: Kace BACKHOE: Hatfields OTHERS:
 TEST HOLES USED IN SDA: _____ AVG. PERC TIME: _____ SQ. FT/BR: _____
 TRENCH WIDTH: _____ INLET DEPTH: _____ MAX. BOT DEPTH: _____ EFFECTIVE SW: _____

Copy: Perc Cert
signed 10/11/13 RB

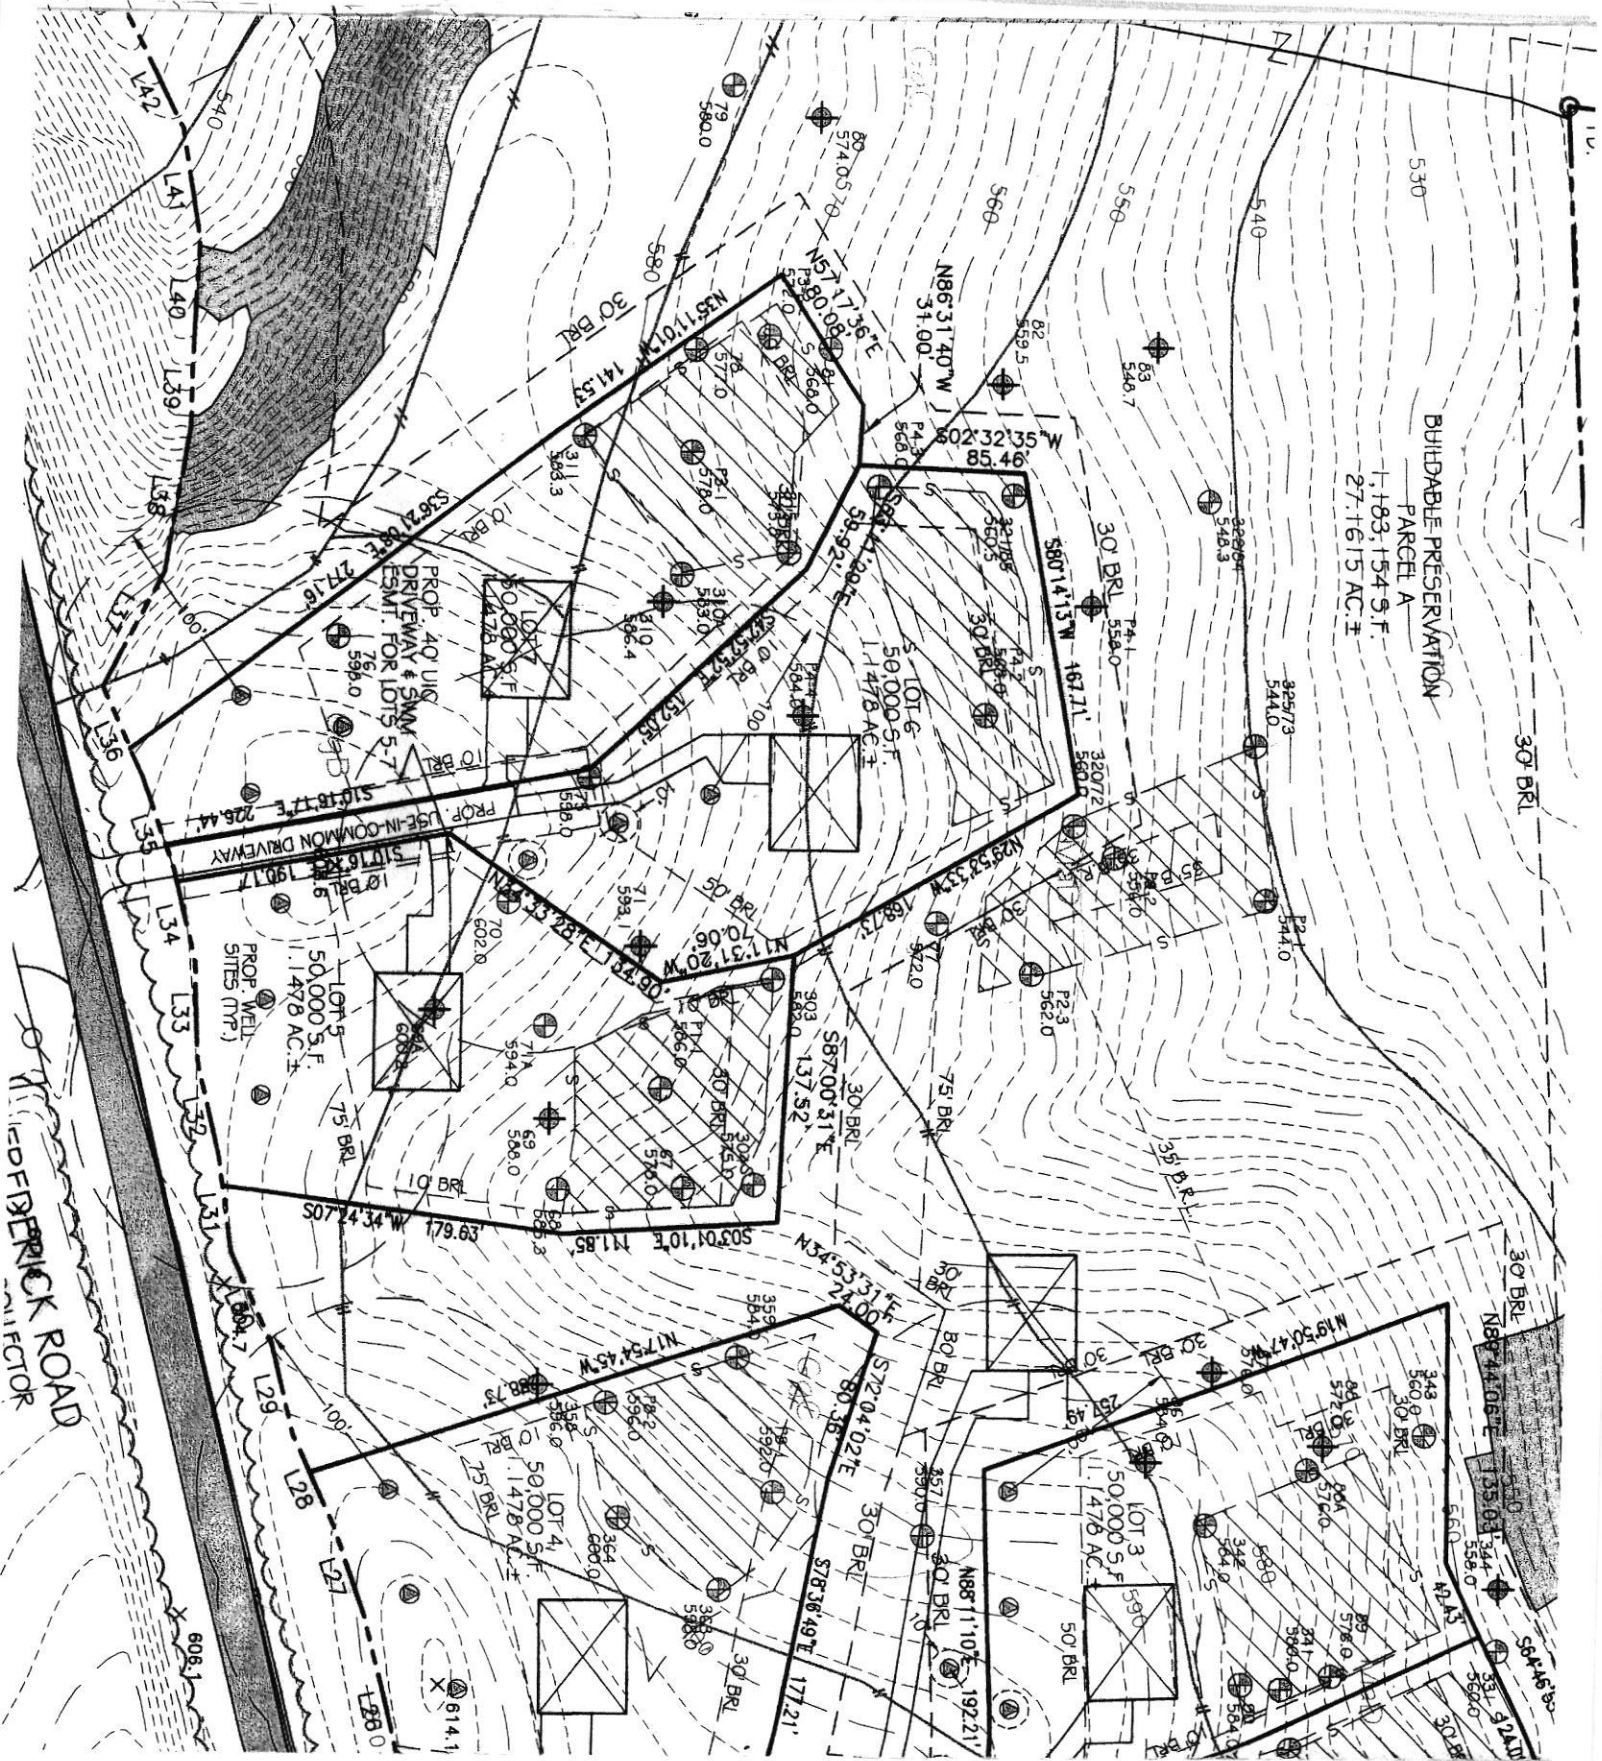


A/P

Lot 6

86
 87
 88
 Bottom

84 / 7.3
 Strong
 silt
 ybrn
 SL
 w.c.s.g.
 Bottom

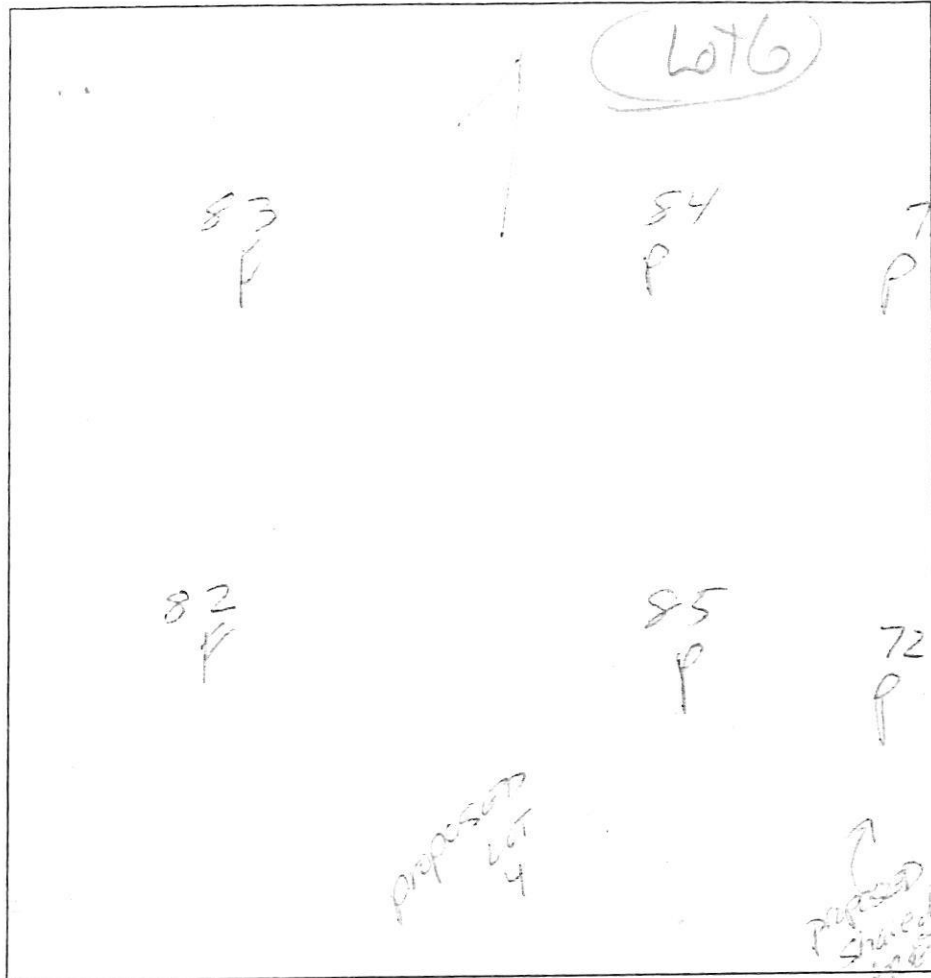

81
 82
 83
 Bottom

81
 82
 83
 Bottom

81
 82
 83
 Bottom

DATE	TEST #	DEPTH	START	BREAK 1" DROP	STOP 2" DROP	TIME OF 2nd INCH	P/F/H
2/22/62	72	5' 10" to 6' 0"	5' 73				P
	85	6' 0"	100	102	105	3"	P
	82	10' 0"		102	105		F
	83	7'	111	112	115		F
	84	10' 0"					F
		10' 0"					P

REMARKS _____
 SANITARIAN Kenn. Brown BACKHOE Hill OTHERS _____
 TEST HOLES USED IN SDA _____ AVG. PERC TIME _____ SQ. FT/BR _____
 TRENCH WIDTH _____ INLET DEPTH _____ MAX. BOT DEPTH _____ EFFECTIVE SW _____