

Maura J. Rossman, M.D., Health Officer

RECEIPT DATE: 4-5-21 **ONSITE SEWAGE DISPOSAL SYSTEM** P 28836
 APPROVAL DATE: 4/21/21 **PERMIT: CONSTRUCTION** A _____
 PROPERTY ADDRESS: 3200 HUNTERSWORTH, GLENWOOD, MD 21738
 SUBDIVISION: THE WOODS OF WELLINGTON LOT: 6 TAX ID: 04-366514
 CONTRACTOR: Cardand Brian Se LLC EMAIL: _____
 CONTRACTOR ADDRESS: 12871 Highland Road, Highland, MD 20771 PHONE: 301-854-2161
 PROPERTY OWNER: MICHAEL L & ELLEN C BUCH EMAIL: _____
 OWNER ADDRESS: 250 GIBRALTER ROAD, HORSHAM, PA 19044 PHONE: (240)375-6294
 SEPTIC TANK SIZE (GALLONS): 2000 TANK MANUFACTURER: TBD
 PUMP MODEL: n.a. PUMP SIZE n.a. PUMP TANK CAPACITY: n.a.

DISTRIBUTION SYSTEM: GRAVITY PRESSURE DOSED BEDROOMS: 6 APPLICATION RATE: 1.2

TRENCHES:	LINEAR FEET REQUIRED: <u>112</u>	INLET DEPTH: <u>2.5</u>
	TRENCH WIDTH: <u>3</u>	MAXIMUM BOTTOM DEPTH: <u>7.5</u>
	MINIMUM SPACE BETWEEN TRENCHES: <u>10</u>	EFFECTIVE AREA BEGINNING DEPTH: <u>4.0</u>
LOCATION:	PER APPROVED SITE PLAN. SEWAGE DISPOSAL AREA AND TANK LOCATIONS MUST BE STAKED BY LICENSED SURVEYOR PRIOR TO PRE-CONSTRUCTION INSPECTION.	
NOTES:	INSTALL 3 CLEANOUTS IN SHC, AS ILLUSTRATED. EXISTING SEPTIC TANK AND DISTRIBUTION BOX MUST BE PUMPED DRY AND PROPERLY ABANDONED FOR FINAL APPROVAL OF THIS SEPTIC SYSTEM INSTALLATION.	


ISSUED BY: R BRICKER ISSUE DATE: 4-8-21 EXPIRATION DATE: 4-5-22

- NOTE: CONTRACTOR MUST SCHEDULE A PRE-CONSTRUCTION INSPECTION PRIOR TO BEGINNING ANY INSTALLATION
- NOTE: CONTRACTOR MUST SCHEDULE AN INSPECTION AND GAIN APPROVAL OF ALL COMPONENTS PRIOR TO COVERING
- NOTE: STONE MUST BE APPROVED BY HEALTH DEPARTMENT AND GRAVEL TICKET MUST BE AVAILABLE FOR REVIEW.
- NOTE: WATERTIGHT TANKS REQUIRED
- NOTE: ALL PARTS OF SEPTIC SYSTEM SHALL BE AT LEAST 100 FEET DOWNGRADIENT FROM ANY WATER WELL
- NOTE: MANHOLE RISERS REQUIRED ON ALL SEPTIC TANKS AND PUMP CHAMBERS
- NOTE: AN ELECTRICAL PERMIT IS REQUIRED FOR INSTALLATION OF ANY ELECTRICAL COMPONENTS OF THE SYSTEM
 ELECTRICAL PERMIT ISSUED E n.a.
- NOTE: MDE RECOMMENDS SEPTIC TANKS, BAT, AND OTHER PRETREATMENT UNITS BE PUMPED AT A FREQUENCY ADEQUATE TO ENSURE THAT SOLIDS ARE NOT DISCHARGED TO THE DISPOSAL AREA

**NEITHER THE HOWARD COUNTY COUNCIL NOR THE HEALTH DEPARTMENT IS RESPONSIBLE FOR THE SUCCESSFUL OPERATION OF ANY SYSTEM.
 PERMITTEE RESPONSIBLE FOR OBTAINING FINAL APPROVAL ON THIS PERMIT.
 CALL 410-313-1771 TO SCHEDULE INSPECTIONS.**

NOT TO SCALE 1" ≈ 30'

SDA

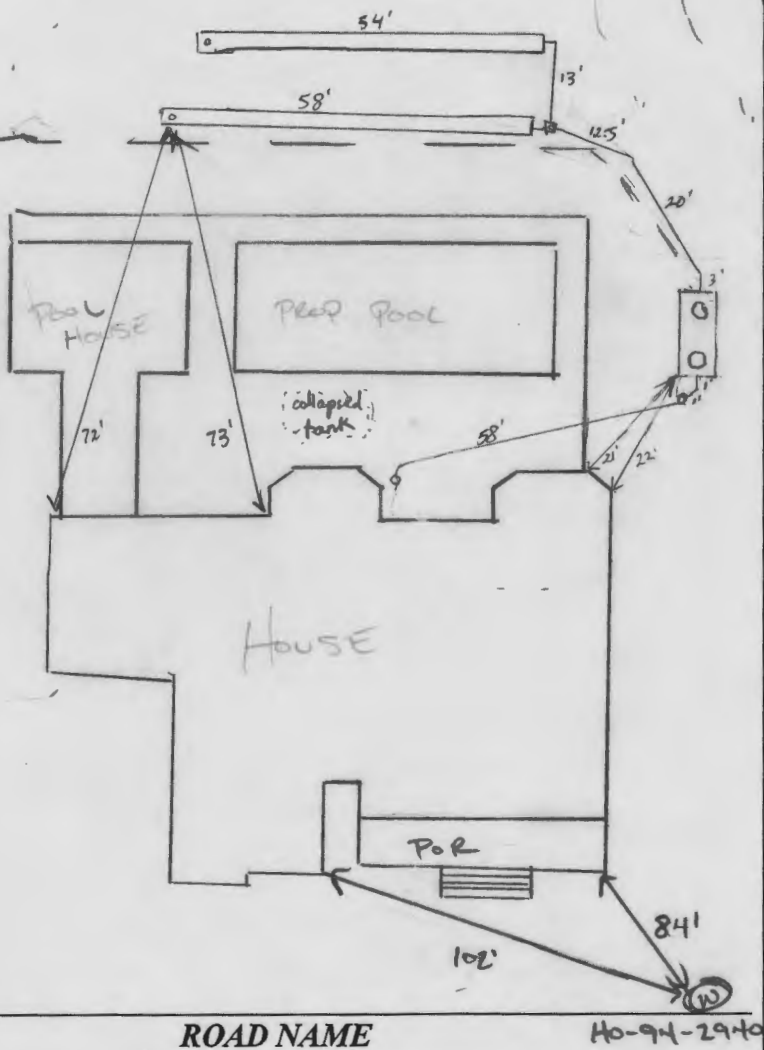

TRENCH/DRAINFIELD DATA

WIDTH	INLET	BOTTOM
8'	2.5'	7.5'
NUMBER OF TRENCHES		2
TOTAL LENGTH		112'
ABSORPTION AREA		336 sq ft + sidewalk
DISTRIBUTION BOX LEVEL		yes
DISTRIBUTION BOX BAFFLE		yes
DISTRIBUTION BOX PORT		yes

SEPTIC TANK DATA

SEPTIC TANK I LEVEL	yes
MANUFACTURER	Baystar
CAPACITY	2000 GAL
SEAM LOC	top
TANK LID DEPTH	1.5'
BAFFLES	inlet + outlet
BAFFLE FILTER	-
MANHOLE LOC	inlet + outlet
6" PORT LOC	-
WATERTIGHT TEST	-
SLOTTED	yes
DATE ON LID	4-5-21

PUMP/SEPTIC TANK LEVEL

MANUFACTURER	
CAPACITY	GAL
SEAM LOC	
TANK LID DEPTH	
BAFFLES	
BAFFLE FILTER	
MANHOLE LOC	
6" PORT LOC	
WATERTIGHT TEST	
SLOTTED	
DATE ON LID	

PRE-CONSTRUCTION:

04/12/21 TANK, SDA, TRENCHES STAKED. OK TO START ON TANK. CHECK TRENCH CONTOUR PRIOR TO START OF DRAINFIELD. (S)

INSTALLATION:

4/20/21 Tank set, d-box set, one trench complete. Re-visit for SL, d-box leveling and 2nd trench. Trenches were laid out on contour by contractor, used laser level today to verify that the trenches were level and on contour. (S)
 4/21/21 Lower trench constructed. D-box leveled, SL tied into old SL, old tank collapsed. (S)

FINAL INSPECTOR

Susan Thomas

DATE OF APPROVAL

4/21/21

LAYOUT 12/16/2002 11-11:30 INSP 4 _____
INSP 2 12/17/02 12-1 INSP 5 _____
INSP 3 12/18/02 10:30AM INSP 6 _____

ISSUE DATE: 10/23/2002

APPROVAL DATE: 12/18/02

**PERMIT
INDEXED**

04-366514

P 517 970

A 511939-E

**ON-SITE SEWAGE DISPOSAL SYSTEM
HOWARD COUNTY HEALTH DEPARTMENT
BUREAU OF ENVIRONMENTAL HEALTH**

K & K Excavating IS PERMITTED TO INSTALL ALTER

ADDRESS: 14960 Frederick Road, Woodbine PHONE NUMBER: 410-442-1336

SUBDIVISION: Wellington III LOT NUMBER: 6

ADDRESS: 3200 Huntersworth Way PROPERTY OWNER: Selfridge Builders

SEPTIC TANK CAPACITY (GALLONS): 1250 OUTLET BAFFLE FILTER REQUIRED

PUMP CHAMBER CAPACITY (GALLONS): N/A COMPARTMENTED TANK REQUIRED

NUMBER OF BEDROOMS: 4

SQUARE FEET PER BEDROOM: 180

LINEAR FEET OF TRENCH REQUIRED: 240 HOUSE SERVED BY PUBLIC WATER

TRENCHES:	Trench to be 3.0 feet wide. Inlet 4.0 feet below original grade. Bottom maximum depth 6.0 feet below original grade. Effective area begins at 4.0 feet below original grade. 2.0 feet of stone below distribution pipe.
LOCATION:	Start the first trench 120 feet from rear lot line and 80 feet from the leftside line as seen when facing the lot from Hunterworth Way. Place second trench parallel to and 9 feet from (edge to edge) the first trench. All trenches to be placed on a level grade for even distribution of effluent.
NOTES:	

PLANS APPROVED: Frank Skinner *OK 10/1/02 (SC)* DATE: 9/10/2002

NOTES: PERMIT VOID AFTER 2 YEARS
CONTRACTOR IS RESPONSIBLE FOR SCHEDULING A PRE-CONSTRUCTION INSPECTION FOR ALL INSTALLATIONS
WATERTIGHT SEPTIC TANKS REQUIRED
ALL PARTS OF SEPTIC SYSTEM SHALL BE 100 FEET FROM ANY WATER WELL UNLESS SPECIFICALLY AUTHORIZED
MANHOLE RISERS REQUIRED ON ALL SEPTIC TANKS AND PUMP CHAMBERS UNLESS SPECIFICALLY AUTHORIZED
CONTRACTOR RESPONSIBLE FOR COMPLIANCE WITH APPLICABLE REGULATIONS, GUIDELINES AND THE TERMS OF THIS PERMIT

**NEITHER THE HOWARD COUNTY COUNCIL NOR THE HEALTH DEPARTMENT IS
RESPONSIBLE FOR THE SUCCESSFUL OPERATION OF ANY SYSTEM
PERMITTEE RESPONSIBLE FOR OBTAINING FINAL APPROVAL ON THIS PERMIT
ALL 410-313-2640 FOR INSPECTION OF SEPTIC SYSTEM**

**BUILDING PERMIT SIGNED
AND RETURNED**

7-18-03-800143046-DECK

A511939-E

Mr. Jeff Williams
Howard County Health Department
Bureau of Environment Health
7178 Columbia Gateway Drive
Columbia, Maryland 21046-4544

February 16, 2021


Dear Mr. Williams,

As the owner of The Woods of Wellington Lot 6 (3200 Huntersworth), I am requesting a variance in the setback of a pool and raised screen porch from 20 feet to 15 feet. We are proposing to install a pool and patio/raised screen porch behind the existing house. The construction will require the abandonment of the existing installed septic system, a revision of the Sewage Disposal Area and the installation of a new initial septic system. A revised Percolation Certification Plan has been submitted to the Health Department with a revised 10,000 SF Sewage Disposal Area. In addition, a OSDS Plan has been submitted to the Health Department that shows an Initial System and two Replacement Systems.

I believe the revised 10,000 SF Sewage Disposal Area and three septic systems will meet the Health Department requirements. However, the distance between the pool and the Sewage Disposal Area will be 15 feet, a reduction of 5 feet from the 20 ft setback. We request approval of this variance in the setback requirement.

Thank you for your consideration.

Very truly yours,

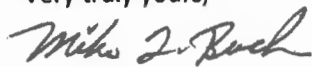

Mike L. Buch

approved
Jaw
4/15/21

LOT 6
49,905 s.f.

25' R. F2G
30' B.R.L.

85.34'

P 10A
T1-2=56'
210' REPLACEMENT
T3-1=56'

SDA
10,000 s.f.
P 16H

INITIAL T1-2=56'
INITIAL T1-1=56'

15' REPLACEMENT
T1-1=56'
T1-2=56'

LC
THE WOODS
PLAT #

INSTALLED
INITIAL SYSTEM
TO BE
ABANDONED



PROPOSED
PATIO W/RAISED
SCREEN PORCH

EX. SEPTIC TANK &
DIST. BOX
(TO BE REMOVED)

EX. FRAME
DECK & STEPS
(TO BE REMOVED)

EX. 2-1/2 STY.
BRICK & FRAME
HOUSE W/BSMT.
(#3200)
F.F. 534.5
B. 524.5

ASPHALT DRIVEWAY

COV. CONC. POR.

5' CONC. WALK

GgB

ALT WELL

6' PUBLIC DRAINAGE
EASEMENT

ALT WELL

R=370.00'

L=193.14'

GgB

EX. WELL
HO-94-2940

10' PUBLIC STORM DRAIN &
UTILITY ESMT.

100' R (TYP.)

MaC


EX. PAVING

HUNTERSWORTH
(40' WIDE)

GgB

S 85°53'26" W
36.18'

S 40°53'2

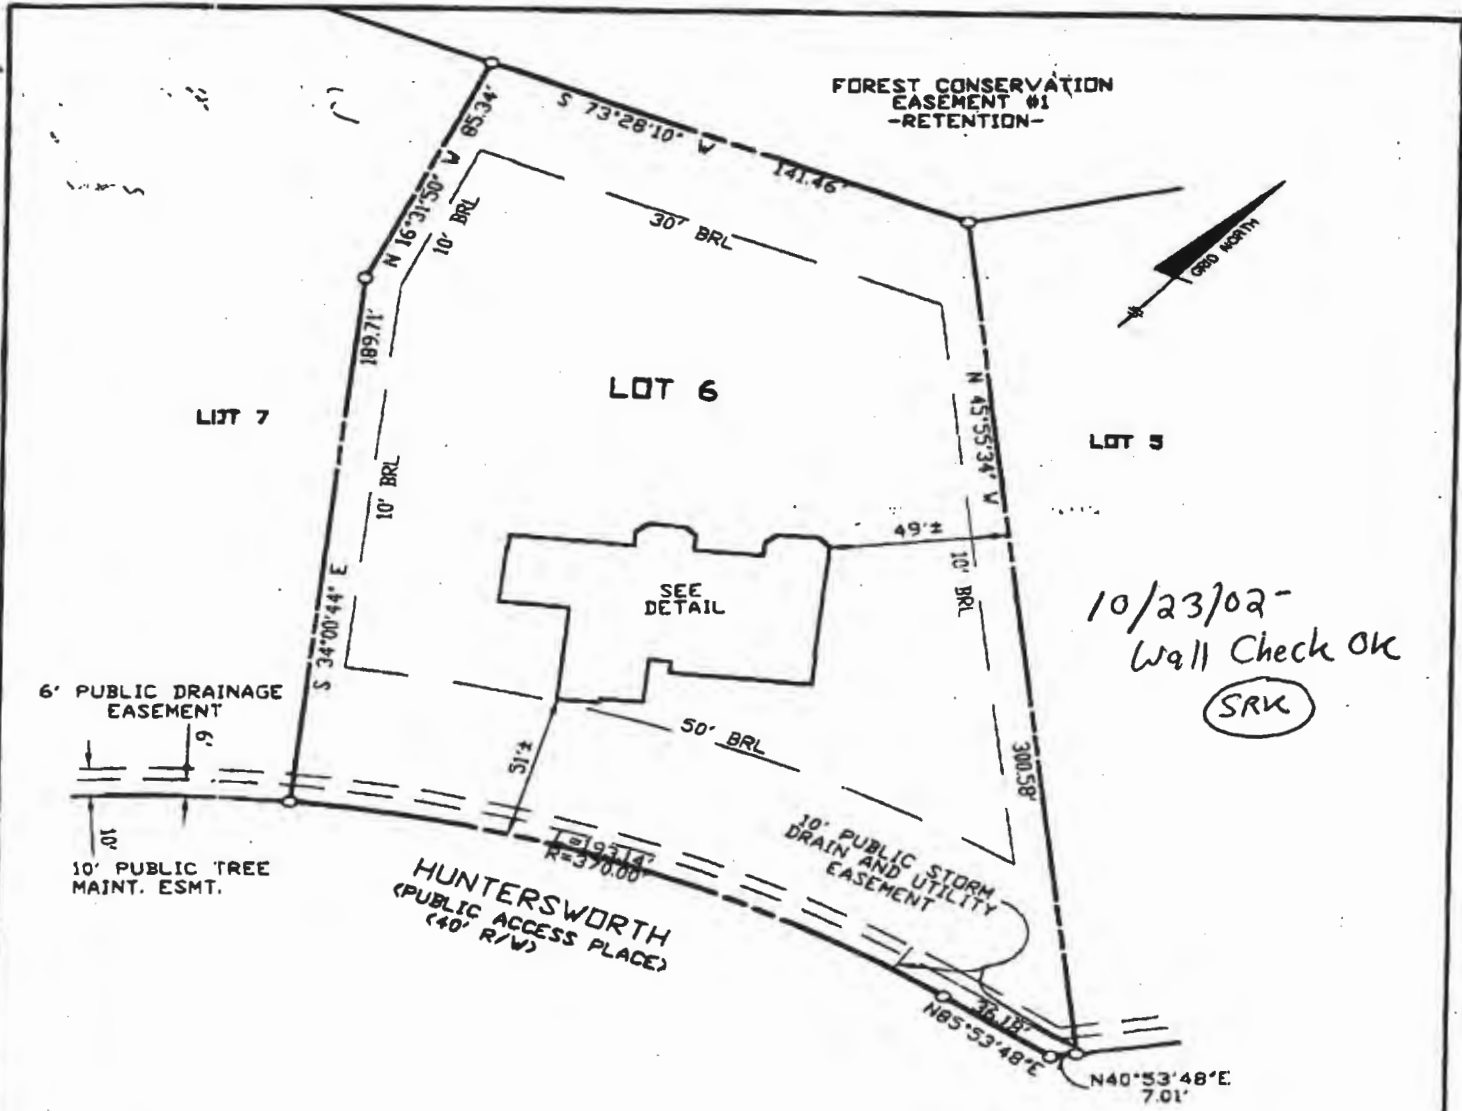

TOP OF FOUNDATION WALL ELEVATION = 534.0'
 OFFSET DIMENSIONS TO PROPERTY LINES ARE ±1'

SURVEYOR'S CERTIFICATE


I HEREBY CERTIFY TO THE BEST OF MY PROFESSIONAL KNOWLEDGE, INFORMATION AND BELIEF, THAT THE DIMENSIONS OF THE BUILDING WALLS SHOWN HEREON ARE CORRECT; THAT THEY ARE BASED ON A FIELD RUN SURVEY PERFORMED BY BENCHMARK ENGINEERING, INC. ON 10/14/02; AND THAT THE PROPERTY OUTLINE SHOWN HEREON IS BASED ON THE PLAT PREPARED BY BENCHMARK ENGINEERING, INC. ENTITLED "THE WOODS OF WELLINGTON LOTS 1-24 AND NON-BUILDABLE PRESERVATION PARCELS "A" THRU "D", AND RECORDED AMONG THE LAND RECORDS OF HOWARD COUNTY AS PLAT No. 15288

David M. Harris
 DAVID M. HARRIS
 REGISTERED PROFESSIONAL LAND SURVEYOR

MD REG. No. 10978
 FOR BENCHMARK ENGINEERING, INC.
 MD REG. No. 351
 RECORD PLAT No. 15288
 FEMA FIRM No. 240044 D014 B
 ZONE: C
 DATED: 12/04/88

BENCHMARK ENGINEERING, INC.

4040 BALTIMORE NATIONAL PIKE # 118
 BILLYOTT CITY, MARYLAND 21043
 PHONE: 410-485-8108 & 410-485-4844
 WWW: LHM@BENCHMARK.COM

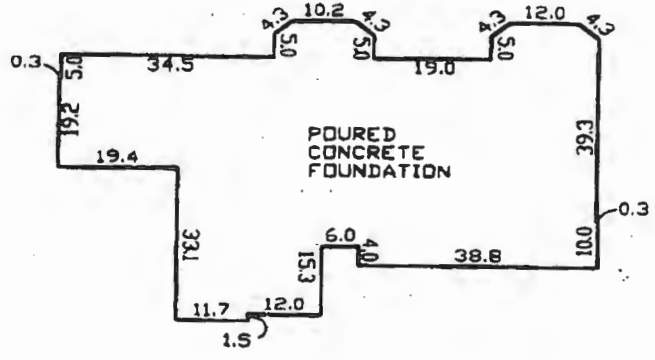


FOUNDATION DETAIL
 SCALE: 1" = 30'


WALL CHECK
THE WOODS OF WELLINGTON
LOTS 1-24
LOT No. 6

3200 HUNTERS WORTH
 4TH ELECTION DISTRICT
 HOWARD COUNTY, MARYLAND

SCALE: 1" = 50' DATE: 10/14/02
 Oct. 22, 2002 - 2:13PM - BENCHMARK ENG.

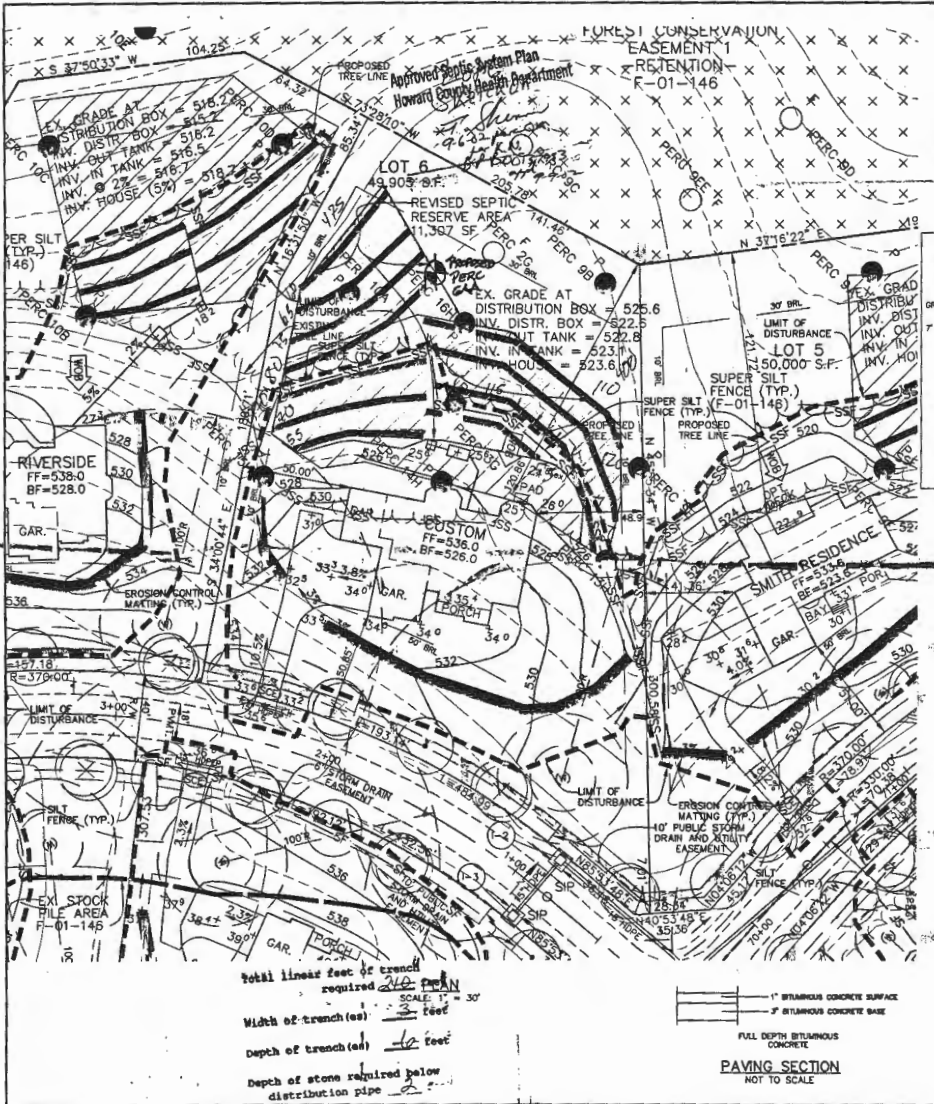


- NOTES:**
1. THE LOT SHOWN HEREON WAS RECORDED BY PLAT NUMBER 15248, REFER TO THE RECORD PLAT FOR LOT DIMENSIONS, LOT AREA, ALL EASEMENTS AND BUILDING RESTRICTIONS.
 2. THIS AREA DESIGNATES A PRIVATE SEWERAGE EASEMENT OF 10,000 SQUARE FEET AS REQUIRED BY THE STATE DEPARTMENT OF THE ENVIRONMENT FOR INDIVIDUAL SEWERAGE DISPOSAL. IMPROVEMENTS OF ANY NATURE IN THIS AREA IS RESTRICTED UNLESS PUBLIC SEWER IS AVAILABLE. THIS EASEMENT SHALL BECOME NULL AND VOID UPON CONNECTION TO A PUBLIC SEWERAGE SYSTEM. THE COUNTY HEALTH OFFICER SHALL HAVE THE AUTHORITY TO GRANT VARIANCES FOR ENCROACHMENT INTO THE PRIVATE SEWERAGE EASEMENT. RECONSTRUCTION OF A MODIFIED SEWERAGE EASEMENT PLAT SHALL NOT BE NECESSARY.
 3. SEDIMENT AND EROSION CONTROLS WERE APPROVED BY HOWARD SOIL CONSERVATION DISTRICT UNDER CP-02-48 AND MODIFIED FOR THIS SPECIFIC HOUSE.
 4. TOPOGRAPHY SHOWN HEREON IS TAKEN FROM THE APPROVED ROAD CONSTRUCTION PLANS. EXACT LENGTH OF SEPTIC TRENCHES ARE TO BE DETERMINED BY THE HEALTH DEPARTMENT AT THE TIME OF TRENCH LAYOUT AND INSPECTION.
 5. SPILL FROM THE TRENCHING OF THE SEPTIC AREA IS TO BE PLACED ON THE UPHILL SIDE OF THE EXCAVATION FOR EACH INDIVIDUAL LOT.
 6. ALL SEDIMENT AND EROSION CONTROL FEATURES USED ON THIS SITE SHALL COMPLY WITH 1994 HANDBOOK STANDARDS AND SPECIFICATIONS FOR SOIL EROSION AND SEDIMENT CONTROL.
 7. ALL STORMWATER MANAGEMENT FEATURES USED ON THIS SITE MUST COMPLY WITH THE APPROVED ROAD CONSTRUCTION PLANS.
 8. ALL DRAINAGE AND STORMWATER MANAGEMENT FEATURES USED ON THIS SITE MUST COMPLY WITH THE APPROVED ROAD CONSTRUCTION PLANS (P-01-146).

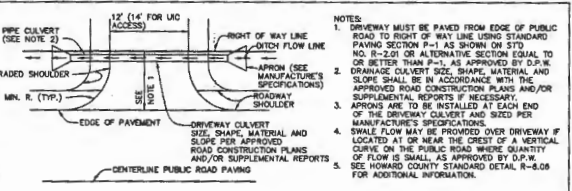

DRIVEWAY CULVERT NOTES AND DETAIL NOT TO SCALE

- LEGEND**
- LIMIT OF DISTURBANCE
 - - - EX. SILT FENCE
 - - - PROP. SILT FENCE
 - - - EX. SUPER SILT FENCE
 - - - PROP. SUPER SILT FENCE
 - - - EXISTING ONE WAY
 - - - PROP. EARTH DIRT
 - - - STABILIZED CONSTRUCTION ENTRANCE
 - - - EXISTING CONTOUR
 - - - PROPOSED CONTOUR
 - - - EROSION CONTROL MATTING
 - - - PAVING ARE TEST
 - - - FAILING ARE TEST
 - - - PROPOSED TEST
- TO PERC 6A
 TO PERC 2A
 TO PERC 6A




total linear feet of trench required 416 FEET
 SCALE: 1" = 30'
 Width of trench (as) 3 feet
 Depth of trench (as) 4 feet
 Depth of stone required below distribution pipe

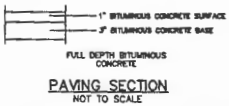

NO.	DATE	REVISION

BENCHMARK
 DESIGNERS • LAND SURVEYORS • PLANNERS
BENCHMARK ENGINEERING, INC.
 6840 BALTIMORE NATIONAL PIKE & SUITE 418
 ELLETTT CITY, MARYLAND 21043
 PHONE: 410-485-2108 • FAX: 410-485-6844
 EMAIL: benchmark@bce.com

OWNER/BUILDER: JAMES H. SELFRIDGE BUILDERS 14045 GARED DRIVE GLENWOOD, MD 21738 PHONE: 410-531-8930 FAX: 410-531-8939	PROJECT: THE WOODS OF WELLINGTON LOT 6 LOCATION: 3200 HUNTERSWOOD GLENWOOD, MD 21738 TAX MAP 14 - BLOCK 20 - P/O PERC 6A 4th ELECTION DISTRICT OF HOWARD COUNTY, MARYLAND TITLE: PERC TESTING PLAN HOUSE TYPE: CUSTOM HOUSE TYPE DATE: MAY 2002 PROJECT NO.: 1430 SCALE: 1" = 30' DRAWING 1 OF 1
--	--

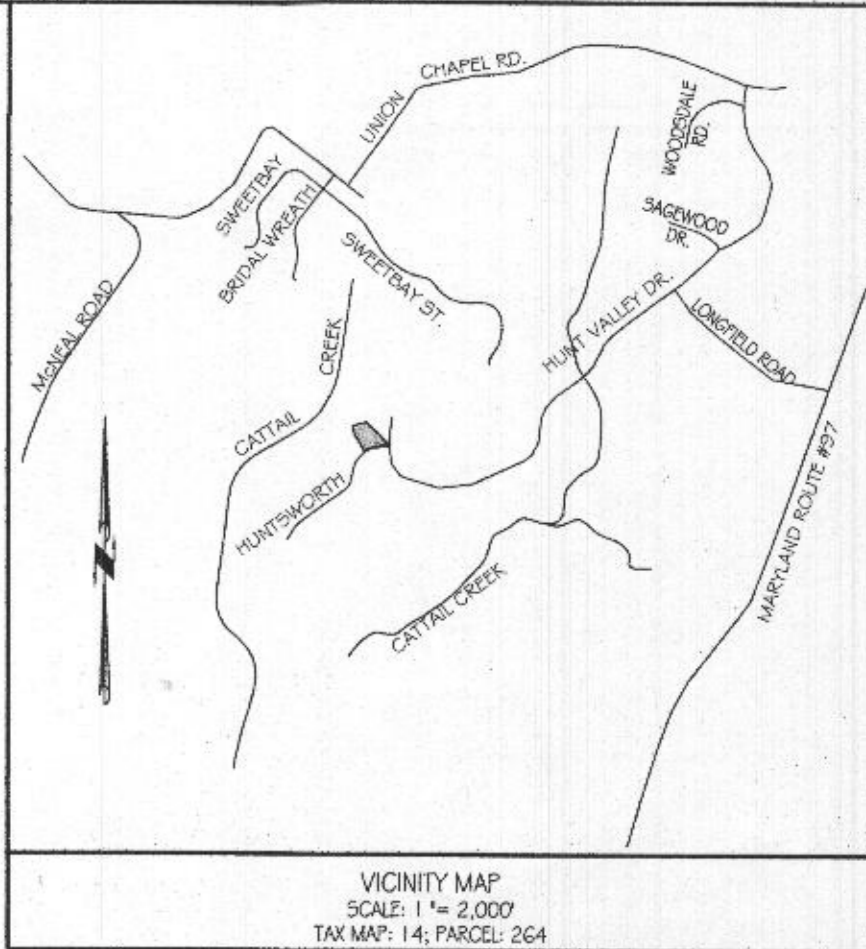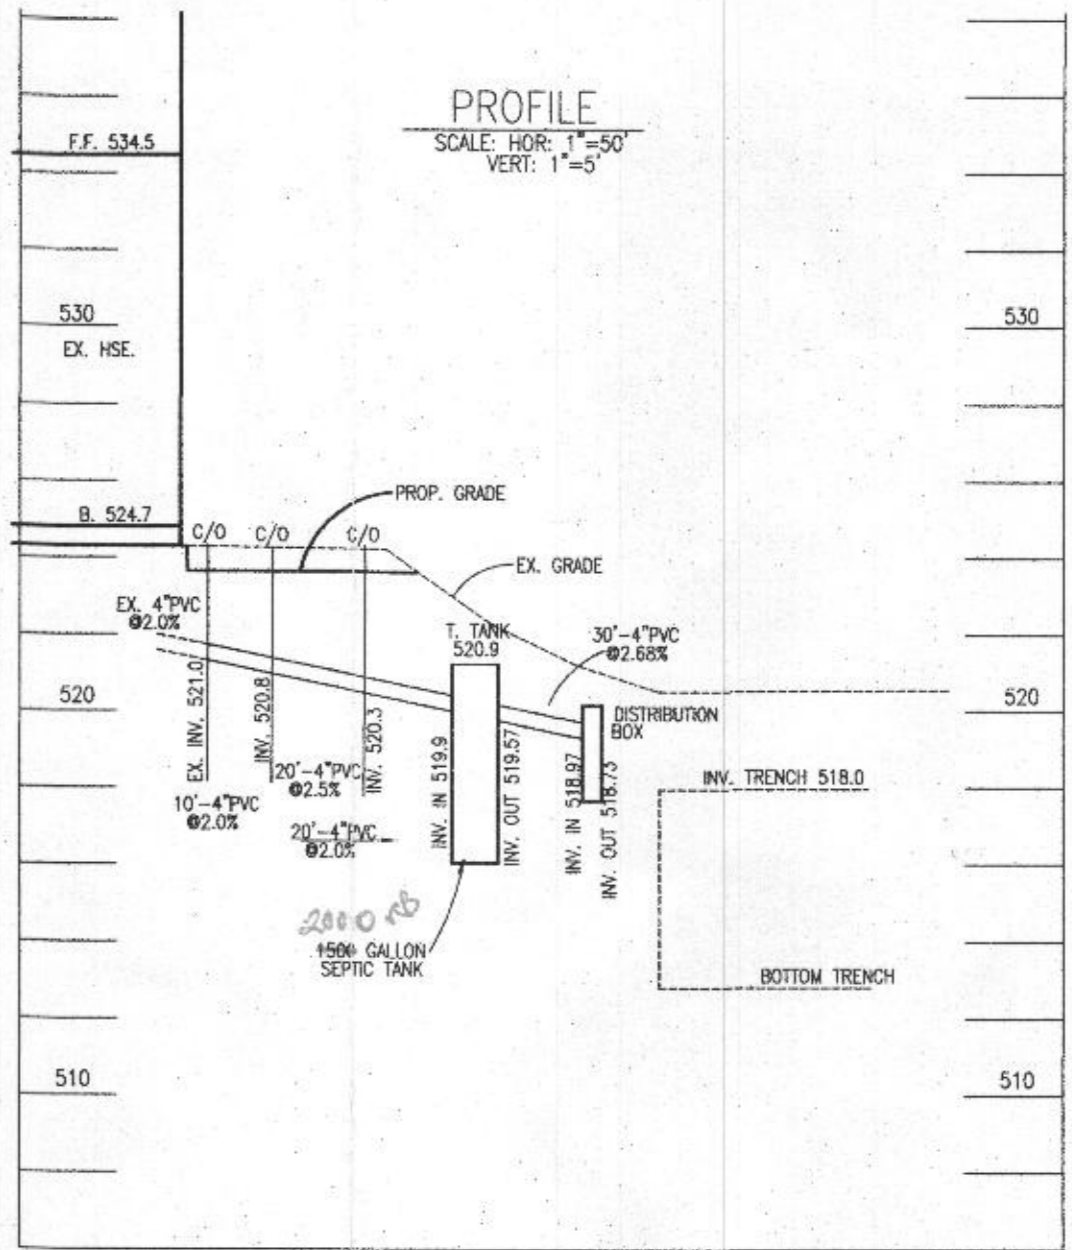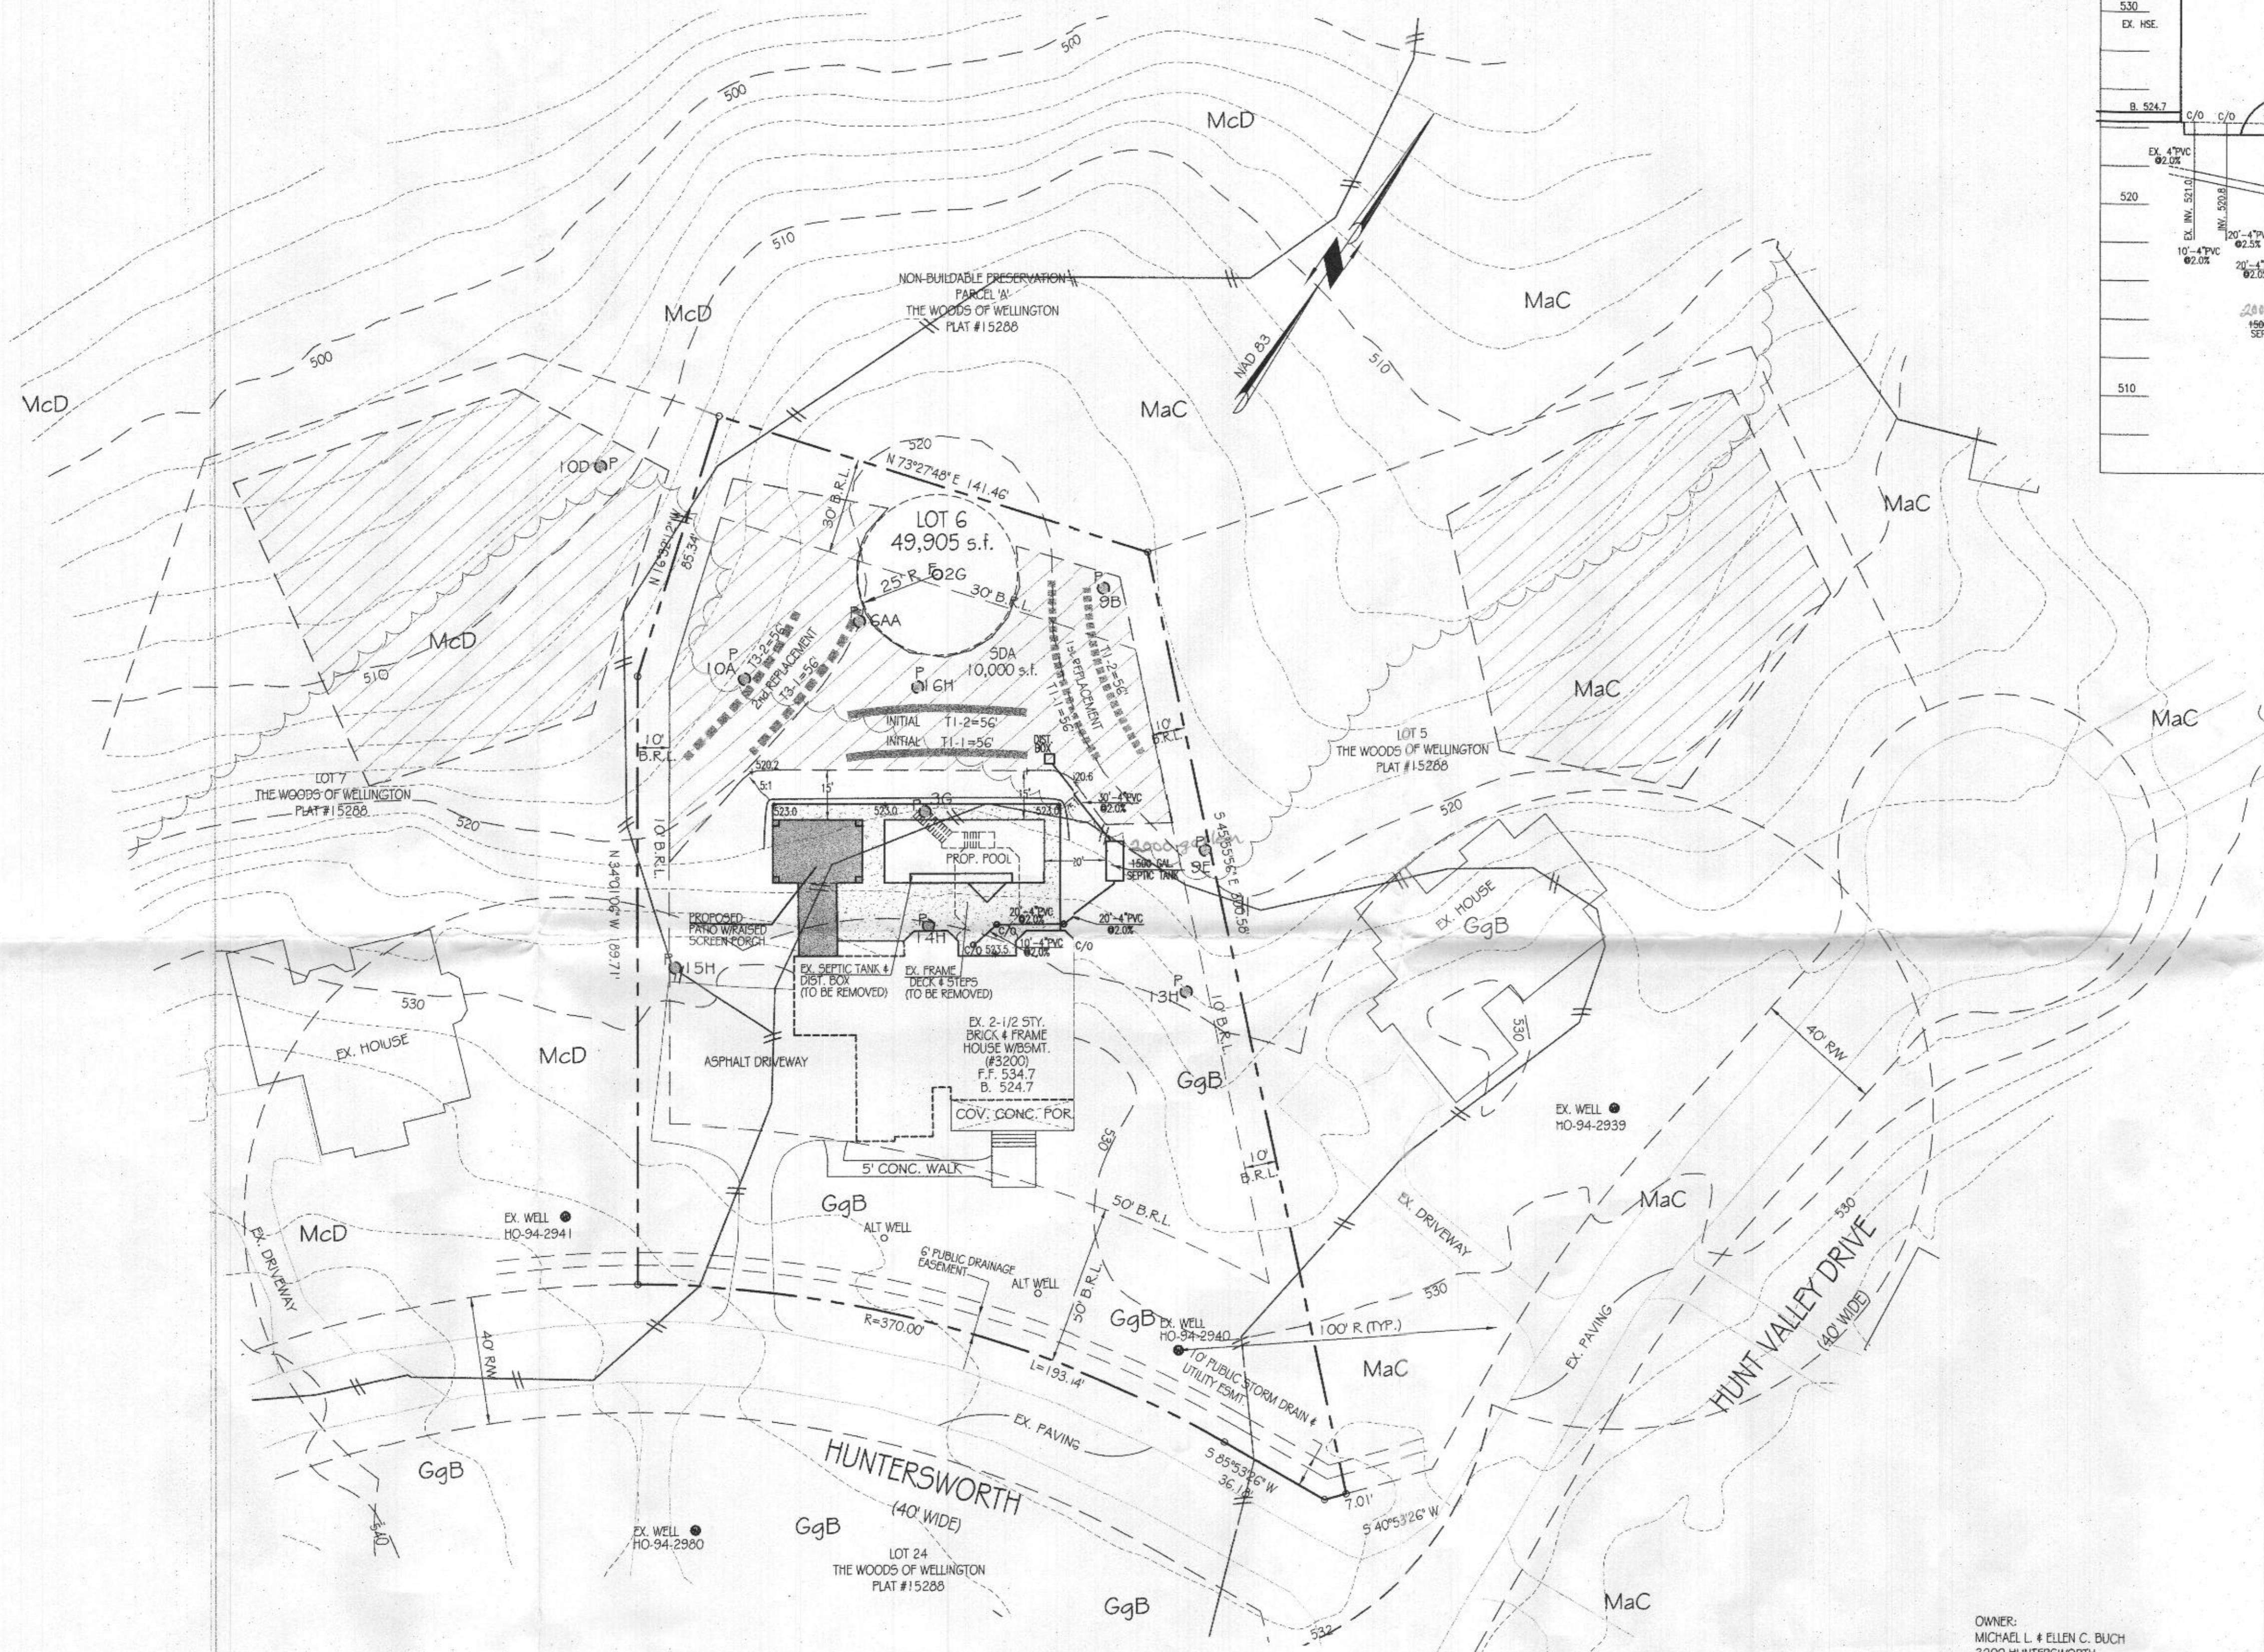

SEPTIC SYSTEM TRENCH DESIGN


INITIAL NUMBER OF BEDROOMS = 6
 APPLICATION RATE = 1.2 GPD / sq.ft.
 DESIGN FLOW: 150 GPD X 6 BEDROOMS = 900 GPD
 900 GPD / 1.2 GPD/sq.ft. = 750 sq.ft.
 750 sq.ft. / 3 ft. WIDE TRENCH = 250 LF TRENCH
 250 LF TRENCH X 0.45 REDUCTION CREDIT = 112.5 LF TRENCH
 TRENCH T1-1 EX. GRD=520.5 - INV. TRENCH=518.0 - B. TRENCH=513.0
 TRENCH T1-2 EX. GRD=520.5 - INV. TRENCH=518.0 - B. TRENCH=513.0

1st REPLACEMENT
 APPLICATION RATE = 1.2 GPD / sq.ft.
 DESIGN FLOW: 150 GPD X 6 BEDROOMS = 900 GPD
 900 GPD / 1.2 GPD/sq.ft. = 750 sq.ft.
 750 sq.ft. / 3 ft. WIDE TRENCH = 250 LF TRENCH
 250 LF TRENCH X 0.45 REDUCTION CREDIT = 112.5 LF TRENCH
 TRENCH 2-1 EX. GRD=520.0 - INV. TRENCH=517.5 - B. TRENCH=512.0
 TRENCH 2-2 EX. GRD=519.2 - INV. TRENCH=516.7 - B. TRENCH=511.2

2nd REPLACEMENT
 APPLICATION RATE = 1.2 GPD / sq.ft.
 DESIGN FLOW: 150 GPD X 6 BEDROOMS = 900 GPD
 900 GPD / 1.2 GPD/sq.ft. = 750 sq.ft.
 750 sq.ft. / 3 ft. WIDE TRENCH = 250 LF TRENCH
 250 LF TRENCH X 0.45 REDUCTION CREDIT = 112.5 LF TRENCH
 TRENCH 3-1 EX. GRD=519.8 - INV. TRENCH=517.3 - B. TRENCH=511.8
 TRENCH 3-2 EX. GRD=518.5 - INV. TRENCH=516.0 - B. TRENCH=510.5

- GENERAL NOTES:**
- TOPOGRAPHY & PLANIMETRIC FEATURES SHOWN HEREON TAKEN FROM COPYRIGHTED GIS DATA FROM HOWARD COUNTY, SUPPLEMENTED WITH FIELD LOCATIONS BY VANMAR ASSOCIATES, INC. CONTOUR INTERVAL IS 2 FEET. VERTICAL DATUM IS NAVD83.
 - THE EXISTING WELLS SHOWN ON THIS PLAN HAVE BEEN FIELD LOCATED BY VANMAR ASSOCIATES OR TAGER FROM AVAILABLE RECORDS AND ACCURATELY SHOWN.
 - ZONING DISTRICT: RC-DEO
 - LIMIT OF DISTURBANCE (LOD) = 4,750 s.f.
 - THERE ARE NO STREAMS, PONDS, FLOODPLAINS OR WETLANDS ON THIS LOT.

- SITE PLAN NOTES:**
- ANY CHANGE TO THE LOCATIONS OR DEPTHS TO ANY COMPONENTS MUST BE APPROVED BY THE ENGINEER AND THE HOWARD COUNTY HEALTH DEPARTMENT PRIOR TO INSTALLATION. A REVISED SITE PLAN MAY BE REQUIRED.
 - MAXIMUM COVER OVER THE TANK IS 3 FEET. GREATER DEPTH WILL REQUIRE A HEAVY LOAD BEARING TANK.
 - ELECTRICAL WORK FOR THE INSTALLATION MUST BE PERFORMED BY A LICENSED ELECTRICIAN.
 - THE WELL (TAG #HO-94-2940) HAS BEEN FIELD LOCATED AND IS ACCURATELY SHOWN.
 - ALL WELLS AND SEPTIC SYSTEMS LOCATED WITHIN 100' OF THE PROPERTY BOUNDARIES AND 200' DOWN GRADIENT OF ANY WELLS AND OR SEPTIC SYSTEMS HAVE BEEN SHOWN.

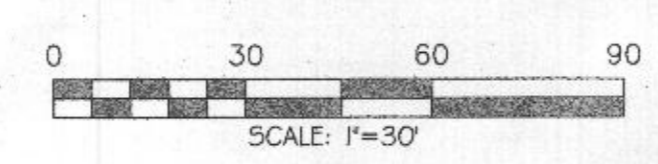


OWNER:
 MICHAEL L. & ELLEN C. BUCH
 3200 HUNTERS WORTH
 GLENWOOD, MARYLAND 21736
 (240) 375 - 6294

I HEREBY CERTIFY THAT THESE DOCUMENTS WERE PREPARED BY ME OR UNDER MY RESPONSIBLE CHARGE, AND THAT I AM A DULY LICENSED PROFESSIONAL ENGINEER UNDER THE LAWS OF THE STATE OF MARYLAND, LICENSE NO. 16417, EXPIRATION DATE SEPTEMBER 10, 2021, IN ACCORDANCE WITH COMAR 09.13.06.12
 I HEREBY CERTIFY THESE ARE NO WELLS OR SEPTIC SYSTEMS WITHIN 100 FEET OF THE PROPERTY BOUNDARY UNLESS OTHERWISE SHOWN HEREON. I FURTHER CERTIFY THAT THE PRESCRIPTION TEST HOLES HAVE BEEN FIELD LOCATED IF EXISTING AND ACCURATELY STAKED IF PROPOSED AND SHOWN HEREON.

RONALD E. THOMPSON, PROF. ENGINEER DATE
 MARYLAND REGISTRATION NO. 16417

DATE	REVISIONS
01/04/21	SEPTIC AREA
01/15/21	HD COMMENTS

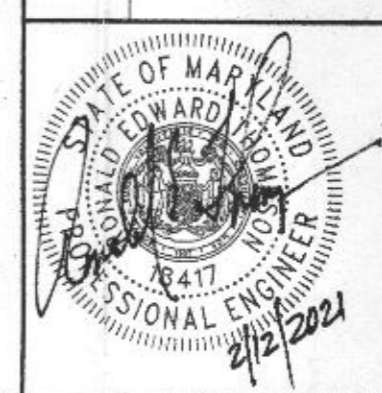

Approved Septic System Plan
 Howard County Health Department
 2000-gallon Septic Tank
 to Gravity Drainfield
 for existing 6-bedroom SFD
R. Buch 8/1/2021
 Signature Date
 abandon existing Septic Tank & Distribution Box

ON SITE SEWAGE DISPOSAL SYSTEM DESIGN PLAN
LOT 6
THE WOODS OF WELLINGTON

PLAT NO. 15288
 3200 HUNTERS WORTH
 ELECTION DISTRICT No. 4
 HOWARD COUNTY, MARYLAND
 SCALE: 1" = 30' NOVEMBER, 2020



VANMAR ASSOCIATES, INC.
 Engineers Surveyors Planners
 310 South Main Street Mount Airy, Maryland 21771
 (301) 829-2890 (301) 831-5015 (410) 549-2751
 Fax (301) 831-5603 ©Copyright, Latest Date Shown

APPROVED: FOR PRIVATE WATER AND PRIVATE SEWERAGE SYSTEMS.
 HOWARD COUNTY HEALTH DEPARTMENT
 HOWARD COUNTY HEALTH OFFICER DATE