

Save Reset Cancel Help

Record Detail * (This section is required.)

Permit Type	Permit Number	Opened Date
Building/Residential/Misc/Pool Spa	B21001637	05/11/2021
Description of Work		
SFD/ INSTALL 150X 20 IN GROUND POOL 3'6" to 6' DEPTH, W/ FENCE, FILLED BY TRUCK.		

check spelling

Address * (This section is required.)

Search Reset Clear Get Parcel & Owner

Street #	Street Name	Street Type	
1013	HIGH STEPPER	TRL	
Unit Type	Unit #	X Coordinate	Y Coordinate
--Select--		-76.93992	39.34648
City	State	Zip Code	Primary
SYKESVILLE	MD	21784	Yes

OK 5/13/2021

Parcel * (This section is required.)

Search Reset Clear Get Address & Owner

GIS ID *	Parcel	Parcel Area	Land Value	Improved Value	Exemption Value	Plan Area
11059598	66	0	0	0	0	RURAL

Legal Description

check spelling

Block	Lot	Census Tract	Council Dist	Inspection Dist	Supervisor Dist	Map #	DAP Zone
	3	603000	5				
Plan Area	State Tax Id	Subdivision Name					
		Walker Meadows					
Section	Area	Tax Map					
		9					
Grid	Zoning District	ADC Map					
9-6	RR-DEO	4693-K5					
SDP No.	Final Plan No.	WP File No.					
	ECP-15-078						
Record Plat No.	WS Contract No.	FDP No.	Primary				
24974-2497			Yes				
Owner Occupied	Year Built	Historic District					
<input type="radio"/> Yes <input type="radio"/> No		<input type="radio"/> Yes <input checked="" type="radio"/> No					
Historic District Registry No.	Stat Area	Flood Plain					
	3-01	<input type="radio"/> Yes <input checked="" type="radio"/> No					
Building No							

Owner * (This section is required.)

Search Reset Clear

Name *		
Ryan Corey		
Address Line 1		
1013 High Stepper Trail		
Address Line 2		
Address Line 3		
Mail City	Mail State	Mail Zip Code
Sykesville	MD	21784
Phone	Primary	
703-801-1975	Yes	
E-mail		
colleenandryan@gmail.com		
Cell Number	Fax Number	

--	--

Professionals (This section is not required.)

Search Reset Clear

License # *	Business Name		
08010025223	GALLOWAY POOL SERVICES INC		
License Type *	First Name	Middle Name	Last Name
MHIC Ind <input type="checkbox"/>	STEVEN	T	GALLOWAY
Primary	Address Line 1		
Yes <input type="checkbox"/>	11710 OLD FREDERICK ROAD		
	Address Line 2		
	City	State	ZIP Code
	MARRIOTSVILLE	MD	21104-0000
	Phone 1	Phone 2	Fax
	4104425005		4104425005
	E-mail		
	INFO@GALLOWAYPOOLSERVICE.COM		

Applicant (This section is not required.)

Search As Owner As Lic. Prof As Contact

Type *	First Name	MI	Last Name
Applicant <input type="checkbox"/>	STEVEN	T	GALLOWAY
Relationship	Full Name		
--Select-- <input type="checkbox"/>			
Primary	Organization Name		
Yes <input type="checkbox"/>	GALLOWAY POOL SERVICES INC		
	Street Address		
	11710 OLD FREDERICK ROAD		
	Address Line 2		
	City	State	Zip Code
	MARRIOTSVILLE	MD	21104 000
	Phone	Cell	Fax
	4435067043		4104425005
	E-mail *		
	INFO@GALLOWAYPOOLSERVICE.COM		

Addtl Info

Est Construction Cost *	Housing Units *	Number of Buildings *	Public Owned
48000	0	0	No <input type="checkbox"/>
Construction Type			
--Select-- <input type="checkbox"/>			

POOL INFORMATION

MISCELLANEOUS POOL INFORMATION

Capital Project-No Fee *	Capital Project Number	Fee Exempt *	Water Supply *	Sewage Disposal *
<input type="radio"/> Yes <input checked="" type="radio"/> No		<input type="radio"/> Yes <input checked="" type="radio"/> No	Private <input type="checkbox"/>	Public <input type="checkbox"/>
Existing Use	Type of Pool or Spa *	Electrical Permit Number	Expiration Date	
SFD <input type="checkbox"/>	In Ground Pool <input type="checkbox"/>		11/9/2021 <input type="checkbox"/>	

PAYMENT INFORMATION

Check 1	Payee 1	SAP Doc No	SAP Entered

Submit Cancel

No.	Revisions/Issues	Date

Galloway Pool Service
 11710 Old Frederick Road
 Marriottsville, MD 21104
 (P) 410-448-5005
 (F) 866-257-5898

Corey Residence
 1013 High Stepper Trail
 Sykesville, MD 21784

05/09/21
 1/32"=1'-0"
SITE PLAN


1 of 1



PRIVATE WELL & SEPTIC

POOL DATA	
Pool Dimensions:	22' X 17'
Perimeter:	74 LF
Surface Area:	285 SF
Depth:	3.6' - 6'

JOB NOTES	
Property Owner:	Ryan & Colleen Corey
Address:	1013 High Stepper Tr. Sykesville, MD 21784
Cell Phone:	*
Email:	*
Lot Number:	3
Subdivision Name:	0002: Walker Meadows
Tax Map:	0009
Grid & Parcel:	Grid 6 Parcel 66
Tax Account Number:	601561
Election District:	3
Zoning:	*
Utilities:	*

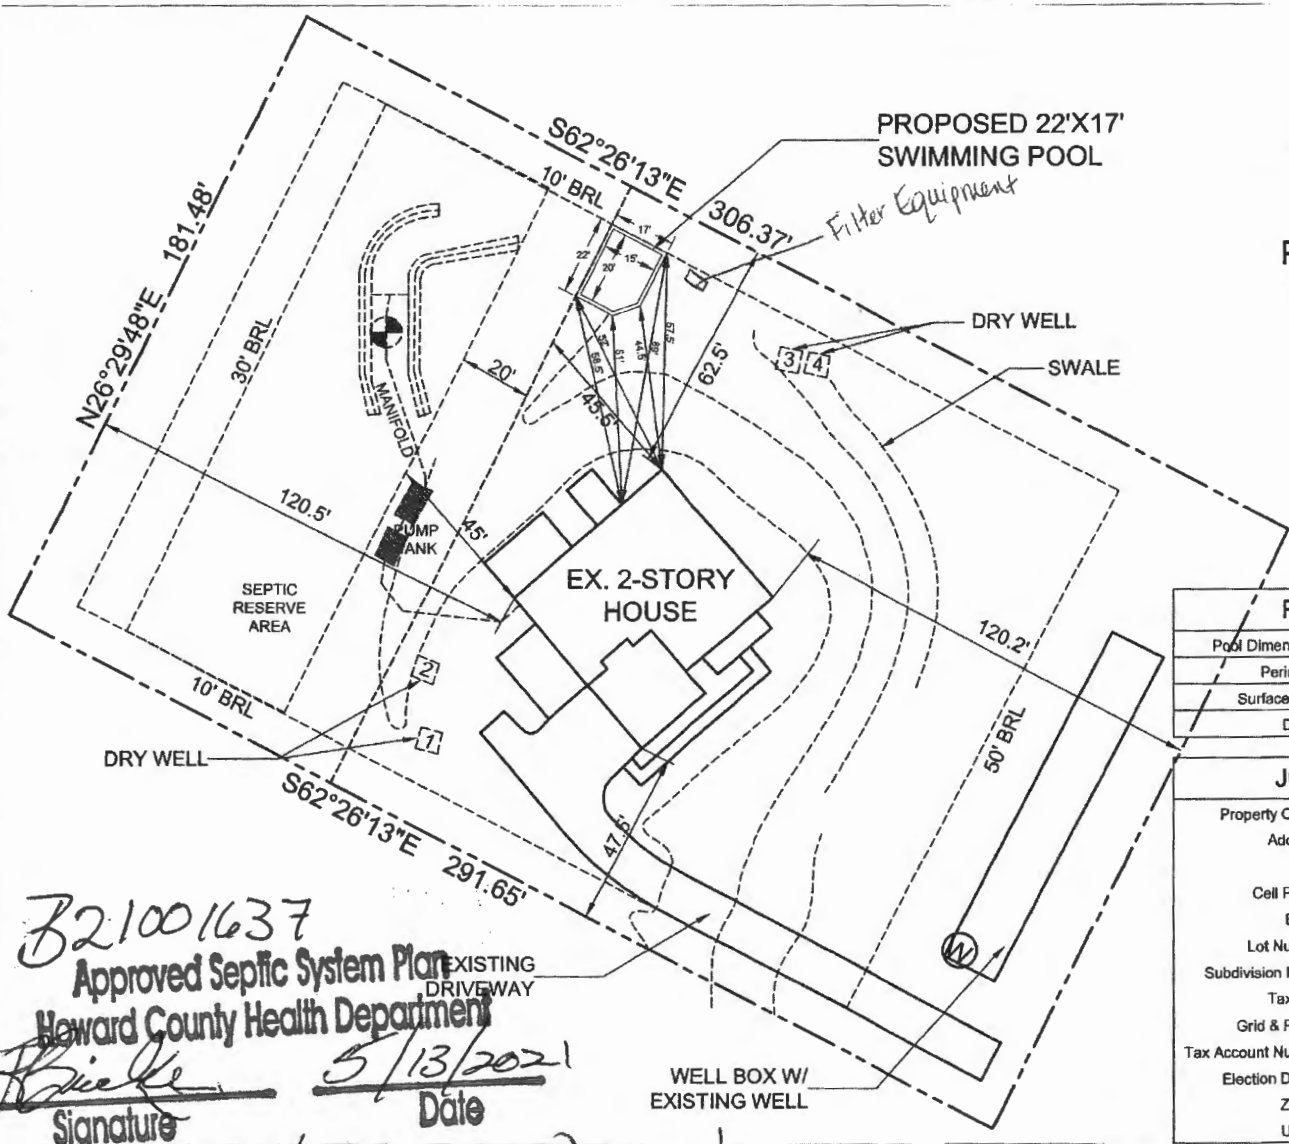

321001637
Approved Septic System Plan
Howard County Health Department
[Signature]
 Signature
 5/13/2021
 Date

22' x 17' inground pool.