
WATER WELL ABANDONMENT-SEALING REPORT FORM

SUBMIT COPIES OF COMPLETED FORM TO:

- * COUNTY ENVIRONMENTAL AGENCY (contact MDE, WMA if address needed)
- * WELL OWNER
- * MDE, WATER MANAGEMENT ADMINISTRATION, WELL PROGRAM

Approved
10/26/2021

DATE WELL ABANDONED: May 6, 2021 (month/day/year)

* PERMIT NUMBER OF ABANDONED WELL (if any)

HO - 73 - 1543

* PERMIT NUMBER OF REPLACEMENT WELL:

* PERSON ABANDONING WELL: FRANK SINGLETON


WELL DRILLER'S LICENSE NUMBER: WRO 046

CIRCLE: MWD / MSD / MGD

* OWNER'S NAME: MARSHALL DAUBERMAN

SITE LOCATION MAP

* WELL LOCATION:
COUNTY: Howard
NEAREST TOWN: HIGHLAND
TAX MAP _____ BLOCK _____ PARCEL _____
SUBDIVISION: _____
SECTION: _____ LOT: _____
STREET ADDRESS: 14015 Clarksburg Pike

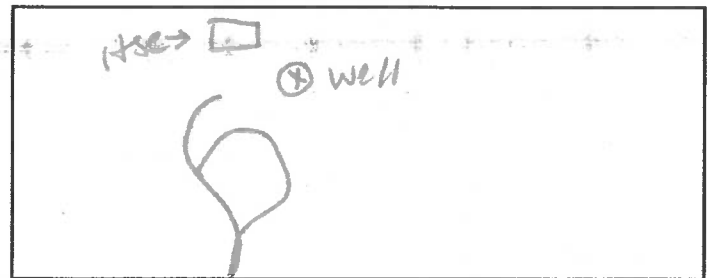

LATITUDE 3 9.159864

LONGITUDE 7 6.956486

LOG OF SEALING MATERIAL

* TYPE OF WELL BEING ABANDONED:
 DRILLED JETTED
 BORED HAND DUG
 OTHER (specify) _____

MATERIAL	FEET	
	FROM	TO
Bentonite	280	1
DIRT	1	0

* USE CODE:
 DOMESTIC MUNICIPAL/PUBLIC
 IRRIGATION INDUSTRIAL
 TEST/OBSERVATION GEOTHERMAL

VOLUME OF MATERIAL USED
900 # mixed AS slurry

* TYPE OF CASING:
 STEEL PLASTIC
 CONCRETE OTHER (specify) _____

SIZE OF CASING: 6 INCHES IN DIAMETER

DEPTH OF WELL: 280 FEET DEEP

WAS ANY CASING REMOVED? YES NO

If yes, length removed, in feet: 242

WAS CASING RIPPED OR PERFORATED? YES NO

George F. Eastman
SIGNATURE-MASTER WELL DRILLER OR SUPERVISING SANITARIAN LICENSE# 040

MWD / MSD / MGS
CIRCLE ONE

5-19-21
DATE

COUNTY

Pursuant to § 10-624 of the State Govt. Article of the Maryland Code, personal info requested on this form is used in processing this form pursuant to COMAR 26.04.04. Failure to provide the info may result in this form not being processed. You have the right to inspect, amend, or correct this form. The Maryland Department of the Environment is subject to the Maryland Public Information Act. This form may be made available on the Internet via MDE's website and is subject to inspection or copying, in whole or in part, by the public and other governmental agencies, if not protected by federal or State Law.

Real Property Data Search (w2)

Search Result for HOWARD COUNTY

View Map	View GroundRent Redemption	View GroundRent Registration
Special Tax Recapture: None		
Account Identifier: District - 05 Account Number - 375312		
Owner Information		
Owner Name:	DAUBERMAN MARSHALL R & JANA L	Use: RESIDENTIAL Principal Residence: YES
Mailing Address:	14015 CLARKSVILLE PIKE HIGHLAND MD 20777-9526	Deed Reference: /00877/ 00494
Location & Structure Information		
Premises Address:	14015 CLARKSVILLE PIKE HIGHLAND 20777-0000	Legal Description: PAR 6 6.383A S 1 14015 CLARKSVILLE PIKE FOX HAVEN
Map: 0040	Grid: 0021	Parcel: 0445
Neighborhood: 5020201.14	Subdivision: 2001	Section:
Block:	Lot: PAR 6	Assessment Year: 2020
Plat No:	Plat Ref:	
Town: None		
Primary Structure Built 1979	Above Grade Living Area 2,720 SF	Finished Basement Area 560 SF
		Property Land Area 6.3800 AC
County Use		
Stories	Basement	Type
2	YES	STANDARD UNIT
Exterior	Quality	Full/Half Bath
1/2 BRICK FRAME/	4	3 full
Garage	Last Notice of Major Improvements	
2 Attached		
Value Information		
	Base Value	Value
		As of 01/01/2020
Land:	387,800	412,800
Improvements	299,400	318,200
Total:	687,200	731,000
Preferential Land:	0	0
		Phase-in Assessments
		As of 07/01/2021
		As of 07/01/2022
		716,400
		731,000
Transfer Information		
Seller:	Date:	Price:
Type:	Deed1:	Deed2:
Seller:	Date:	Price:
Type:	Deed1:	Deed2:
Seller:	Date:	Price:
Type:	Deed1:	Deed2:
Exemption Information		
Partial Exempt Assessments:	Class	
County:	000	07/01/2021
State:	000	0.00
Municipal:	000	0.00
		0.00 0.00
Special Tax Recapture: None		
Homestead Application Information		
Homestead Application Status: Approved 10/28/2008		
Homeowners' Tax Credit Application Information		
Homeowners' Tax Credit Application Status: No Application		
Date:		