

PRELIMINARY

APPLICATION

A 25799

P _____

SEWAGE DISPOSAL TESTING

STATE OF MARYLAND - DEPARTMENT OF HEALTH AND MENTAL HYGIENE

HOWARD COUNTY HEALTH DEPARTMENT
ENVIRONMENTAL HEALTH SERVICES
P O BOX 476, ELLICOTT CITY, MARYLAND 21043
TELEPHONE: 465-5000, EXT. 356

ST.
3 - 1000
4 - 1250

DISTRICT 5th

DATE 5/6/77

Locate the D.W. 48' from the 366' prop line and 160' from the 312' prop line. The in. will enter the D.W. @ 2' below o.c. with the max depth of the D.W. not to exceed 10' below o.c. If a trench is to be used, begin the trench 5' from the edge of the D.W. & follow the contour of the land. The trench will be 2' wide, 10' deep and contain 7' of stone. There will be no less than 125# of sidewall area/BR in this system.

*1 June 77
RM*

TO: THE COUNTY HEALTH OFFICER
ELLICOTT CITY, MARYLAND

if trench used, 2 inspections required

I, HEREBY, APPLY FOR THE NECESSARY TEST IN ORDER TO CONSTRUCT (OR RECONSTRUCT) A SEWAGE DISPOSAL SYSTEM.

Mark Kovach

PROPERTY OWNER Glenelg Manor Farm - Dale Maisel

ADDRESS 12789 Folly Quarter Road, Ellicott City, Md. PHONE _____

PROPERTY LOCATION

SUBDIVISION Glenelg Manor LOT NO. (*) 2

ROAD AND DESCRIPTION Folly Quarter Road

SIZE OF LOT (*) 5.004 acres TYPE BLDG. 3 or 4 bedrooms
NUMBER OF BEDROOMS

IF NOT SINGLE RESIDENCE DESCRIBE _____

THE SYSTEM INSTALLED UNDER THIS APPLICATION IS ACCEPTABLE ONLY UNTIL PUBLIC FACILITIES BECOME AVAILABLE.

SIGNATURE OF APPLICANT /s/ John Rettaliata

APPROVED BY R. Mansfield FOR D.W. & Trench DATE 31 May 77
(KIND OF SYSTEM)

REJECTED BY _____ FOR _____ DATE _____
(KIND OF SYSTEM)

HOLD PENDING FURTHER TESTS _____ DATE _____


REASONS FOR REJECTION OR HOLDING _____

BLDG. PERM. _____
AND RETURNED 9/14/84
60954 For S.F.D.

THIS IS NOT A PERMIT

NOTE: THE LOT SHOWN HEREON COMPLIES WITH THE MINIMUM OWNERSHIP WIDTH AND LOT AREAS AS REQUIRED BY THE MARYLAND STATE DEPARTMENT OF HEALTH AND MENTAL HYGIENE.

NOTE : PERCOLATION TEST HOLES SHOWN HEREON HAVE BEEN FIELD LOCATED.

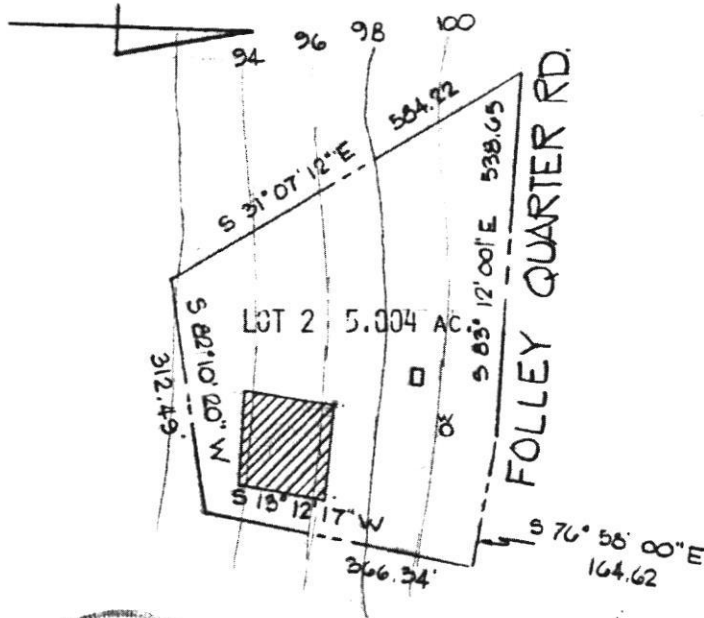

5-9-77

APPROVED: FOR PRIVATE WATER AND PRIVATE SEWAGE SYSTEMS.

HOWARD COUNTY HEALTH DEPARTMENT

Joseph M. Boyles 6-1-77
 COUNTY HEALTH OFFICER DATE

TITLE PERCOLATION TEST PLAT LOT 2				ENGINEERING PLANNING SURVEYING BY BOENDER ASSOCIATES INC. ELLICOTT CITY, MD. 21043 SALISBURY, MD. 21801 301-465-7777
PROJECT GLENELG HANOR SECTION 1				
LOCATION 5TH ELECTION DISTRICT, HOWARD COUNTY, MARYLAND				
DATE MAY 4 1977	DES BY --	DRAWN BY JB	CHKD BY JAB	
SCALE 1" = 200'	JOB NO. 7776-4	DRWG. NO.: 1 OF 1		