


REVISED
 Date: 3-20-15
 Comments: Finish basement
 #B15000012

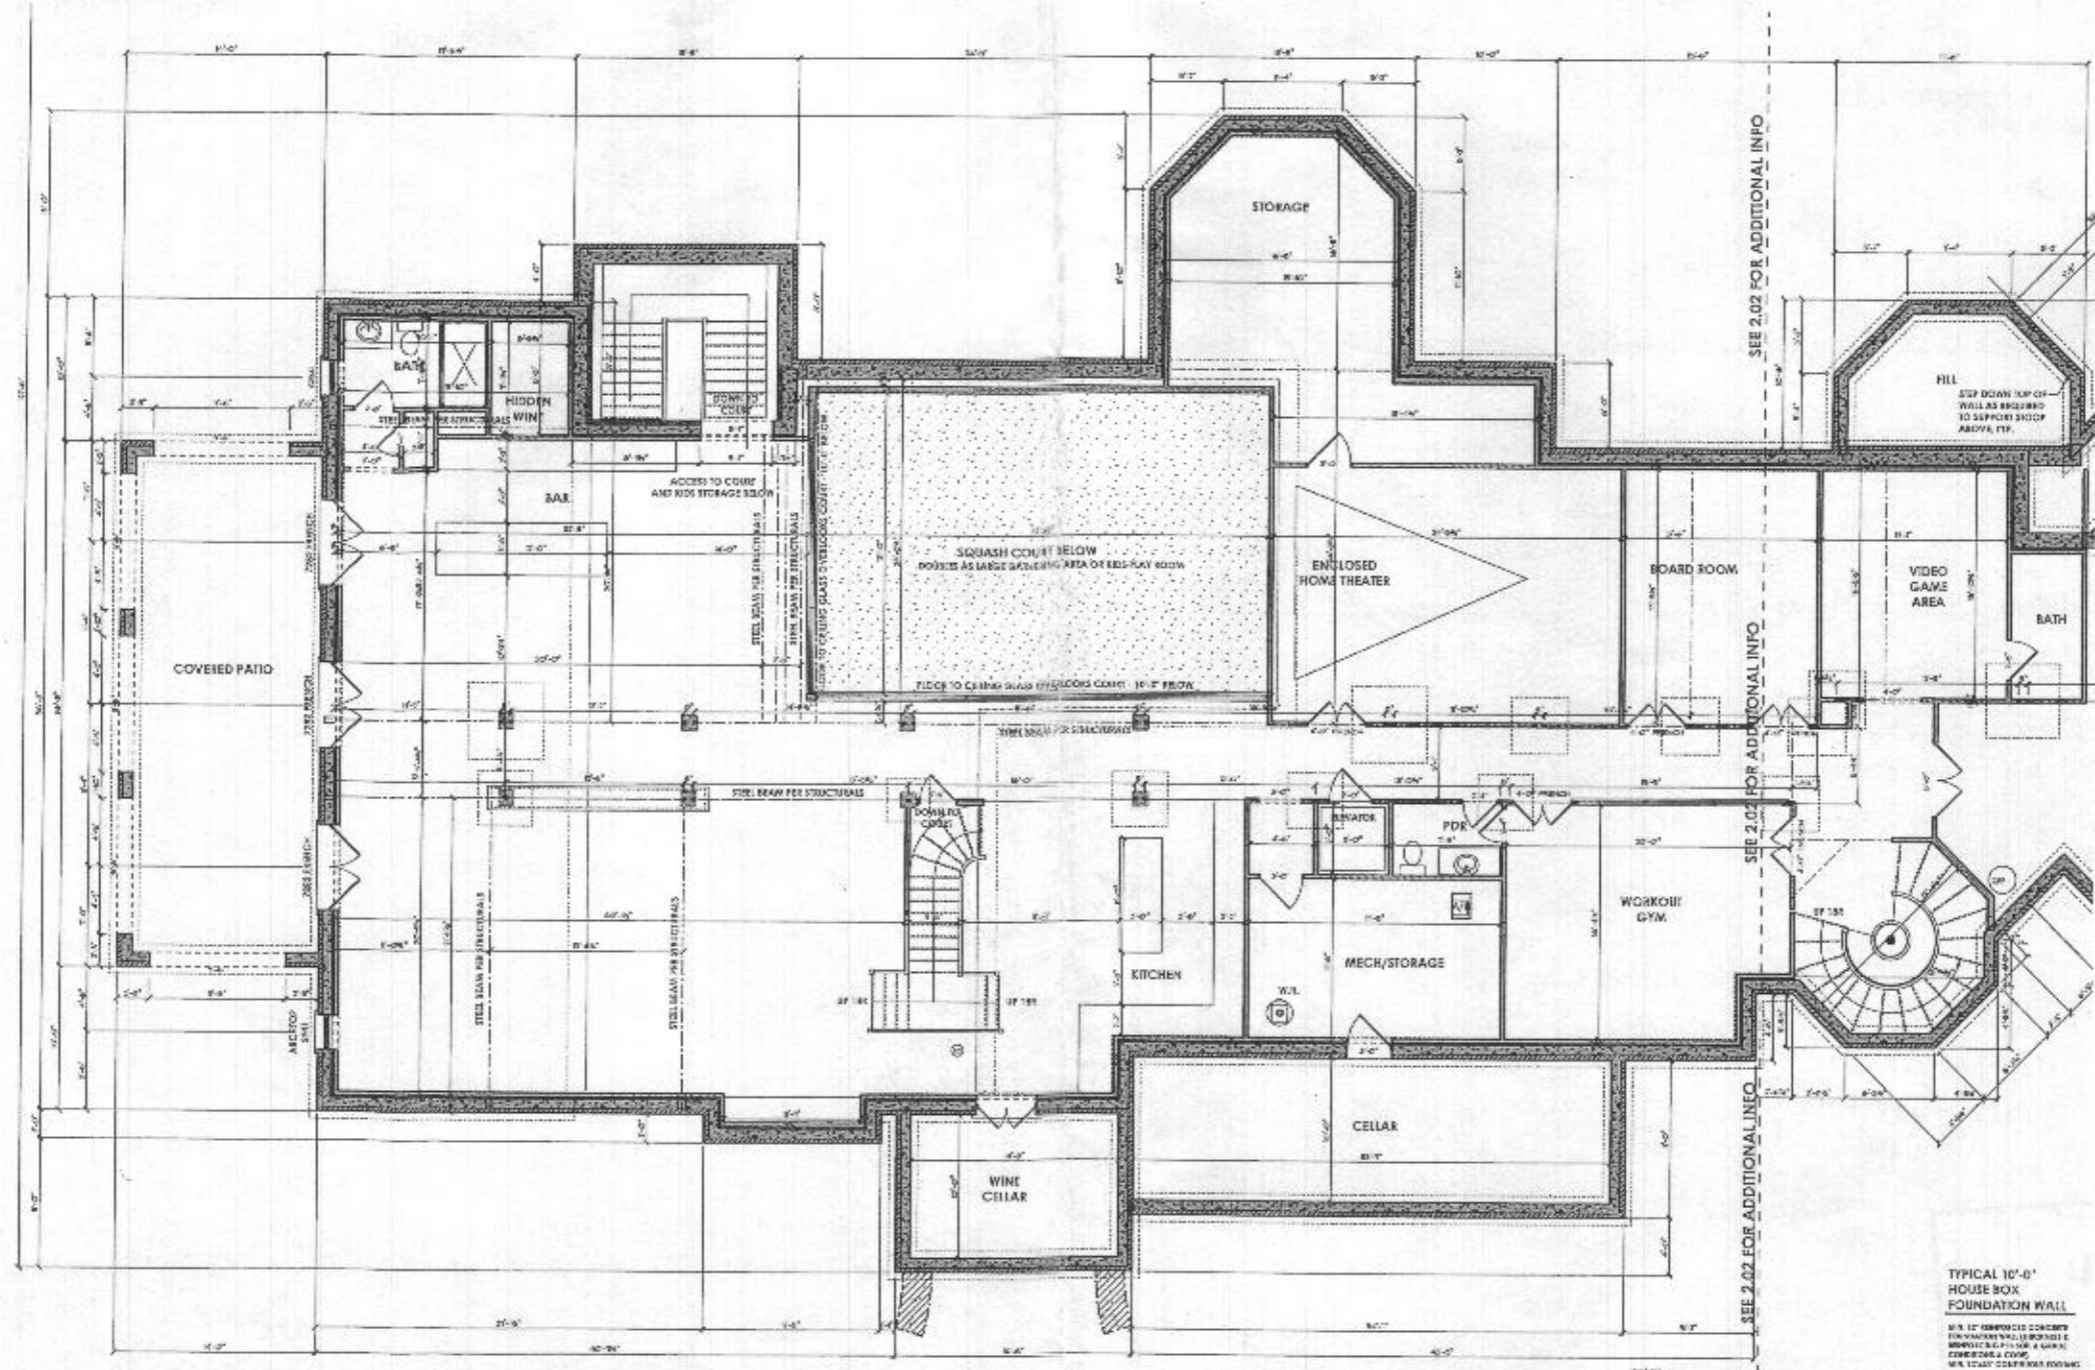

Finished area 5561 sq ft
 6-833 S.J.

SEE 2.02 FOR ADDITIONAL INFO

FOUNDATION NOTES

1. FOUNDATION WALLS SHALL BE CONCRETE ON GRADE.
2. FOUNDATION WALLS SHALL BE 12" THICK UNLESS OTHERWISE NOTED.
3. FOUNDATION WALLS SHALL BE FINISHED WITH 1/2" GYPSUM BOARD.
4. FOUNDATION WALLS SHALL BE FINISHED WITH 1/2" GYPSUM BOARD AND 1/2" POLYURETHANE FOAM INSULATION.
5. FOUNDATION WALLS SHALL BE FINISHED WITH 1/2" GYPSUM BOARD AND 1/2" POLYURETHANE FOAM INSULATION.
6. FOUNDATION WALLS SHALL BE FINISHED WITH 1/2" GYPSUM BOARD AND 1/2" POLYURETHANE FOAM INSULATION.
7. FOUNDATION WALLS SHALL BE FINISHED WITH 1/2" GYPSUM BOARD AND 1/2" POLYURETHANE FOAM INSULATION.
8. FOUNDATION WALLS SHALL BE FINISHED WITH 1/2" GYPSUM BOARD AND 1/2" POLYURETHANE FOAM INSULATION.
9. FOUNDATION WALLS SHALL BE FINISHED WITH 1/2" GYPSUM BOARD AND 1/2" POLYURETHANE FOAM INSULATION.
10. FOUNDATION WALLS SHALL BE FINISHED WITH 1/2" GYPSUM BOARD AND 1/2" POLYURETHANE FOAM INSULATION.

TYPICAL 10'-0" HOUSE BOX FOUNDATION WALL

1. 12" THICK CONCRETE ON GRADE.

2. 1/2" POLYURETHANE FOAM INSULATION.

3. 1/2" GYPSUM BOARD.

4. 1/2" POLYURETHANE FOAM INSULATION.

5. 1/2" GYPSUM BOARD.

100. 1/2" POLYURETHANE FOAM INSULATION.

TYPICAL GARAGE FOUNDATION WALL

1. 12" THICK CONCRETE ON GRADE.

2. 1/2" POLYURETHANE FOAM INSULATION.

3. 1/2" GYPSUM BOARD.

4. 1/2" POLYURETHANE FOAM INSULATION.

5. 1/2" GYPSUM BOARD.


96. 1/2" POLYURETHANE FOAM INSULATION.

97. 1/2" GYPSUM BOARD.

98. 1/2" POLYURETHANE FOAM INSULATION.

99. 1/2" GYPSUM BOARD.

100. 1/2" POLYURETHANE FOAM INSULATION.

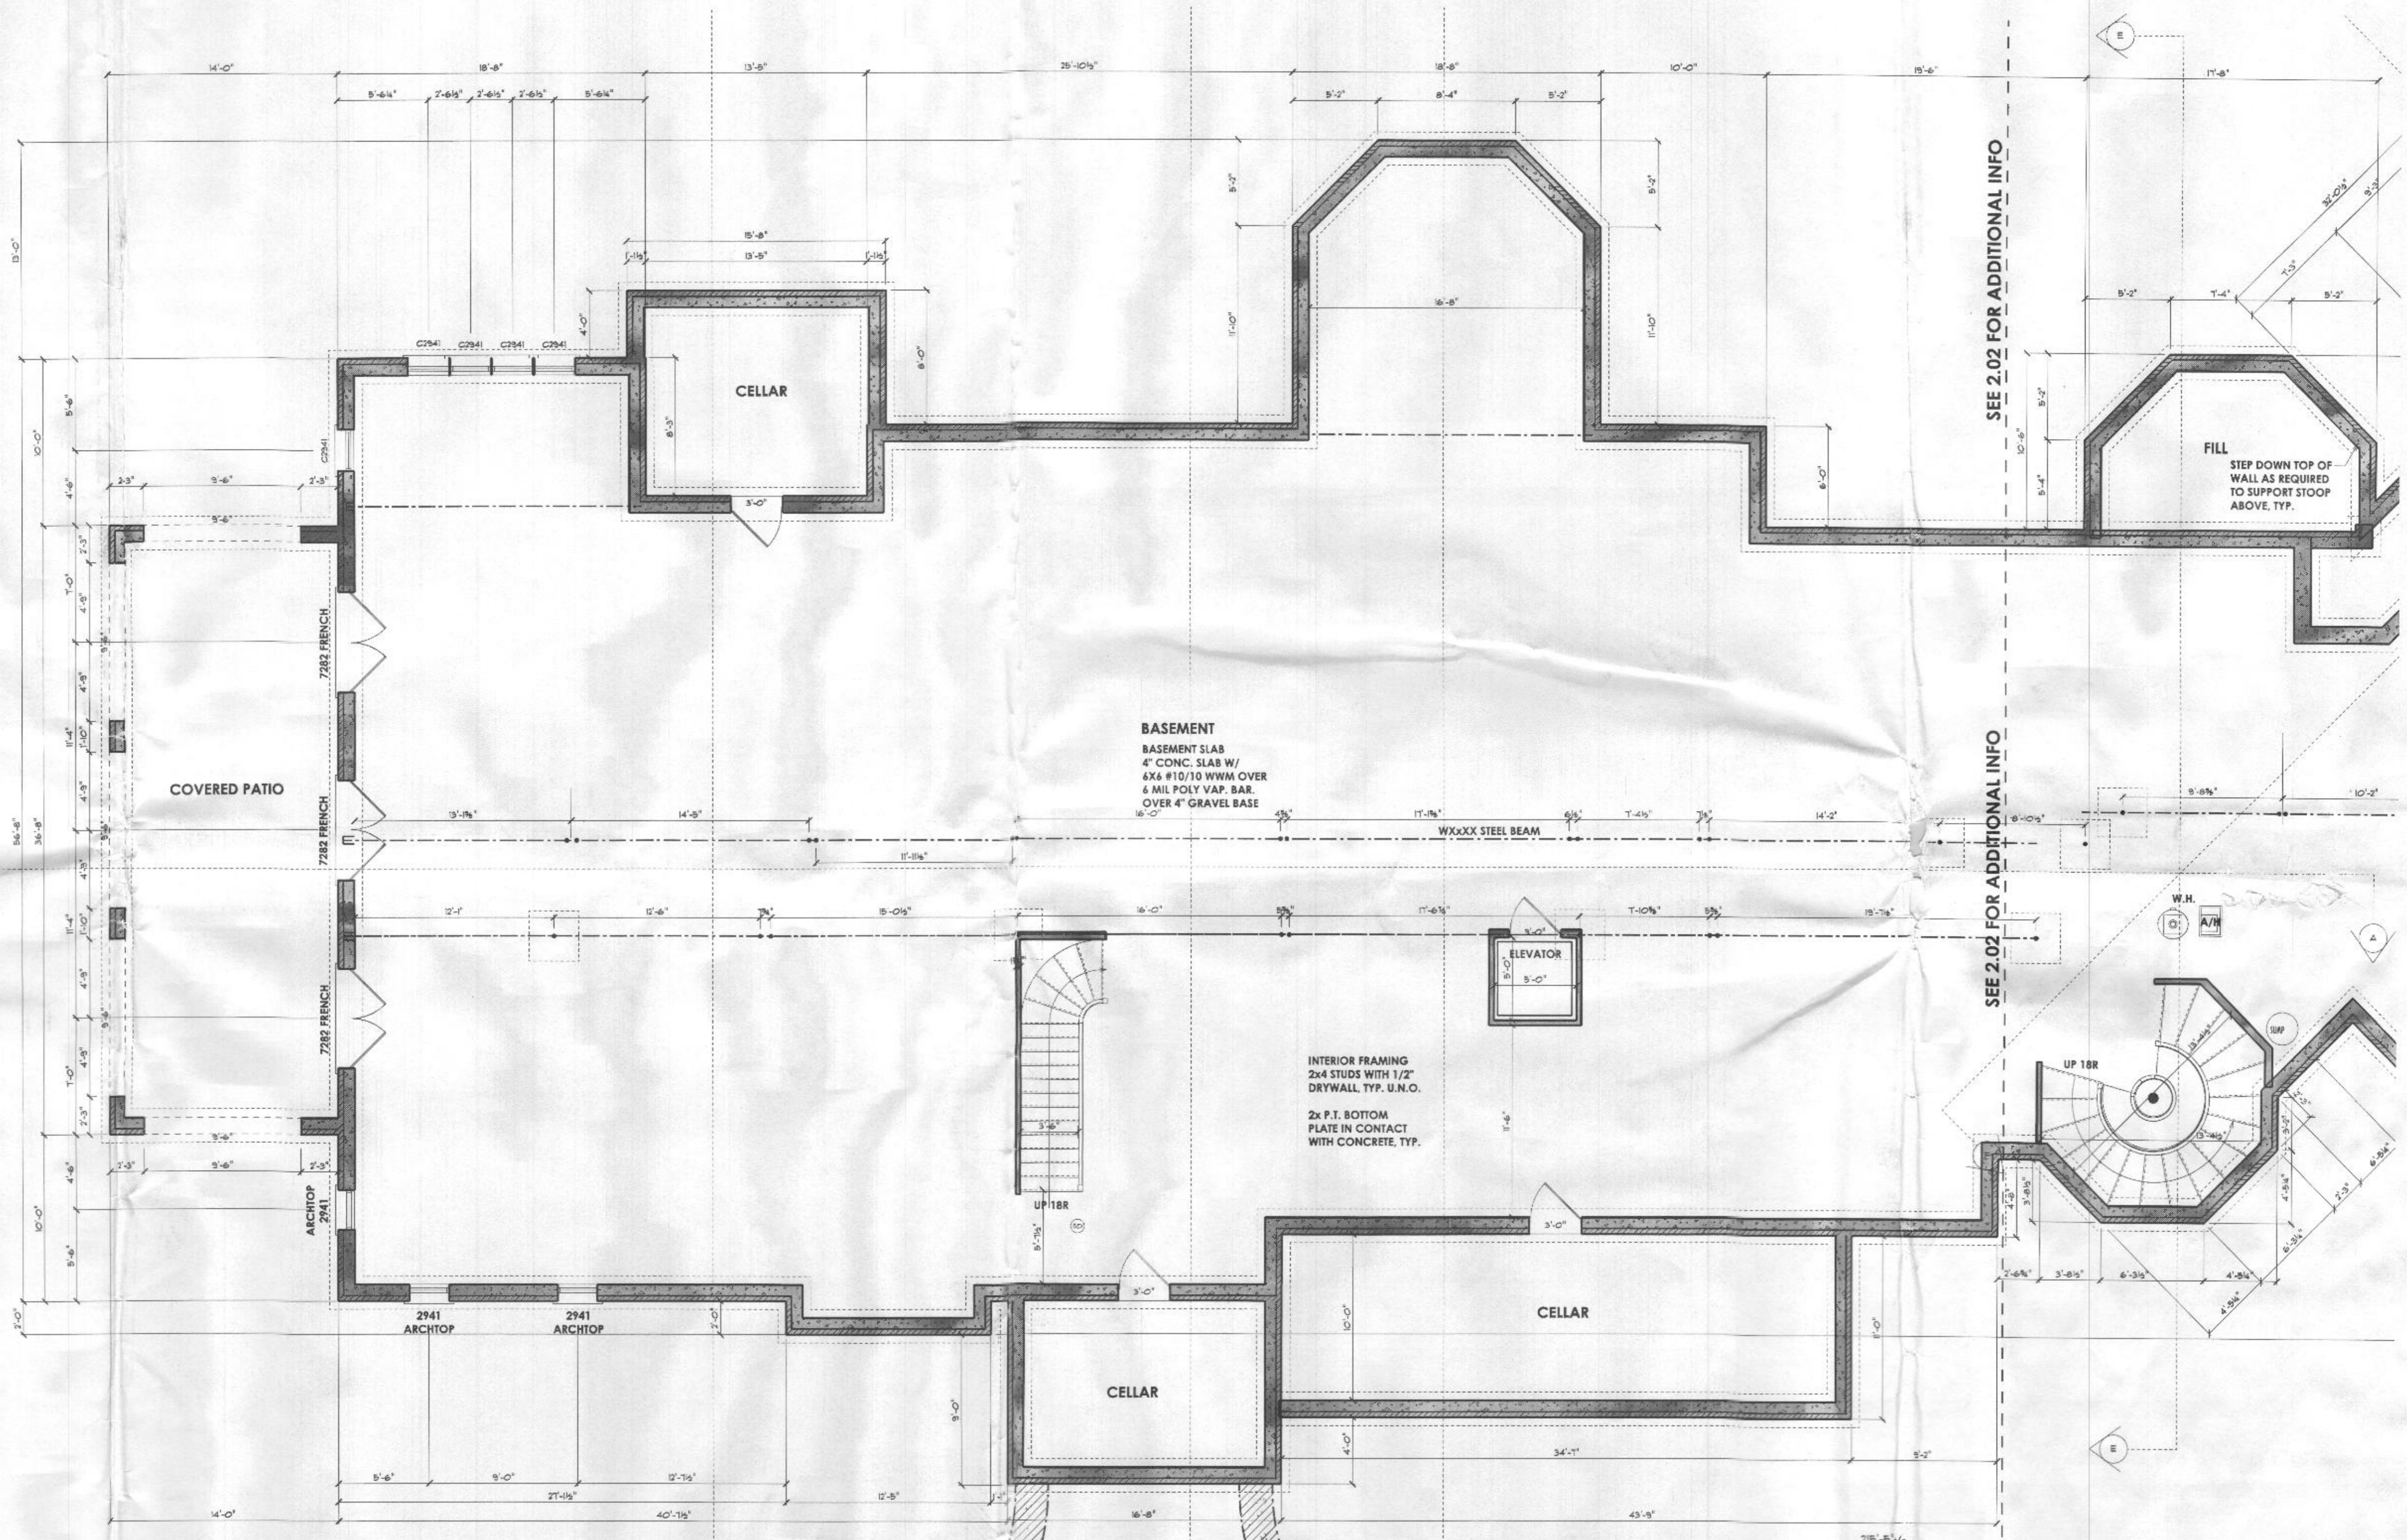

BASEMENT
 BASEMENT SLAB
 4" CONC. SLAB W/
 4X4 #10 TO W/M OVER
 6 MIL POLY VAP. BAR.
 OVER 4" GRAVEL BASE

INTERIOR FRAMING
 2x4 STUDS WITH 1/2"
 DRYWALL TYP. U.N.O.
 2x P.T. BOTTOM
 PLATE IN CONTACT
 WITH CONCRETE TYP.

6,533 s.f.

**TYPICAL 10'-0"
 HOUSE BOX
 FOUNDATION WALL**

MIN. 12" REINFORCED CONCRETE
 FOUNDATION WALL (THICKNESS &
 REINFORCING PER SOIL & GRADE
 CONDITIONS & CODE)
 MIN. 12"x24" CONTINUOUS FOOTING

**TYPICAL GARAGE
 FOUNDATION WALL**
 MIN. 12" REINFORCED CONCRETE
 FOUNDATION WALL (THICKNESS &
 REINFORCING PER SOIL & GRADE
 CONDITIONS & CODE)
 MIN. 12"x24" CONTINUOUS FOOTING

FOUNDATION NOTES

- 1) 2000 PSF MIN SOIL BEARING CAPACITY ASSUMED
- 2) BEAMS, JOISTS, HEADERS & RAFTERS TO BE SPP #1/#2 OR EQ. TYP THROUGHOUT U.N.O.
- 3) BASEMENT WINDOW AND DOOR LOCATIONS TO BE DETERMINED AT PRECON.
- 4) ALL LOCATIONS FOR HVAC, SUMP PUMPS, ROUGH-INS, H/W/H, A/H AND OTHER FEATURES ARE SUBJECT TO BUILDER DISCRETION ON SITE
- 5) FOUNDATION WALL MIN. THICKNESS 8" OR 10" WHERE STEMWALL AT BRICK EDGE EXCEEDS 12" HIGH
- 6) VERIFY SIZE AND LOCATION OF WINDOWS PER GRADE & BUILDER
- 7) MIN. 1/2" HOOKED ANCHOR BOLTS EMBEDDED A MIN. 7" INTO CONC. SHALL BE SPACED @ 4'-0" O.C. AND LOCATED 4" FROM EACH END OF ALL SILL PLATE PIECES.
- 8) REFER TO WALL SECTIONS FOR FOUNDATION WALL DETAILS.

SEE 2.02 FOR ADDITIONAL INFO


SEE 2.02 FOR ADDITIONAL INFO

SEE 2.02 FOR ADDITIONAL INFO

REVISIONS

05-23-13	SHEDDER REVIEW
10-29-13	STRUCTURAL REVIEW
11-20-13	PERMIT REVIEW
12-13-13	REVISION

RECEIVED
 FEB 20 2015
 HOWARD COUNTY HEALTH DEPT.
 BUREAU OF ENVIRONMENTAL HEALTH

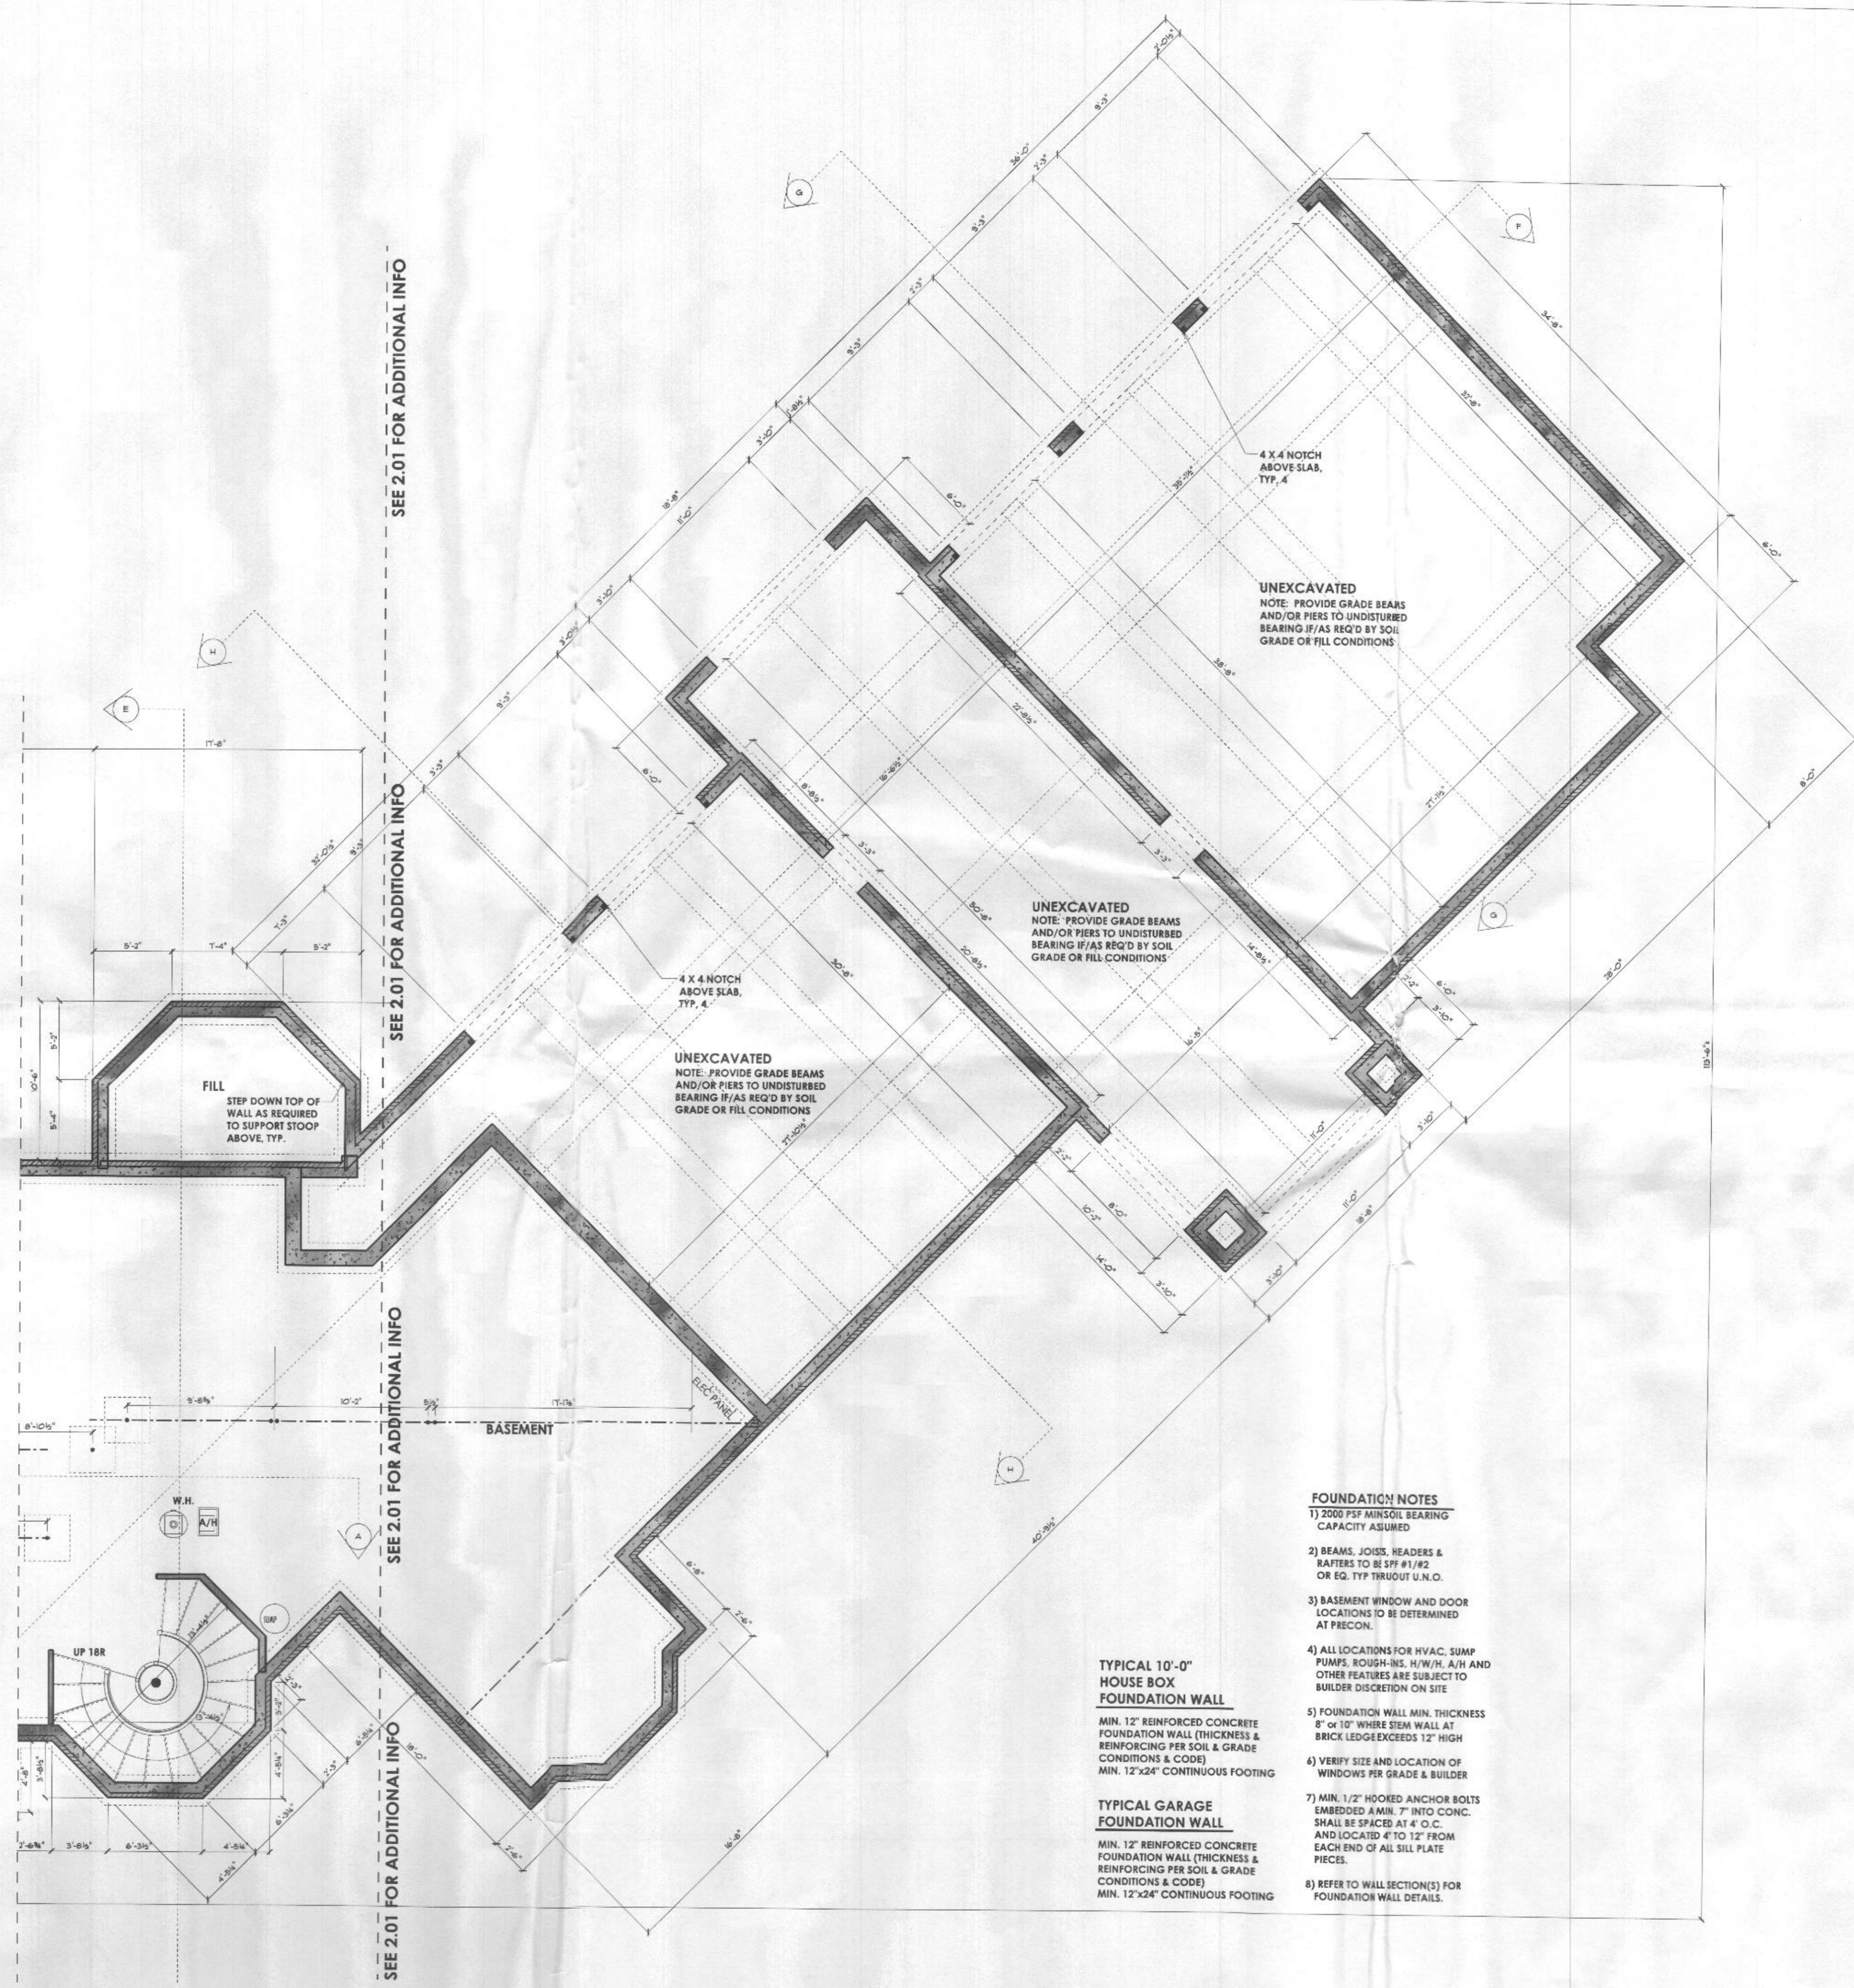

- FOUNDATION NOTES**
- 1) 2000 PPF MIN. SOIL BEARING CAPACITY ASSUMED
 - 2) BEAMS, JOISTS, HEADERS & RAFTERS TO BE SFF #1 #2 OR EQ. TYP. THROUGH U.N.O.
 - 3) BASEMENT WINDOW AND DOOR LOCATIONS TO BE DETERMINED AT PRECON.
 - 4) ALL LOCATIONS FOR HVAC, SUMP PUMPS, ROUGH-INS, H/W/H, A/H AND OTHER FEATURES ARE SUBJECT TO BUILDER DISCRETION ON SITE
 - 5) FOUNDATION WALL MIN. THICKNESS 8" OR 10" WHERE STEM WALL AT BRICK LEDGE EXCEEDS 12" HIGH
 - 6) VERIFY SIZE AND LOCATION OF WINDOWS PER GRADE & BUILDER
 - 7) MIN. 1/2" HOOKED ANCHOR BOLTS EMBEDDED A MIN. 7" INTO CONC. SHALL BE SPACED AT 4' O.C. AND LOCATED 4" TO 12" FROM EACH END OF ALL SILL PLATE PIECES.
 - 8) REFER TO WALL SECTION(S) FOR FOUNDATION WALL DETAILS.

TYPICAL 10'-0" HOUSE BOX FOUNDATION WALL
 MIN. 12" REINFORCED CONCRETE FOUNDATION WALL (THICKNESS & REINFORCING PER SOIL & GRADE CONDITIONS & CODE)
 MIN. 12"x24" CONTINUOUS FOOTING

TYPICAL GARAGE FOUNDATION WALL
 MIN. 12" REINFORCED CONCRETE FOUNDATION WALL (THICKNESS & REINFORCING PER SOIL & GRADE CONDITIONS & CODE)
 MIN. 12"x24" CONTINUOUS FOOTING



CONTACT:
 David Sadler
 (301)-974-4899
 www.stirlinghd.com

REVISIONS

1	09-23-13	SHELTER REVIEW
2	10-26-13	STRUCTURAL REVIEW
3	11-20-13	PERMIT REVIEW
4	12-12-13	REVISION

Rao Residence

PROPOSED RESIDENCE
 Clay Circle, Clarksville, Maryland


DETAILS MATTER.
 Member of American Institute of Architects
 NCARB Certified

PROFESSIONAL CERTIFICATION
 I certify that these documents were prepared or approved by me, and that I am a duly licensed professional architect under the laws of the State of Maryland, License Number #14478 Expiration Date: 6/30/2016.

JONATHAN RIVERA ARCHITECT
 443.226.5745
 jonathanrivera.com

SCALE: 1/4" = 1'-0"
 PROJECT NO: WALNUT GROVE-02
 ISSUE DATES: 04-21-14
 PRELIM SET


FOUNDATION 2.02
 PRINT DATE: December 22, 2014

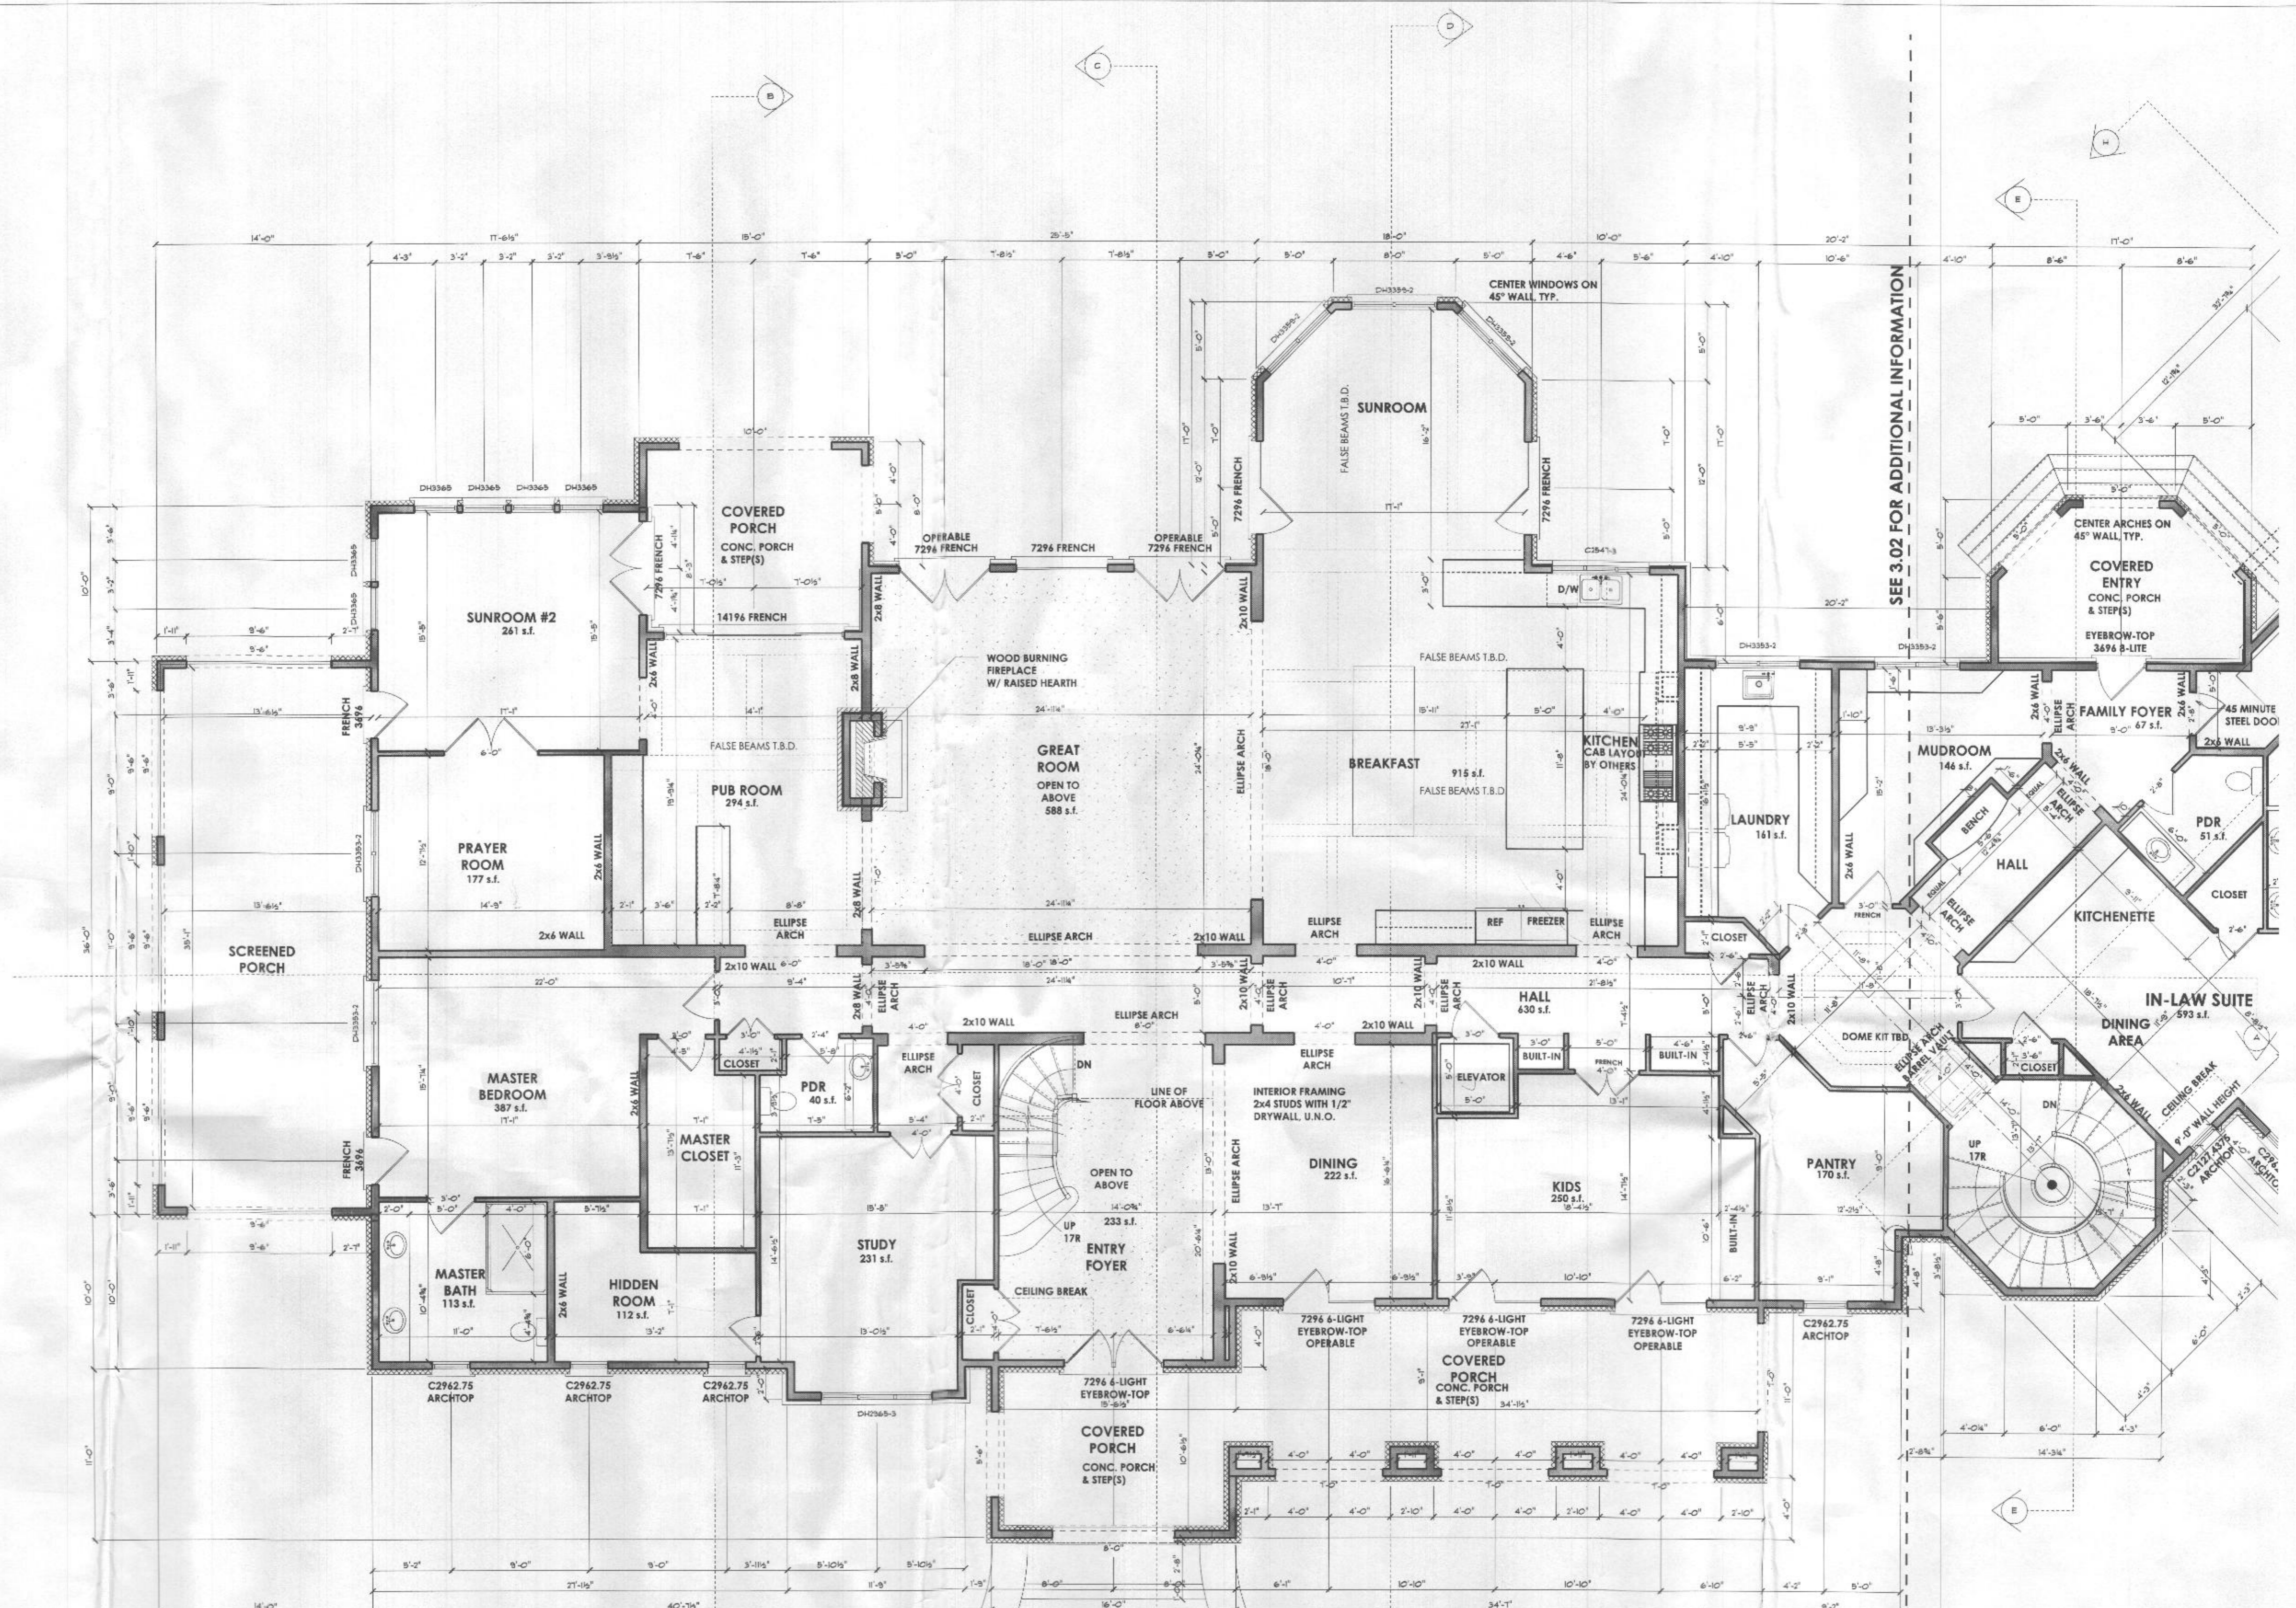

TYPICAL HOUSE BOX - 2x6 EXTERIOR WALL
 TYPICAL METHOD OF WALL CONSTRUCTION - 8602.10.5
 CONTINUOUSLY SHEATHED - WOOD STRUCTURAL PANEL

FINISHED - 6,860 s.f.
 GARAGE - 2282 s.f.

STUCCO AND STONE

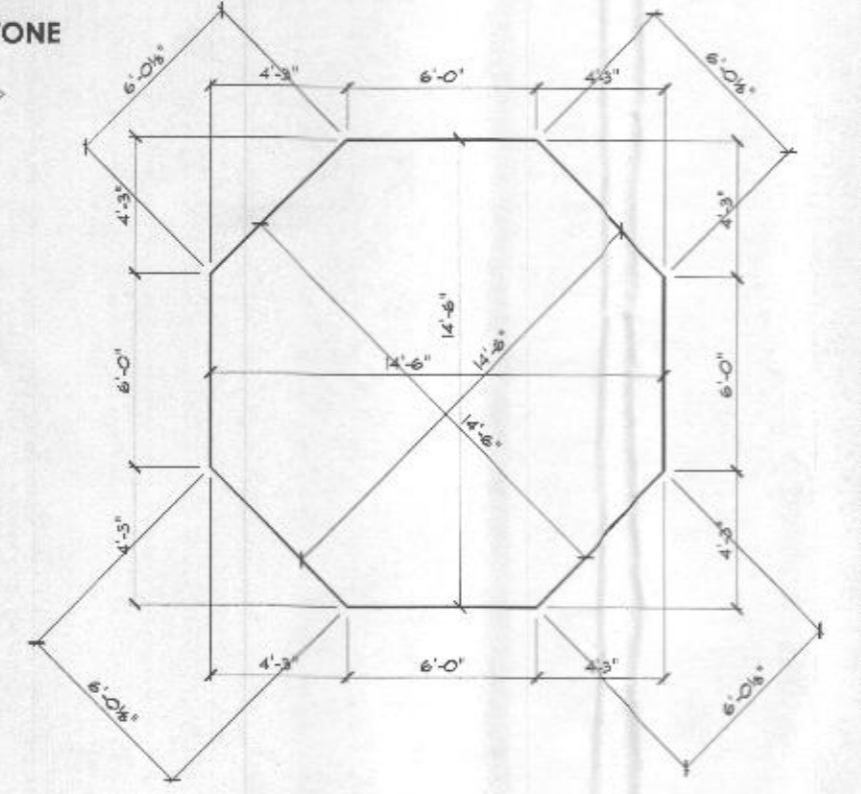


SEE 3.02 FOR ADDITIONAL INFORMATION

SEE 3.02 FOR ADDITIONAL INFORMATION

REVISIONS	
05-25-13	SHELTER REVIEW
10-26-13	STRUCTURAL REVIEW
11-06-13	PERMIT REVIEW
12-13-13	REVISION

RECEIVED
 FEB 20 2015
 HOWARD COUNTY HEALTH DEPT.
 BUREAU OF ENVIRONMENTAL HEALTH

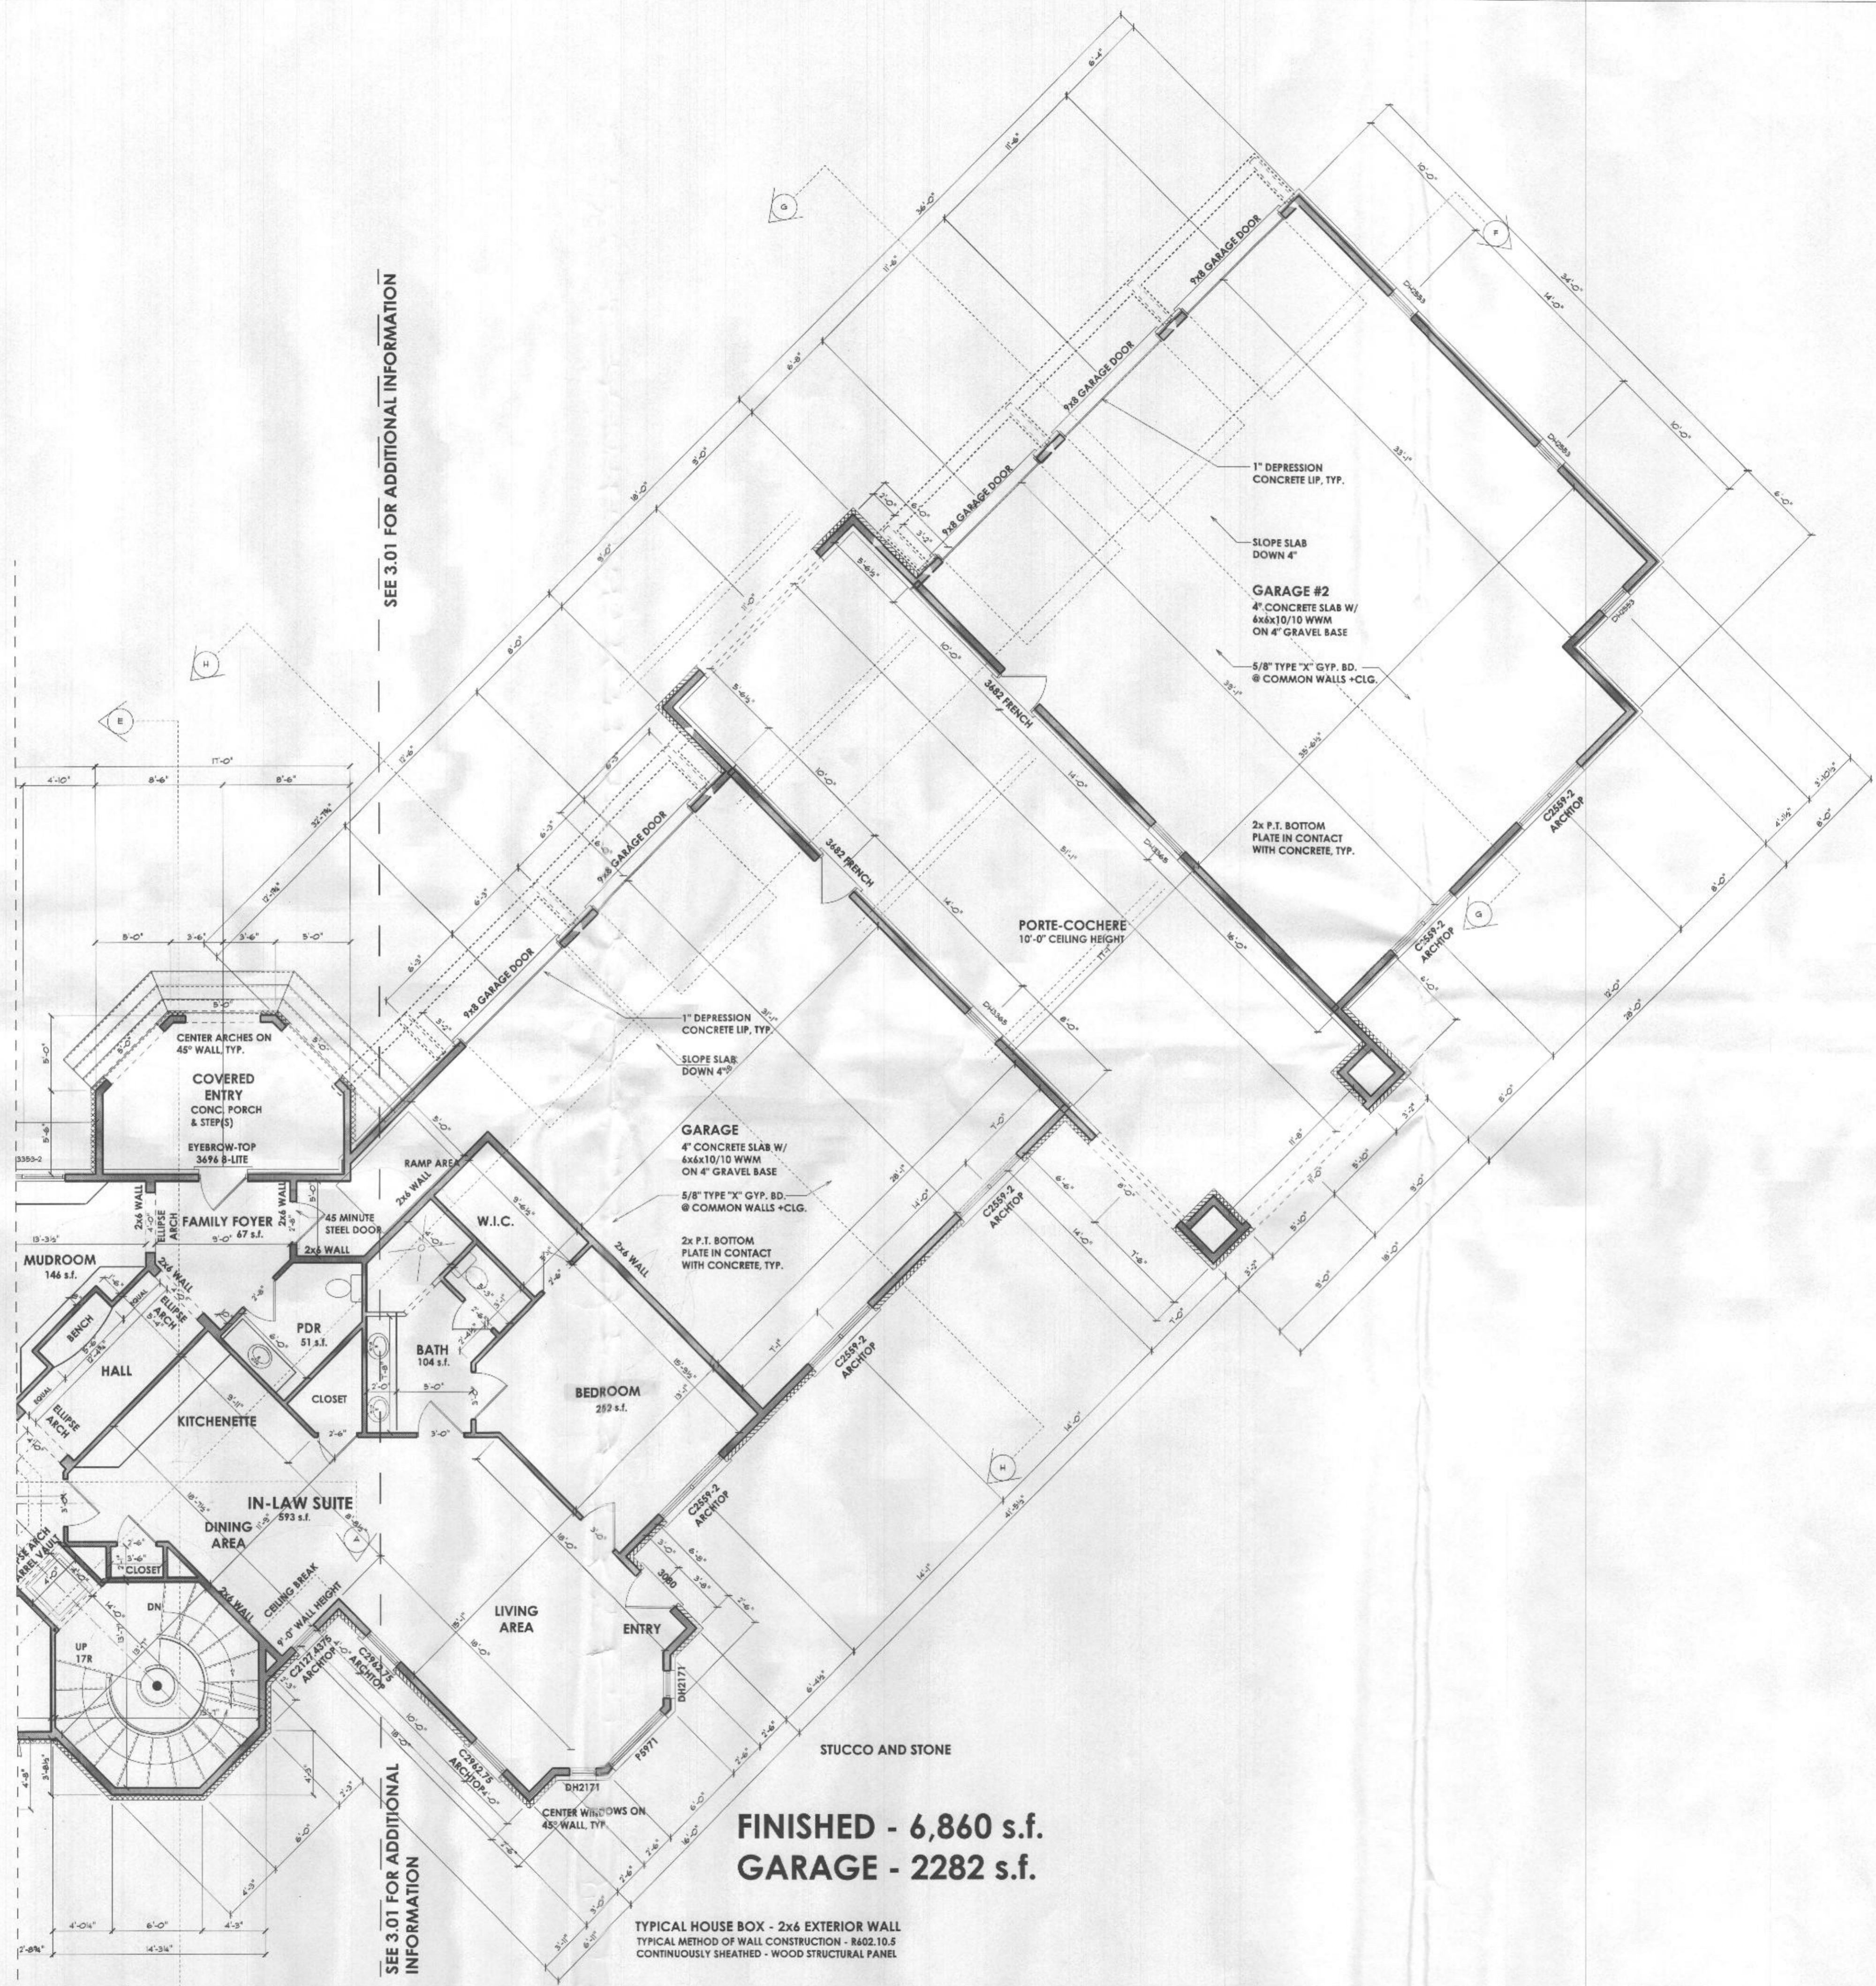

SEE 3.01 FOR ADDITIONAL INFORMATION

SEE 3.01 FOR ADDITIONAL INFORMATION

FINISHED - 6,860 s.f.
GARAGE - 2282 s.f.

TYPICAL HOUSE BOX - 2x6 EXTERIOR WALL
 TYPICAL METHOD OF WALL CONSTRUCTION - R602.10.5
 CONTINUOUSLY SHEATHED - WOOD STRUCTURAL PANEL

STIRLING HOMES
 CONTACT:
 David Sadler
 (301)-974-4899
 www.stirlinghd.com

REVISIONS	
05-22-12	SHELTER REVIEW
10-08-13	STRUCTURAL REVIEW
11-20-13	PERMIT REVIEW
12-15-13	REVISION

Rao Residence

PROPOSED RESIDENCE
 Clay Circle, Clarksville, Maryland

DETAILS MATTER.
 Member of American Institute of Architects
 NCARB Certified

PROFESSIONAL CERTIFICATION
 I certify that these documents
 were prepared or approved
 by me and that I am a duly
 licensed professional
 architect under the laws of the
 State of Maryland.
 License Number: #14678
 Expiration Date: 4/30/2016.

JONATHAN RIVERA ARCHITECT
 443.226.5743
 jonathanrivera.com

SCALE: 1/4" = 1'-0"
 PROJECT NO: WALNUT GROVE-02
 ISSUE DATES: 04-21-14 PRELIM SET
 ELEVATIONS
3.02
 PRINT DATE: December 22, 2014

