

Record Detail * (This section is required.)

Permit Type Building/Residential/Misc/Pool Spa **Permit Number** B22000840 **Opened Date** 03/14/2022
Description of Work
 SFD/ INSTALL A 40' X 20' INGROUND CONCRETE POOL, WITH FENCE TO CODE, DEPTH 3' TO 8', FILLED BY TRUCK

[check spelling](#)

Address * (This section is required.)

Street # 12606 **Street Name** FARMING **Street Type** DR
Unit Type --Select-- **Unit #** **X Coordinate** -76.95606 **Y Coordinate** 39.14907
City HIGHLAND **State** MD **Zip Code** 20777 **Primary** Yes

OK
5/18/22
RB

Parcel * (This section is required.)

GIS ID *	Parcel	Parcel Area	Land Value	Improved Value	Exemption Value	Plan Area
924570	13	3.87	246500	918100	671600	RURAL

Legal Description
 IMPSLOT 6 3.877 A[]12606 FARMING DRIVE[]J THOMPSON PROP RS PAR A

[check spelling](#)

Block	Lot	Census Tract	Council Dist	Inspection Dist	Supervisor Dist	Map #	DAP Zone
	6	605102	5				

Plan Area **State Tax Id** 1405447674 **Subdivision Name** J. Thompson Property
Section **Area** **Tax Map** 45
Grid 45-5 **Zoning District** RR-DEO **ADC Map** 5051-G7
SDP No. **Final Plan No.** F-07-024 **WP File No.**
Record Plat No. 19162-1916 **WS Contract No.** **FDP No.** **Primary** Yes
Owner Occupied Yes No **Year Built** 2010 **Historic District** Yes No
Historic District Registry No. **Stat Area** 5-15A **Flood Plain** Yes No
Building No

Owner * (This section is required.)

Name *
 CALIS KARIM ANTON
Address Line 1
 12606 FARMING DR
Address Line 2

Address Line 3


Mail City HIGHLAND **Mail State** MD **Mail Zip Code** 20777
Phone 301-490-1919 **Primary** Yes

E-mail

Cell Number **Fax Number**

Professionals (This section is not required.)

BROWNS BRIDGE ROAD
(PUSH COLLARED)

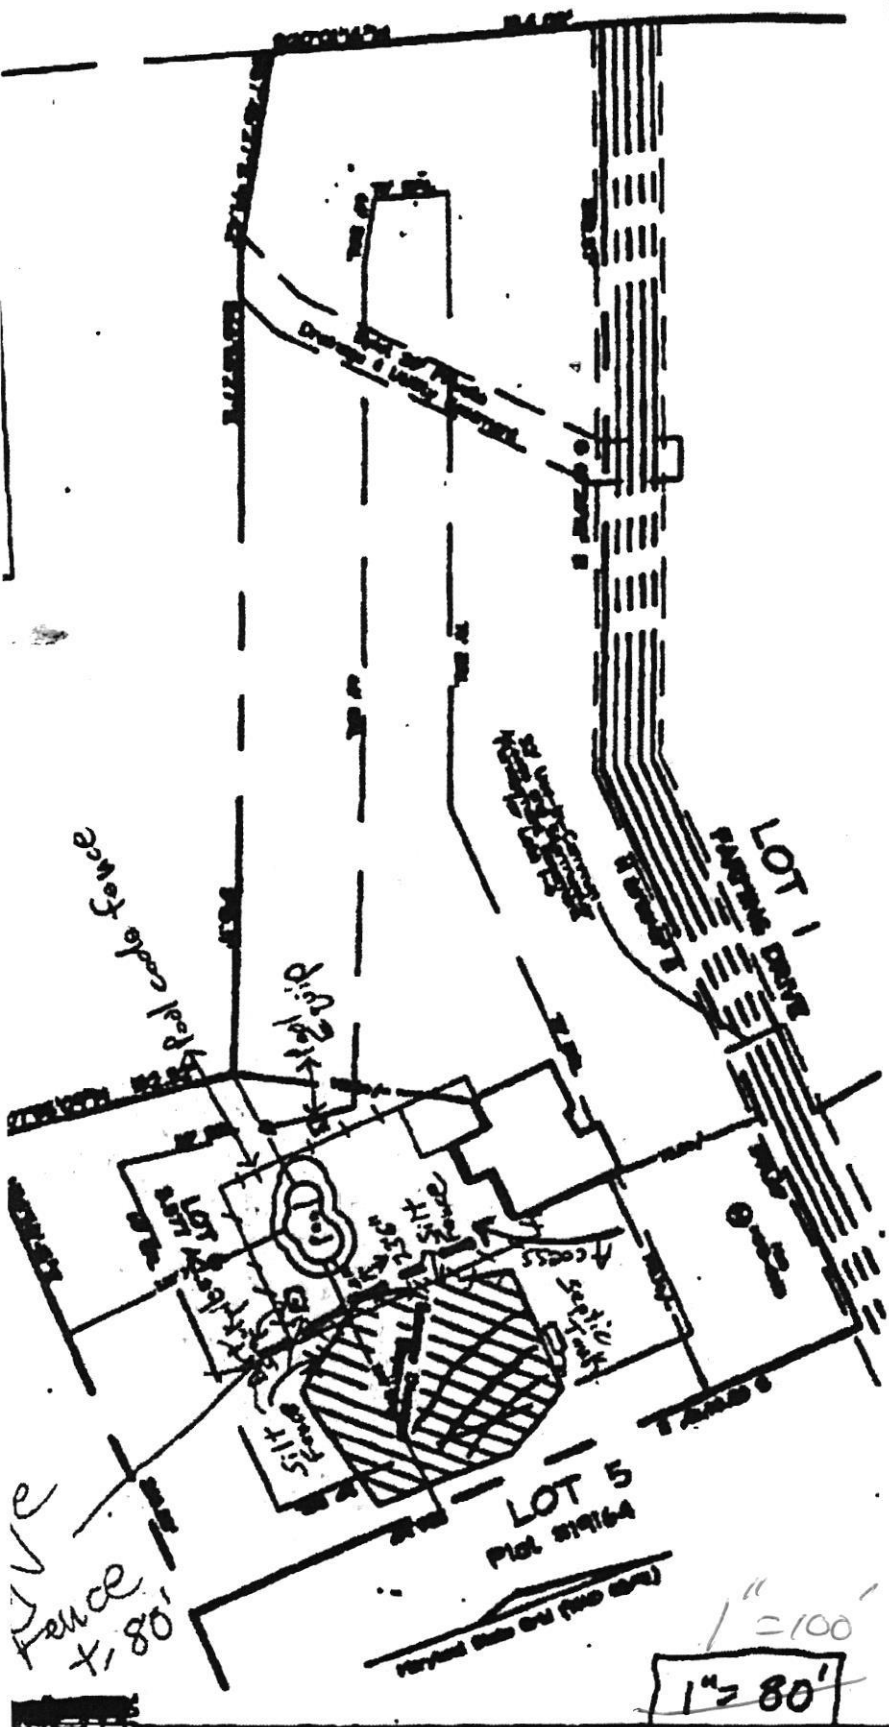

Area of Public System Plan
 Henry County Health Department
 20 K40 Inground Pool
 B22000840; 12606 Farming Lane
 Bricker 5/18/2022
 Date

DIMENSIONS FROM FOUR MALL TO PROPERTY LINE ARE +/- 0.5'
 ADDRESS No.: 12606 FARMING DRIVE
 TOP OF MALL ELEV. = 890.05